



A SECTION
39/41 1:10

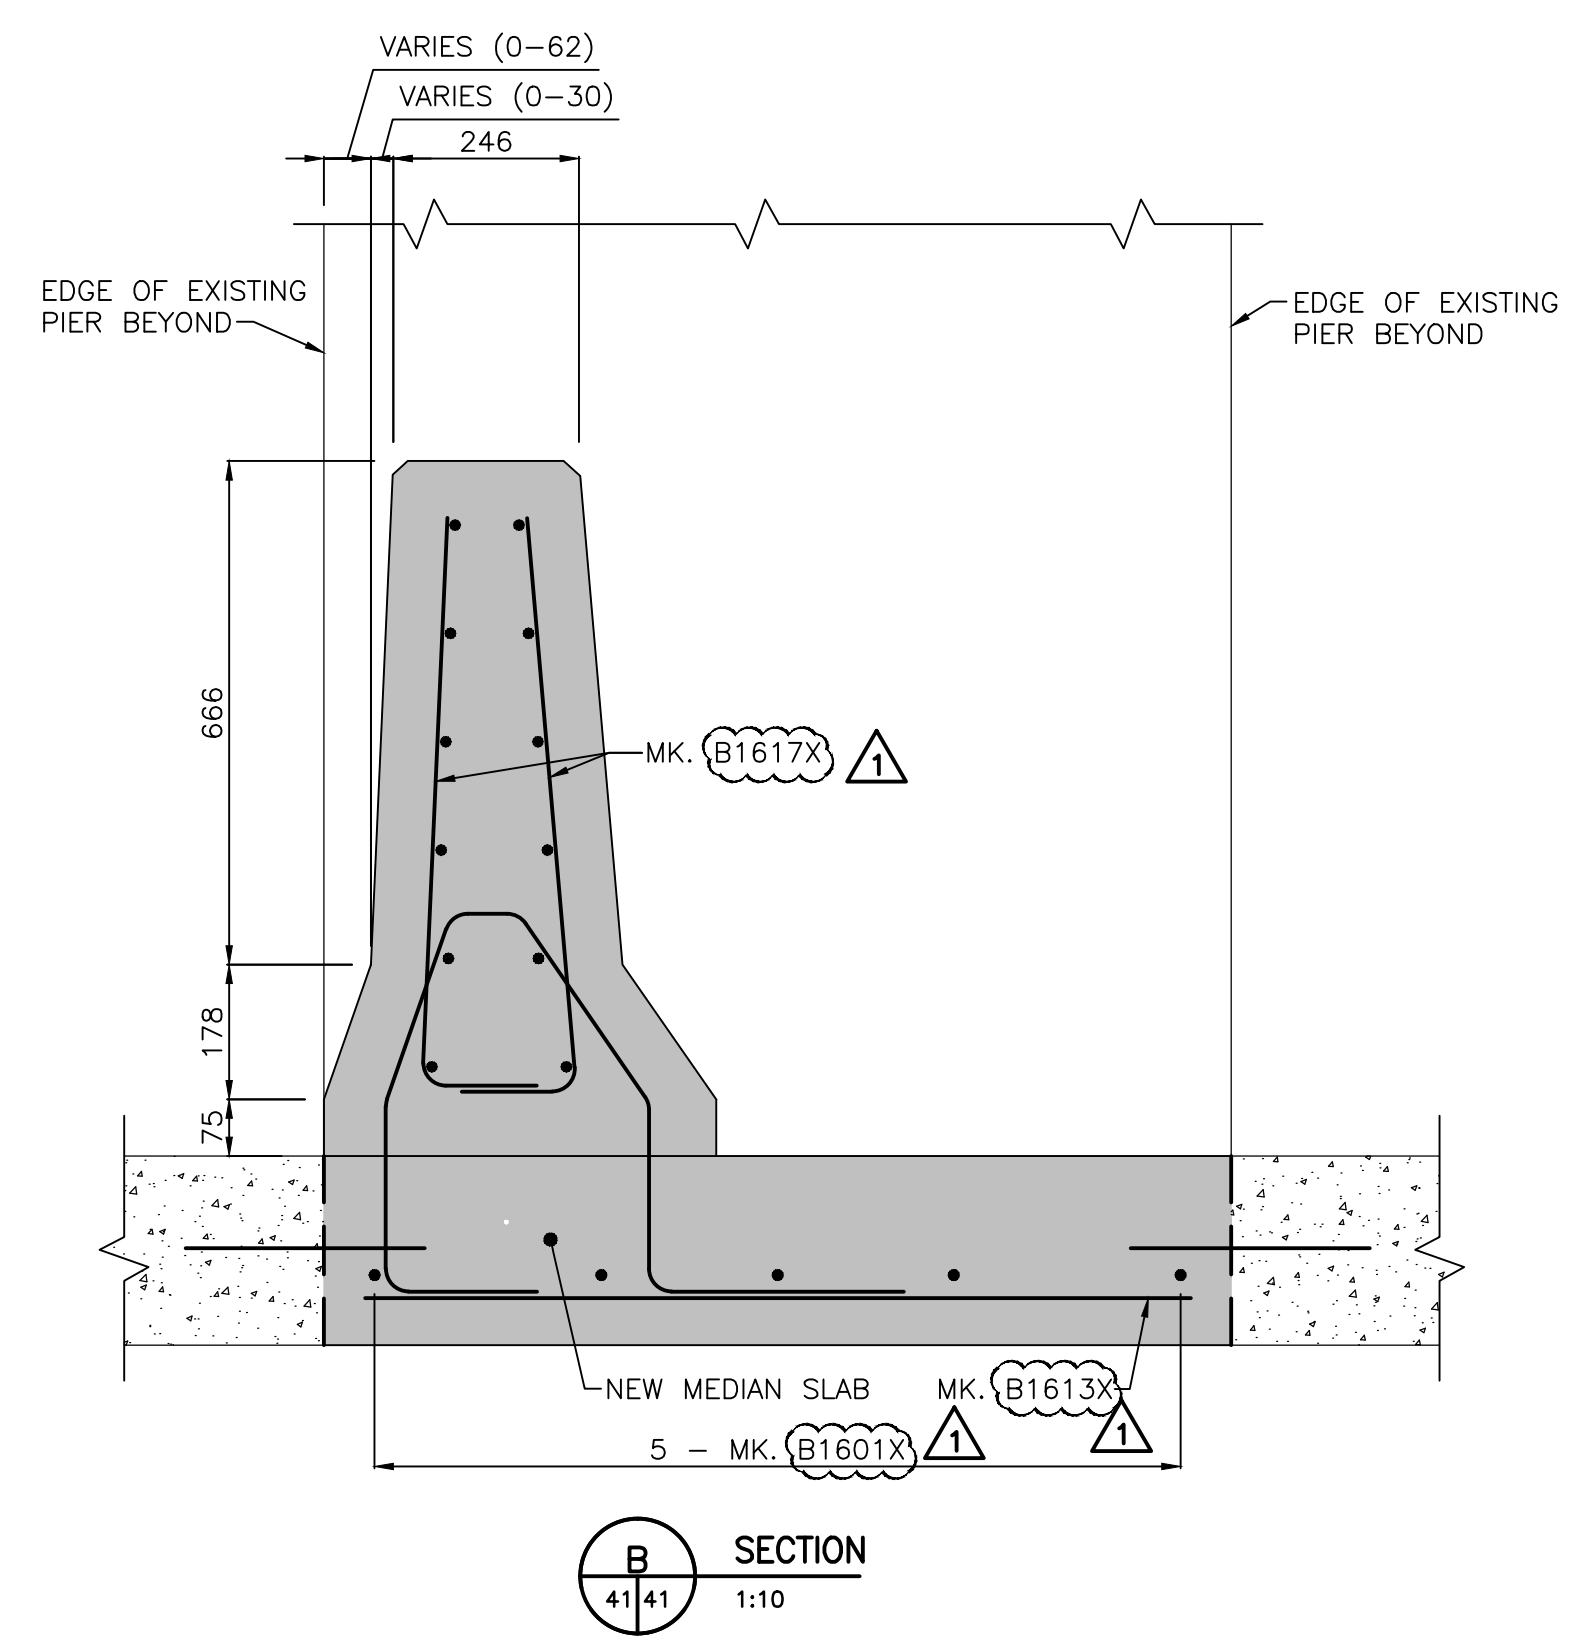

B SECTION
41/41 1:10

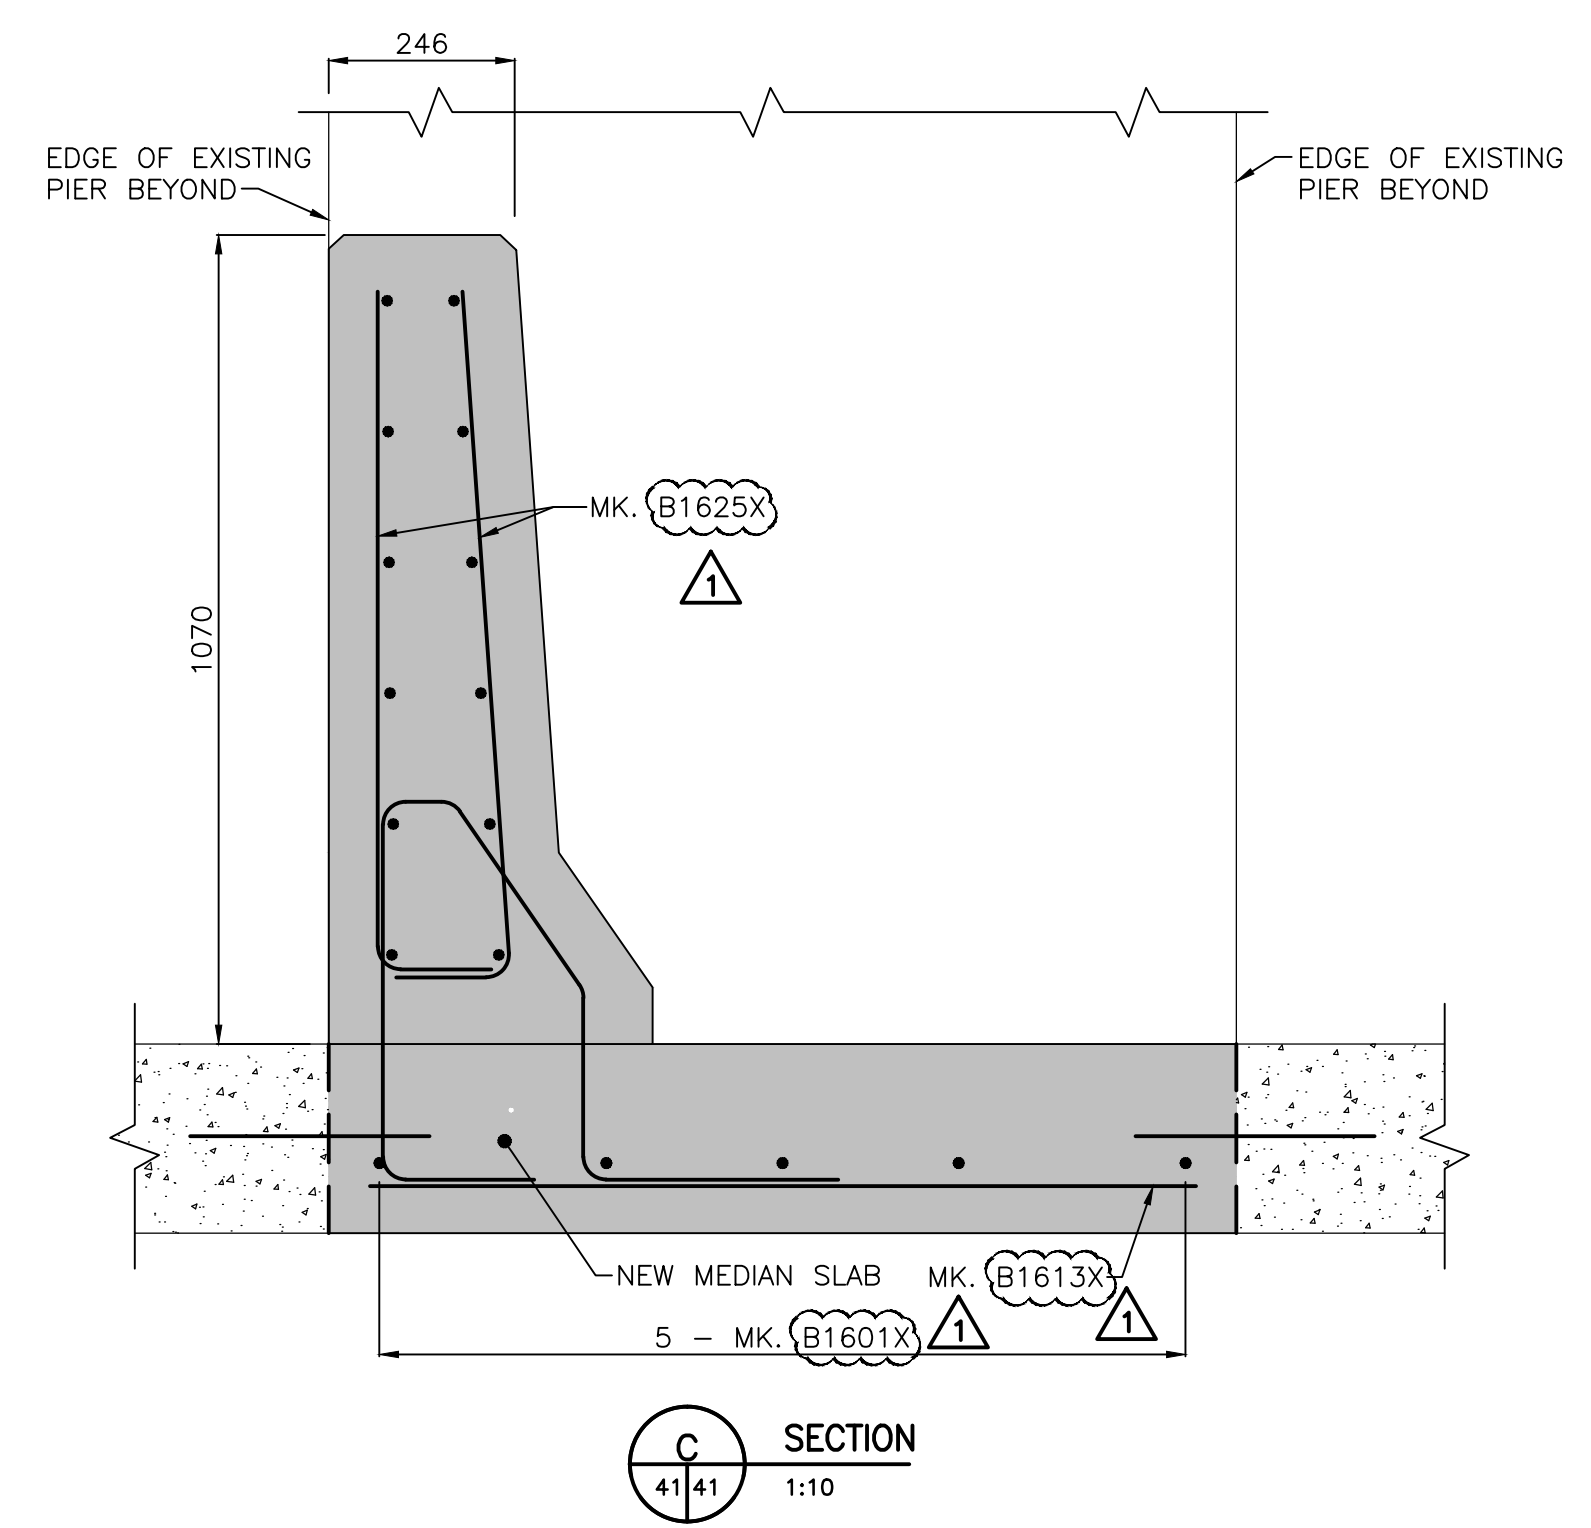

C SECTION
41/41 1:10

LOCATION APPROVED UNDERGROUND STRUCTURES

SUPV. U/G STRUCTURES COMMITTEE DATE

NOTE:
LOCATION OF UNDERGROUND STRUCTURES AS SHOWN ARE BASED ON THE BEST INFORMATION AVAILABLE BUT NO GUARANTEE IS GIVEN THAT ALL EXISTING UTILITIES ARE SHOWN OR THAT THE GIVEN LOCATIONS ARE EXACT. CONFIRMATION OF EXISTENCE AND EXACT LOCATION OF ALL SERVICES MUST BE OBTAINED FROM THE INDIVIDUAL UTILITIES BEFORE PROCEEDING WITH CONSTRUCTION.

NO.	REVISIONS	DATE	BY
1	ISSUED FOR ADDENDUM No.1	16.07.13	K.S.A.
0	ISSUED FOR TENDER	16.07.04	K.S.A.

Stantec 500 - 311 Portage Avenue, Winnipeg MB Canada www.stantec.com		ENGINEER'S SEAL	
DESIGNED BY: S.Y.	CHECKED BY: K.S.A.	CONSULTANT DRAWING NO. S-125	
DRAWN BY: V.F.	APPROVED BY: B.J.W.		
HOR. SCALE: AS NOTED	RELEASED FOR CONSTRUCTION: DATE	DATE: 2016.02.19	

THE CITY OF WINNIPEG
PUBLIC WORKS DEPARTMENT
ENGINEERING DIVISION

2016 REGIONAL STREET PROGRAM
ARCHIBALD STREET
ST+ 130 TO ST+ 370
TRAFFIC BARRIER REINFORCING DETAILS

SHEET 41 OF 62
CAD FILE DRAWING NUMBER 06880s-119-884.dwg
CITY DRAWING NUMBER U205-16-41

I:\117\stn\11706880\03100_drawing\0302_struct\files\03_structural\06880s-119-884.dwg
 Date: 2016 Jul 13 9:15am User: Cagay, Trevor