



2 UNIVERSAL CHANGE RM 113, 116, & W/C 114, 117 ENLARGED PLAN
1:50

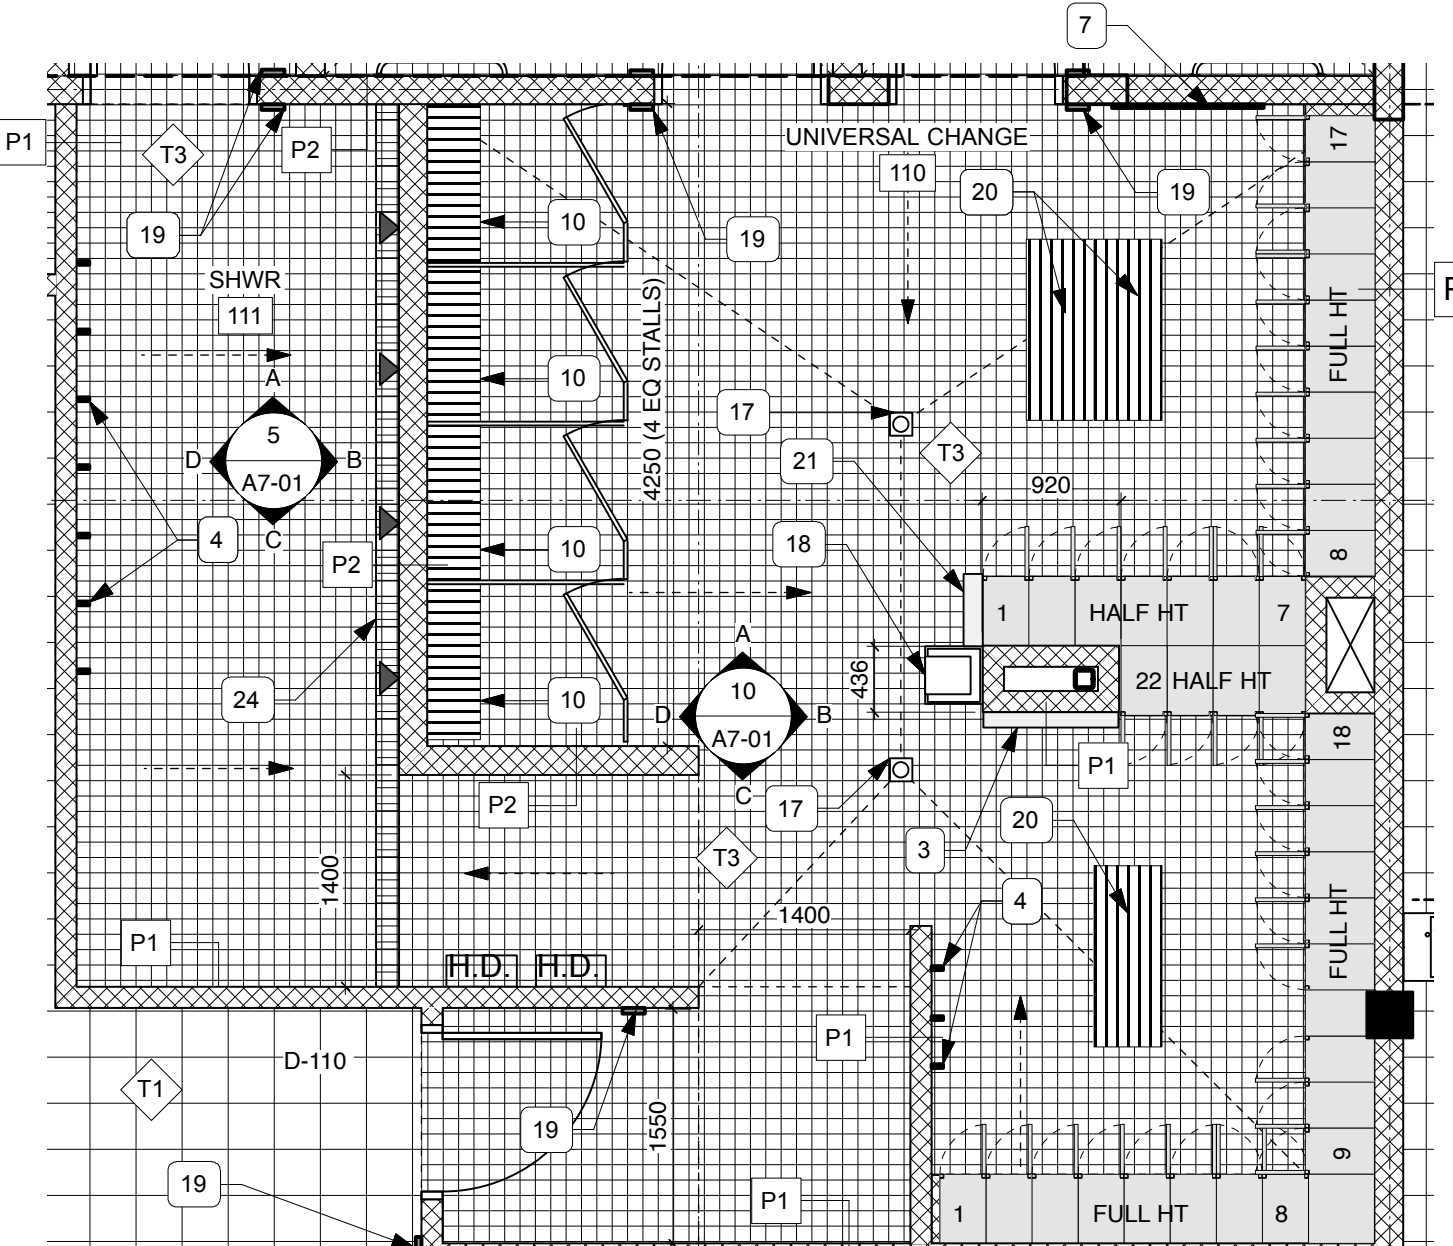


3 UNIVERSAL CHANGE 110, SHWR 111 ENLARGED PLAN
1:50

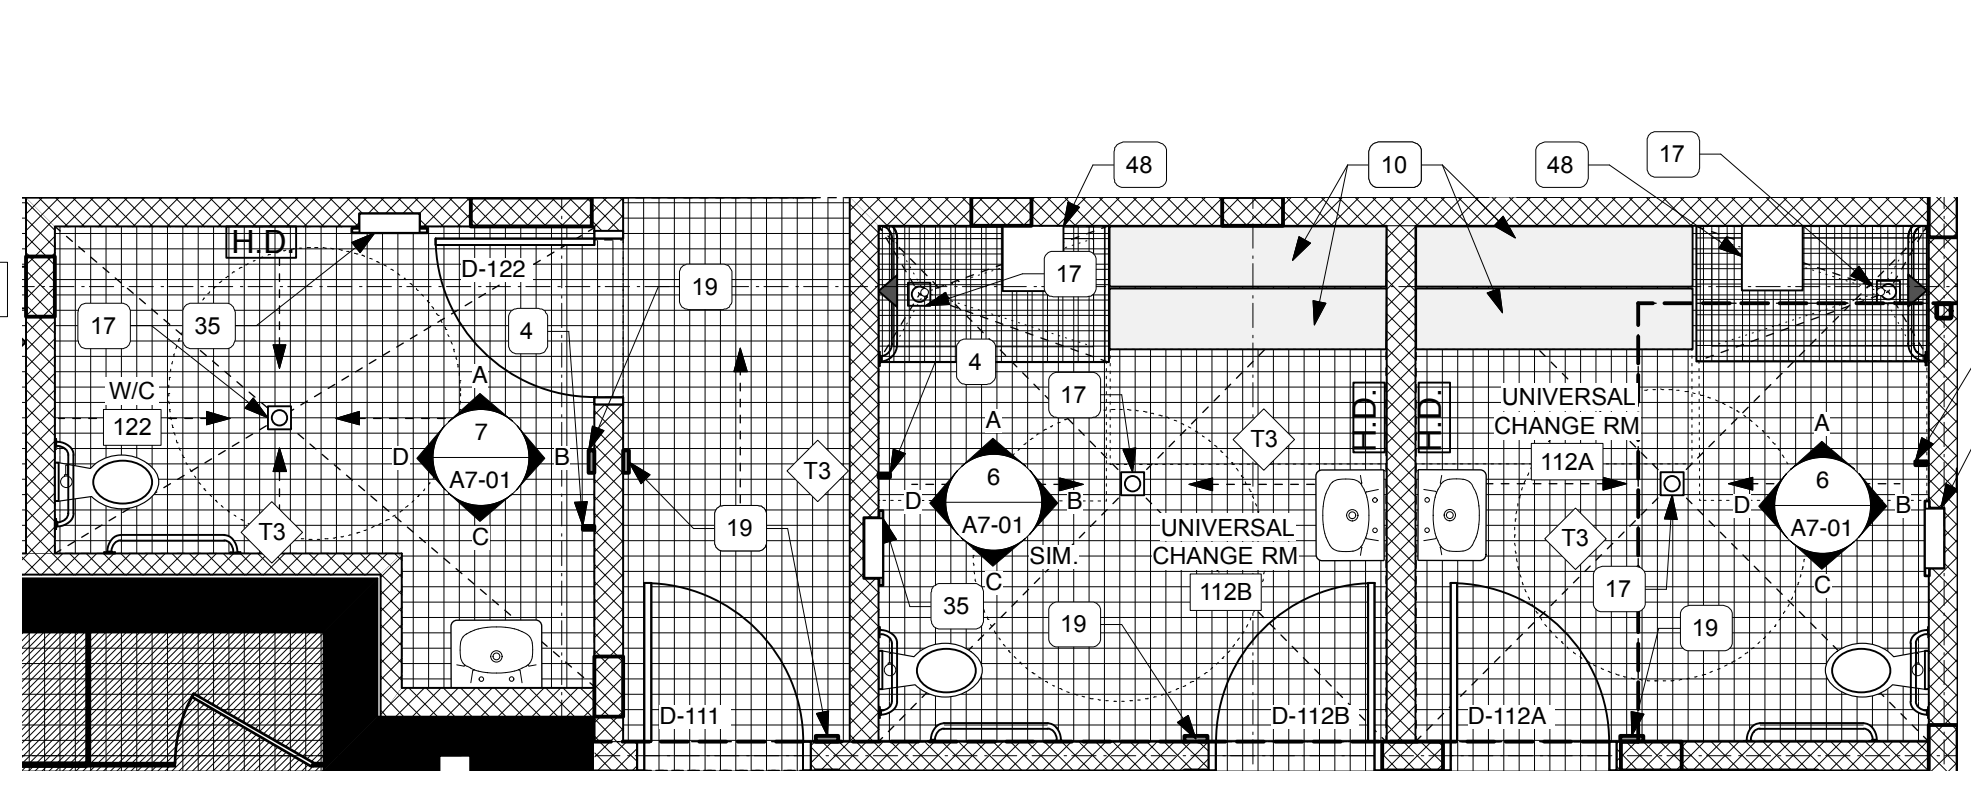

4 UNIVERSAL CHANGE RM 112A, 112B, W/C 122 ENLARGED PLAN
1:50

MAIN FLOOR GENERAL NOTES:

1. PROVIDE CONC CURB UP TO 100 000 LEVEL BELOW ALL CMU WALLS IN SPLASH PAD 123.
2. PROVIDE MILWORK OVER ALL HALF HEIGHT LOCKERS AS PER DETAILS ON A8-03.

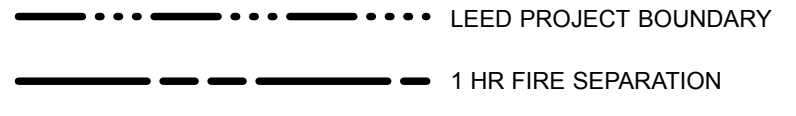


MAIN FLOOR PLAN KEYNOTES:

1. EXISTING DOOR TO REMAIN.
2. MECHANICAL AREA FENCE. REFER TO DETAILS ON EXTERIOR ELEVATIONS.
3. BABY CHANGE STATION
4. HOOK
5. POOL ACCESS LADDER
6. EXIST RECESSED DRINKING FOUNTAIN TO REMAIN
7. WALL MOUNTED WATER HYDRANT (SEE MECH) & OUTLET (SEE ELEC).
8. WALL MOUNTED MIRROR
9. LOCATION OF TV MONITOR (NIC) ROUGH-IN ONLY
10. CHANGE BENCH
11. NEW CMU TO BE TOOTHED INTO EXISTING CMU WALL
12. DRINKING FOUNTAIN, REFER TO MECH
13. CARD ACCESS (SEE ELEC)
14. COUNTERTOP W/ MIRROR ABOVE
15. CLEAREST WINDOW ABOVE. REFER TO EXTERIOR ELEVATIONS
16. POOL GUTTER SYSTEM, SEE MECH
17. NEW FLOOR DRAIN, SLOPE FLOOR TO DRAIN AS INDICATED (SEE MECH)
18. SWIMSUIT DRYER (NIC) ROUGH-IN ONLY
19. AUTO-DOOR OPERATOR ACTUATOR BUTTON (COORDINATE W/ ELEC)
20. LOCKER ROOM BENCH
21. P LAM COUNTER ABOVE LOCKERS (REFER TO MILWORK DETAILS)
22. POOL DEPTH MARKINGS (EVERY 8M)
23. EXIST FIRE EXTINGUISHER CABINET TO REMAIN
24. DECK DRAIN, REFER TO MECH
25. DUAL INTERCONNECT POOL DRAINS
26. PA SYSTEM RACK RE-LOCATED (SEE ELEC)
27. OWNER SUPPLIED SAFE
28. MEZZANINE ABOVE
29. RWL PIPE, REFER TO MECH
30. FIRE DEPARTMENT CONNECTION TO REMAIN (SEE MECH)
31. CCTV CAMERA LOCATION ROUGH-IN (SEE ELEC)
32. CANOPY ABOVE
33. CONCRETE SLOPED WALKWAY, REFER TO STRUCT & LANDSCAPE
34. ENTRY GATE SYSTEM, REFER TO DOOR HARDWARE
35. SEMI-RECESSED WASTE RECEPTACLE
36. SEMI-RECESSED FIRE EXTINGUISHER
37. RE-LOCATED EXIST LOCKER ROOM BENCH
38. INFILL W/ SALVAGED BRICK FROM EXTERIOR TO MATCH EXISTING
39. RE-LOCATE EXISTING WHITEBOARD
40. RE-LOCATE EXIST BENCH FROM VESTIBULE
41. REMOVEABLE SECTION OF ALUM RAILING FOR STRETCHER ACCESS, SECURE PIPE INTO CONCRETE FLOOR W/ MTL SLEEVE
42. FIXED SECTION OF ALUM RAILING
43. 127 DIA. ROUND HSS RWL FROM CANOPY, POWDER COAT FINISH TO MATCH CANOPY COLUMNS. TIE INTO IRRIGATION. REFER TO DETAILS & LANDSCAPE
44. JANITOR SINK, REFER TO MECH
45. RELOCATE 1 COURSE OF SALVAGED GLAZED CONC. BLOCK UNDER NEW GLAZING B/W GL 11 & 12. REFER TO DETAIL 9/A5-02. MATCH EXISTING.
46. ROOF HATCH ABOVE. REFER TO SECTION 5/A4-05.
47. REFER TO LANDSCAPE FOR HANDRAIL DETAILS.
48. FOLD-UP SHOWER SEAT
49. GRAY BRICK PAVING PATIORS
50. LINE OF EXISTING CONC. SLAB. REFER TO STRUCT.

issue / rev.

#	date	issue notes
5	2016.08.16	addendum 01
4	2016.07.12	issued for construction
3	2016.06.13	issued for 99% review
2	2015.12.02	issued for class 'c' pricing
1	2015.03.03	issued for class 'c' pricing

professional seals

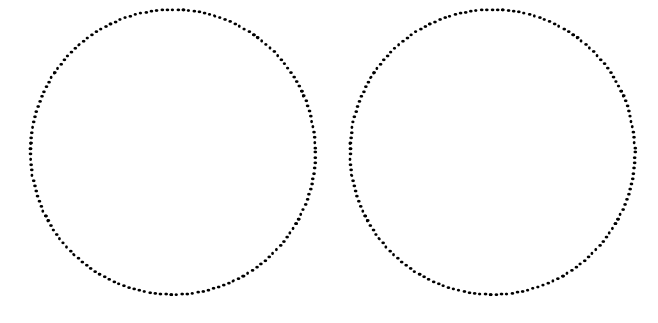

project information

SEVEN OAKS POOL RENOVATION & ADDITION

444 ADSUM DRIVE
WINNIPEG, MB
CANADA


client

CITY OF WINNIPEG
4TH FLOOR - 85 KING ST.
WINNIPEG, MB

drawing information

MAIN FLOOR PLAN & ENLARGED PLANS

drawn by: LW
approved by: DF
scale: 1:100
date issued: 2016.07.15
proj. #: 2014.66
rev. #: R-0

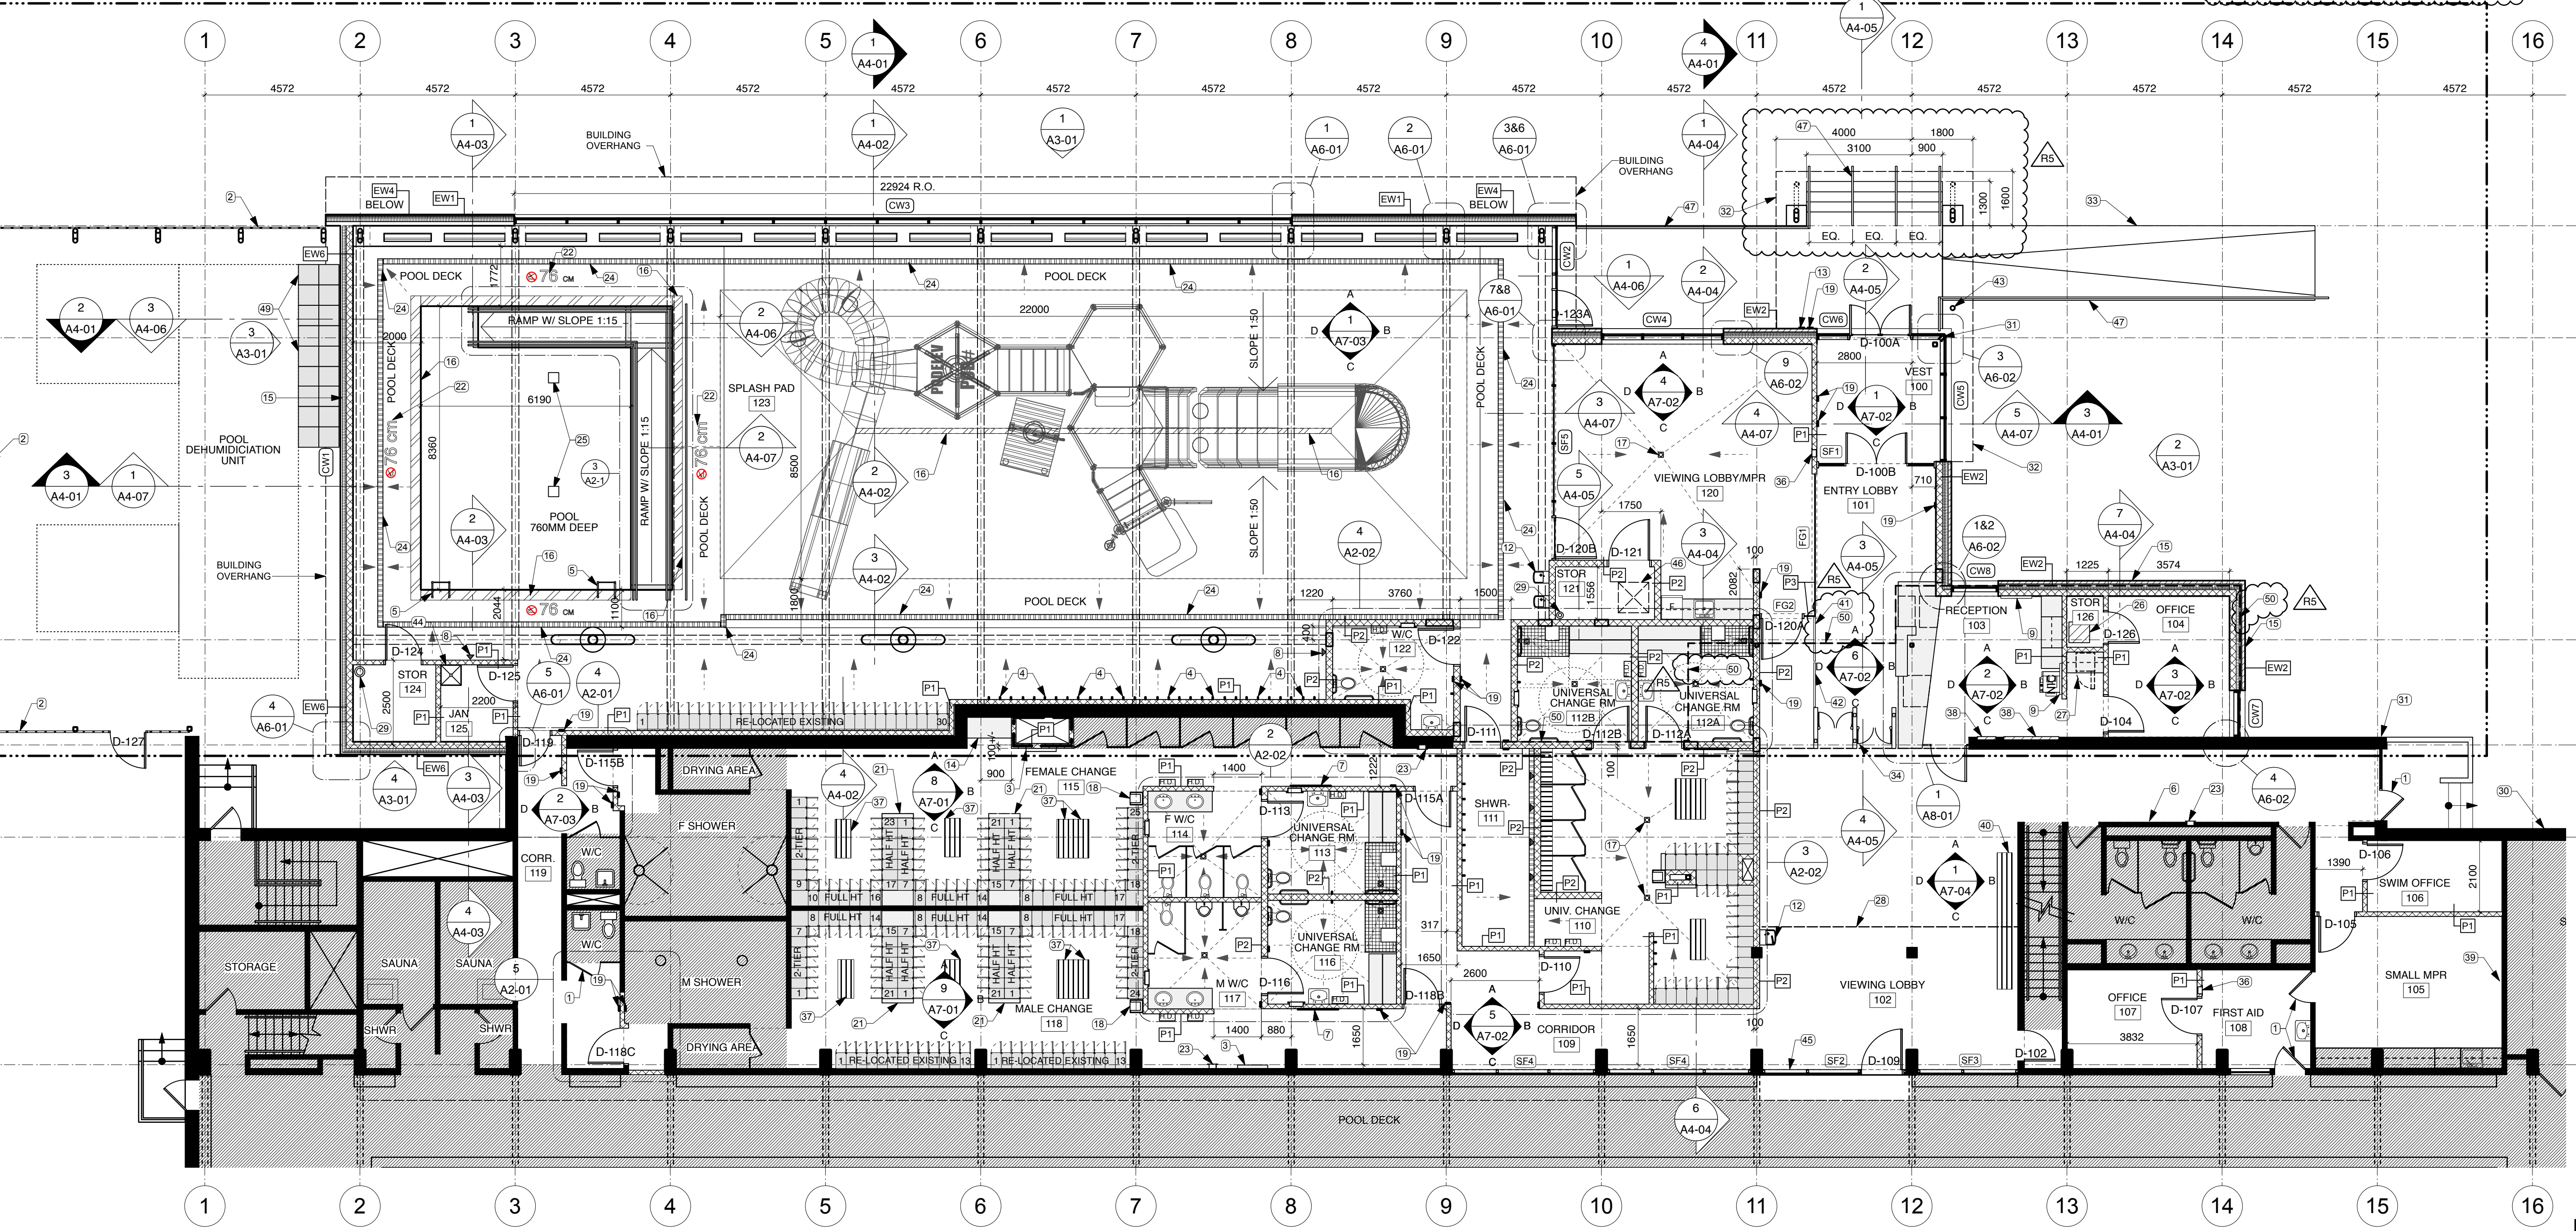

1 MAIN FLOOR PLAN
1:100

