


issue / rev.

#	date	issued notes
1	2016.08.16	ISSUED FOR ADDENDUM #1
0	2016.07.15	ISSUED FOR CONSTRUCTION

professional seals

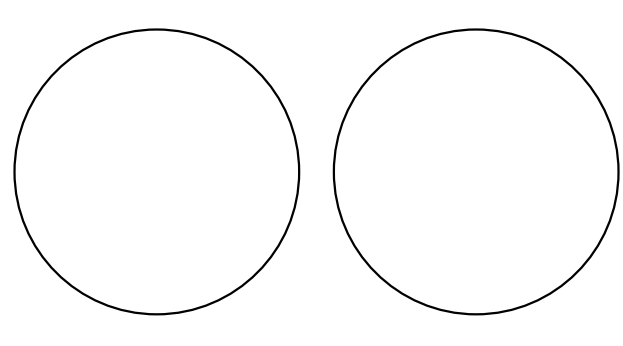

project information

SEVEN OAKS POOL RENOVATION & ADDITION  
444 ADSUM DRIVE  
WINNIPEG, MB  
CANADA

client

CITY OF WINNIPEG  
4TH FLOOR - 85 KING ST.  
WINNIPEG, MB

drawing information


Building Sections

drawn by: M.B. / AVP  
approved by: FDW

scale: 1 : 100  
date issued: 2016.07.12  
proj. #: W14432  
rev. #: 1

SEVEN OAKS POOL RENOVATION & ADDITION  
BID OPPORTUNITY NO. 645-2016

This drawing must not be scaled. The contractor shall verify all dimensions and other data on site prior to commencement of work. All discrepancies, errors, and omissions are to be reported to the architect. Drawings and specifications, as instruments of service, are the property of the architect, and when made, must bear his name. All rights to be retained by the architect on request. No reproduction may be made without the permission of the architect, and when made, must bear his name. All rights to be retained by the architect on request.

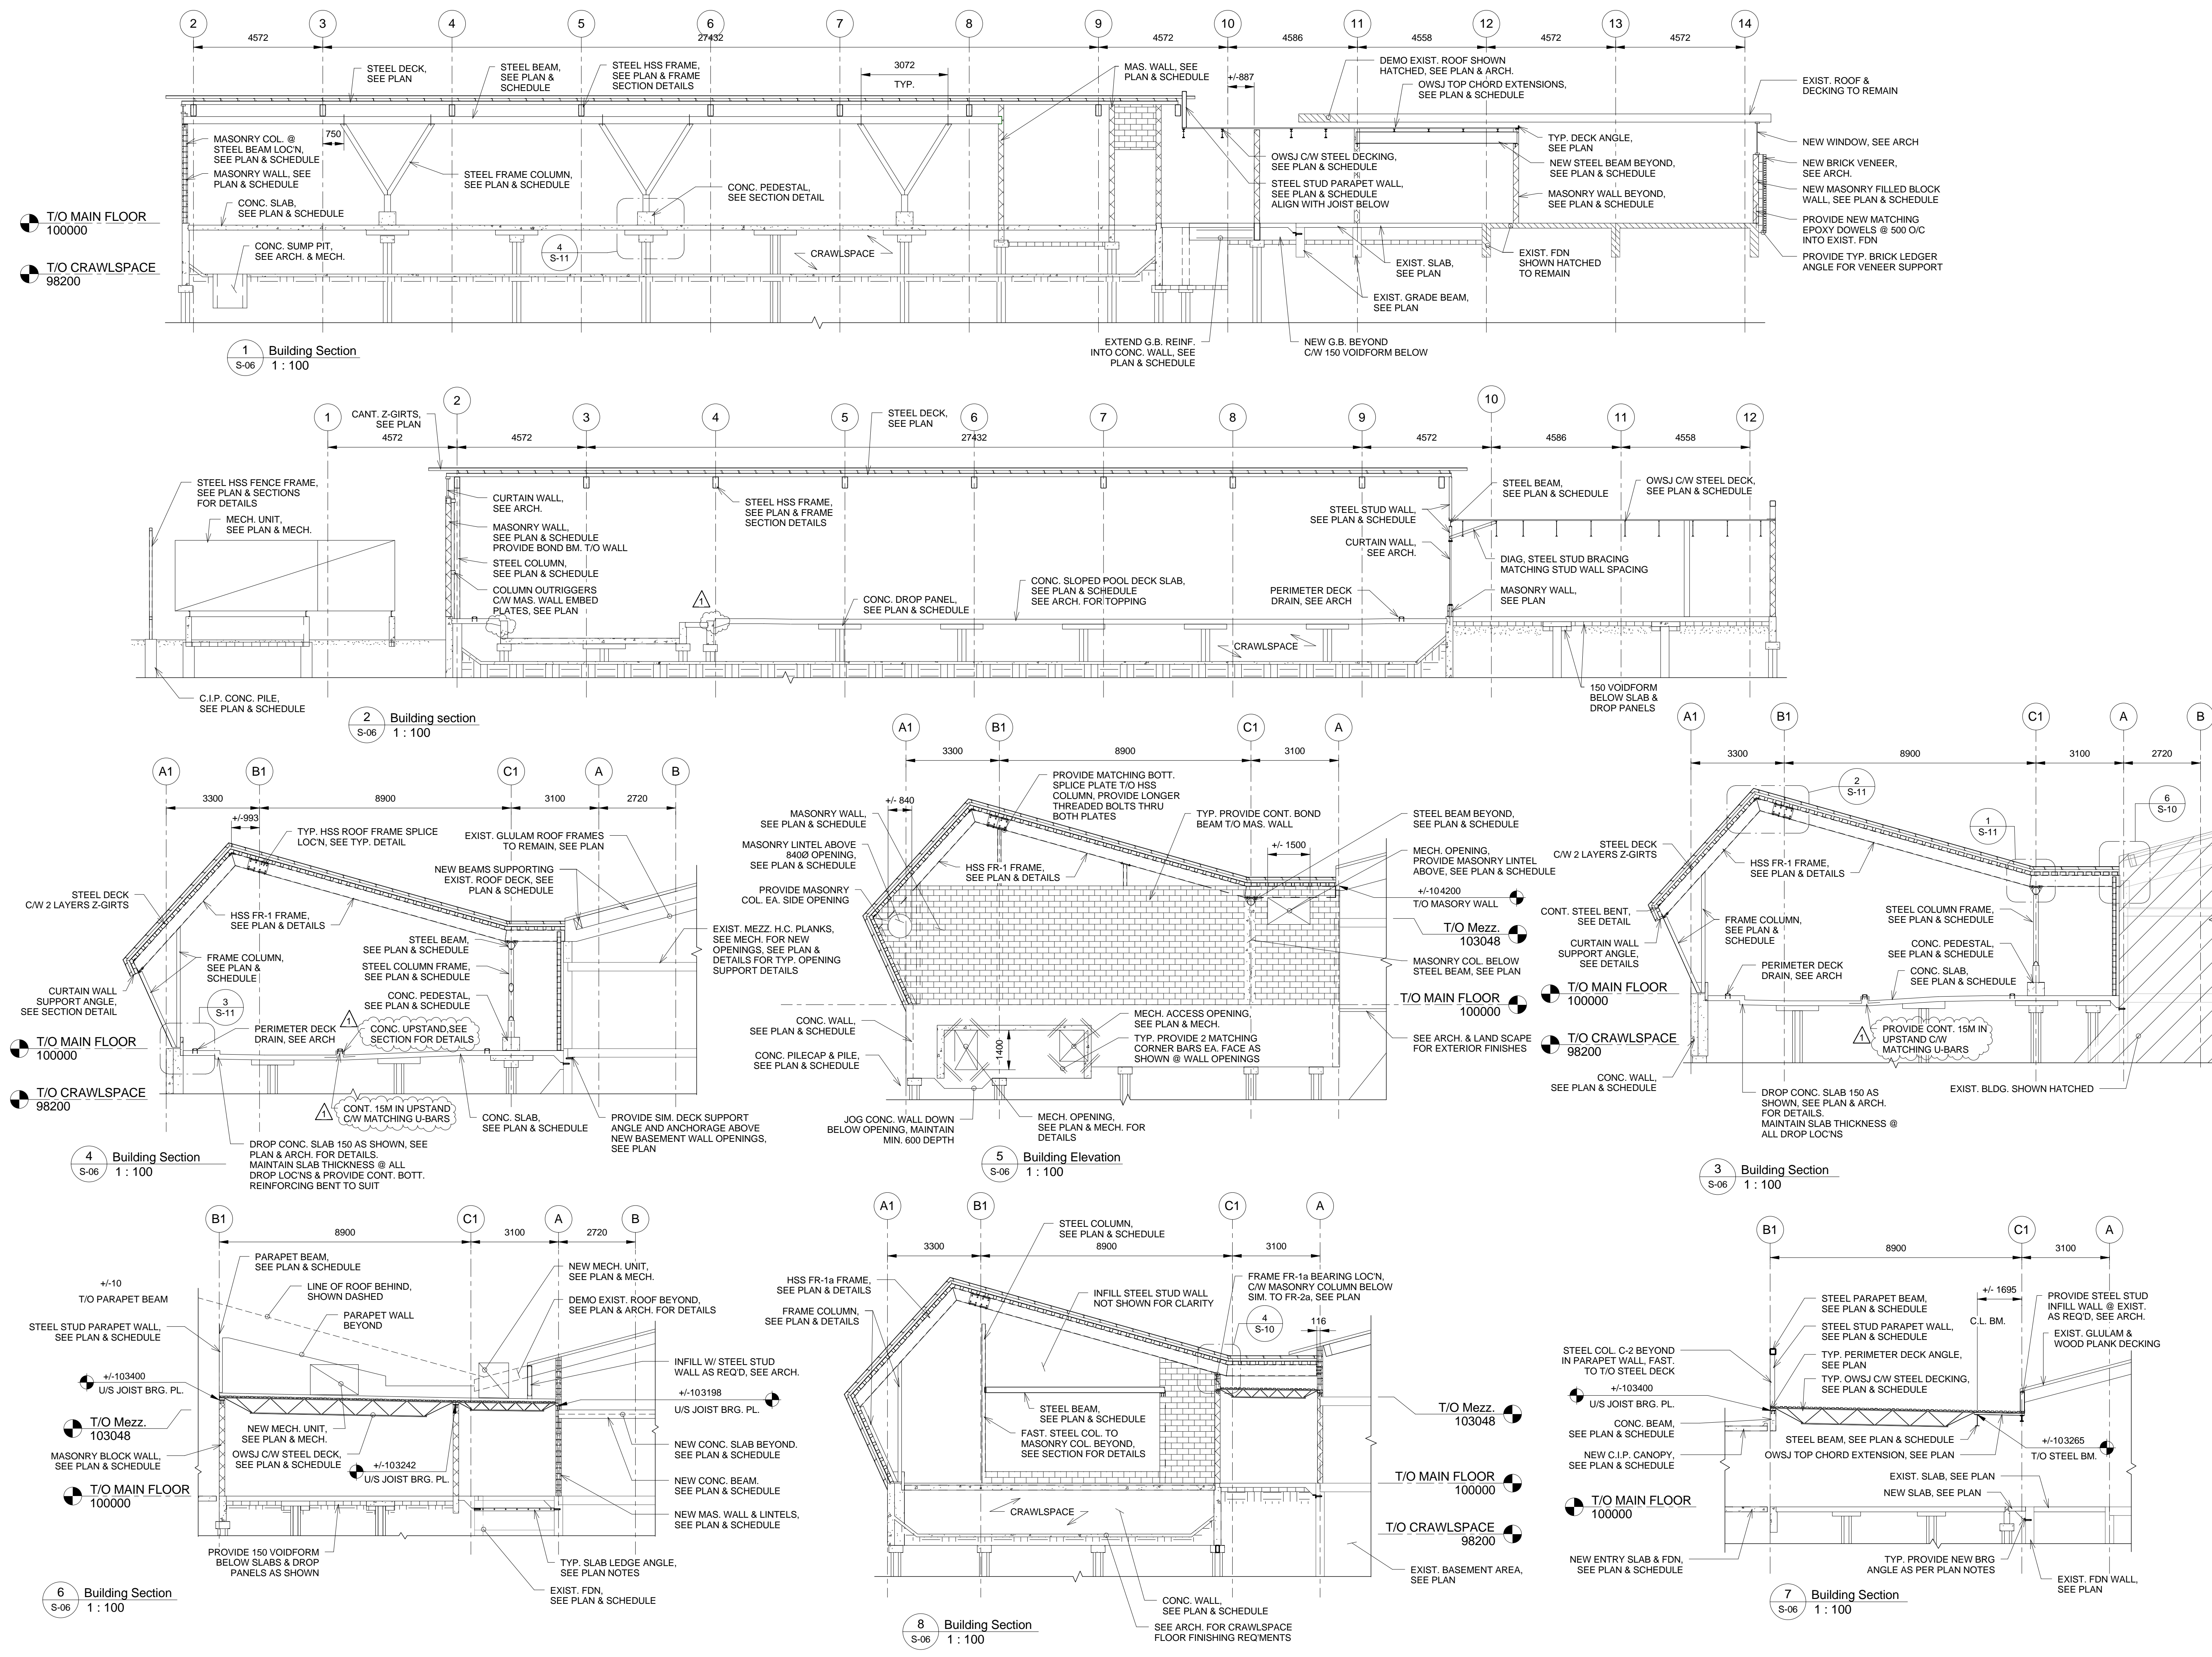

1 Building Section  
S-06 1 : 100

2 Building section  
S-06 1 : 100

4 Building Section  
S-06 1 : 100

5 Building Elevation  
S-06 1 : 100

3 Building Section  
S-06 1 : 100

6 Building Section  
S-06 1 : 100

8 Building Section  
S-06 1 : 100

7 Building Section  
S-06 1 : 100