


150 mm W.M.	WATERMAIN	150 mm W.M.
Hydrant symbol	HYDRANT	Hydrant symbol
Valve symbol	VALVE	Valve symbol
300 mm L.D.S.	LAND DRAINAGE SEWER	300 mm L.D.S.
220 mm W.W.S.	WASTE WATER SEWER	220 mm W.W.S.
Manhole symbol	MANHOLE	Manhole symbol
Catch basin symbol	CATCH BASIN	Catch basin symbol
Curb inlet symbol	CURB INLET	Curb inlet symbol
Junction symbol	JUNCTIONS	Junction symbol
Culvert symbol	CULVERT	Culvert symbol
Gas symbol	GAS	Gas symbol
Existing symbol	EXISTING	Proposed symbol
	LEGEND - PLAN	

REVISED AS CONSTRUCTED
 DATE 02-12-77 BY [Signature]
 CHECKED BY [Signature]
 0.5 0 1 2 3m
 1:50
 B-5515-3
 METRIC
 2 1 0 2 4 6 8 10m
 1:200
 WHOLE NUMBERS INDICATE MILLIMETRES
 DECIMALIZED NUMBERS INDICATE METRES

025.8/62 L. Martine

PLAN

NO	REVISIONS	DATE	APP
2	REVISED TO "AS-BUILT"	12/7/84	J.M.
1	REVISED TO "AS-CULT" L.D.S.	12/3/83	

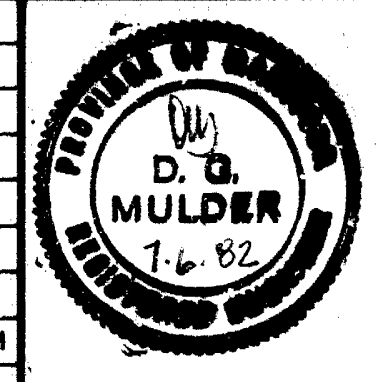

INTERDISCIPLINARY ENGINEERING COMPANY
 PROFESSIONAL ENGINEERS
 WINNIPEG MANITOBA
 DESIGNED BY: D.M.
 CHECKED BY: D.M.
 APPROVED BY: [Signature]
 DRAWN BY: [Signature]
 DATE: 21-05-82
 DATE: 13-5-82

THE CITY OF WINNIPEG
 WORKS & OPERATIONS
 DIVISION
 STREETS & TRANSPORTATION
 DEPARTMENT

ROUTE 90 UNDERPASS
 LAND DRAINAGE SEWER
 STA. 1+00 TO 1+21.3 EAST
 AUTHORIZED BY [Signature] 1982-10-08
 ACCEPTED BY [Signature] 82/10/08
 SCALE: HOR 1:200 VERT 1:50
 DRAWING NO U228-83-P03