

4TH FLOOR - 185 KING STREET R3B 1J1 Project: St. Vital Library

Project Number: 16054
Bid Opportunity Number: 768-2016

Drawing Title:
MEZZANINE FLOOR ACCESS
CONTROL & COMMS PLAN

# Issue/Revision Date

ISSUED FOR CONSTRUCTION


ADDENDUM #1 OCT 31, 2016

Sheet No: T-6

**APEGIN** 

Certificate of Authorization

This drawing is property of the Architect and cannot be reproduced or used without the consent of the Architect. The contractor is responsible for checking and verifying all levels and dimensions and shall report all discrepancies to the Architect and obtain clarification prior to commencing work.

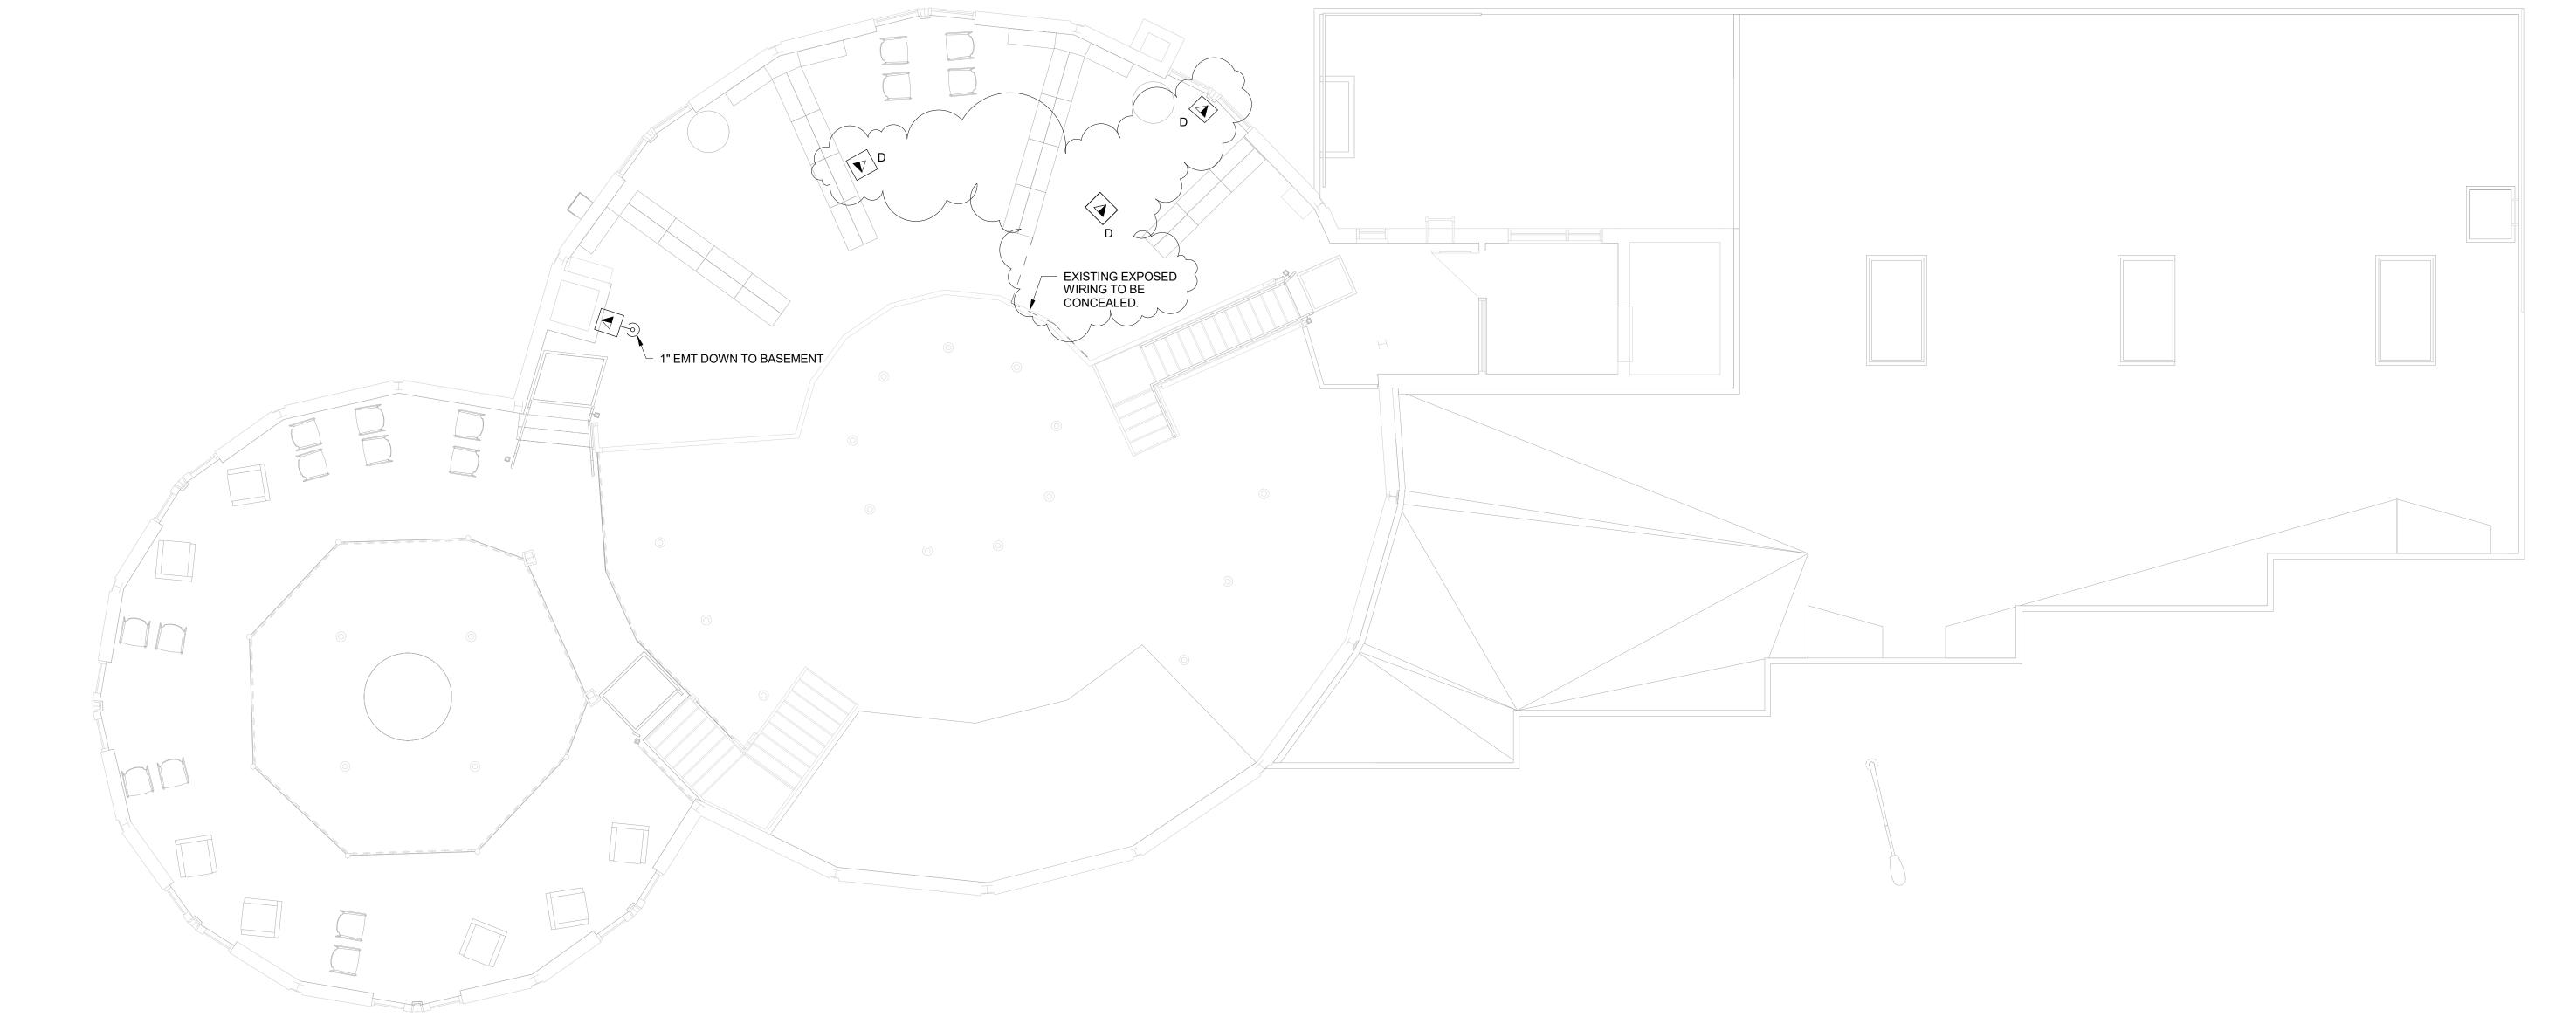

MEZZANINE FLOOR ACCESS CONTROL & COMMS PLAN



