


60' LONG LED LIGHT STRIP (W/ BLUE ILLUMINATION & BLUE DIBONG VALANCE) & 18" to 24" HIGH BLACK ALUMINUM LETTERS (1/4" THICK) W/ ARIAL FONT ON GRAHAM AVENUE

+/- 80'-6" x +/- 7'-0" BACKER PANEL, 62'-4" x 4" L.E.D. DIVIDER BAR & ILLUMINATED HALO-LIT CHANNEL LETTERS OF 13" TO 18" HIGH LETTERS W/ ARIAL FONT ON GRAHAM AVENUE. SEE SECTION FOR MORE DETAILS.

BUILDING PANEL JOINTS BEYOND

1 LARGE ELEVATION SCALE: N.T.S.
A1 A2

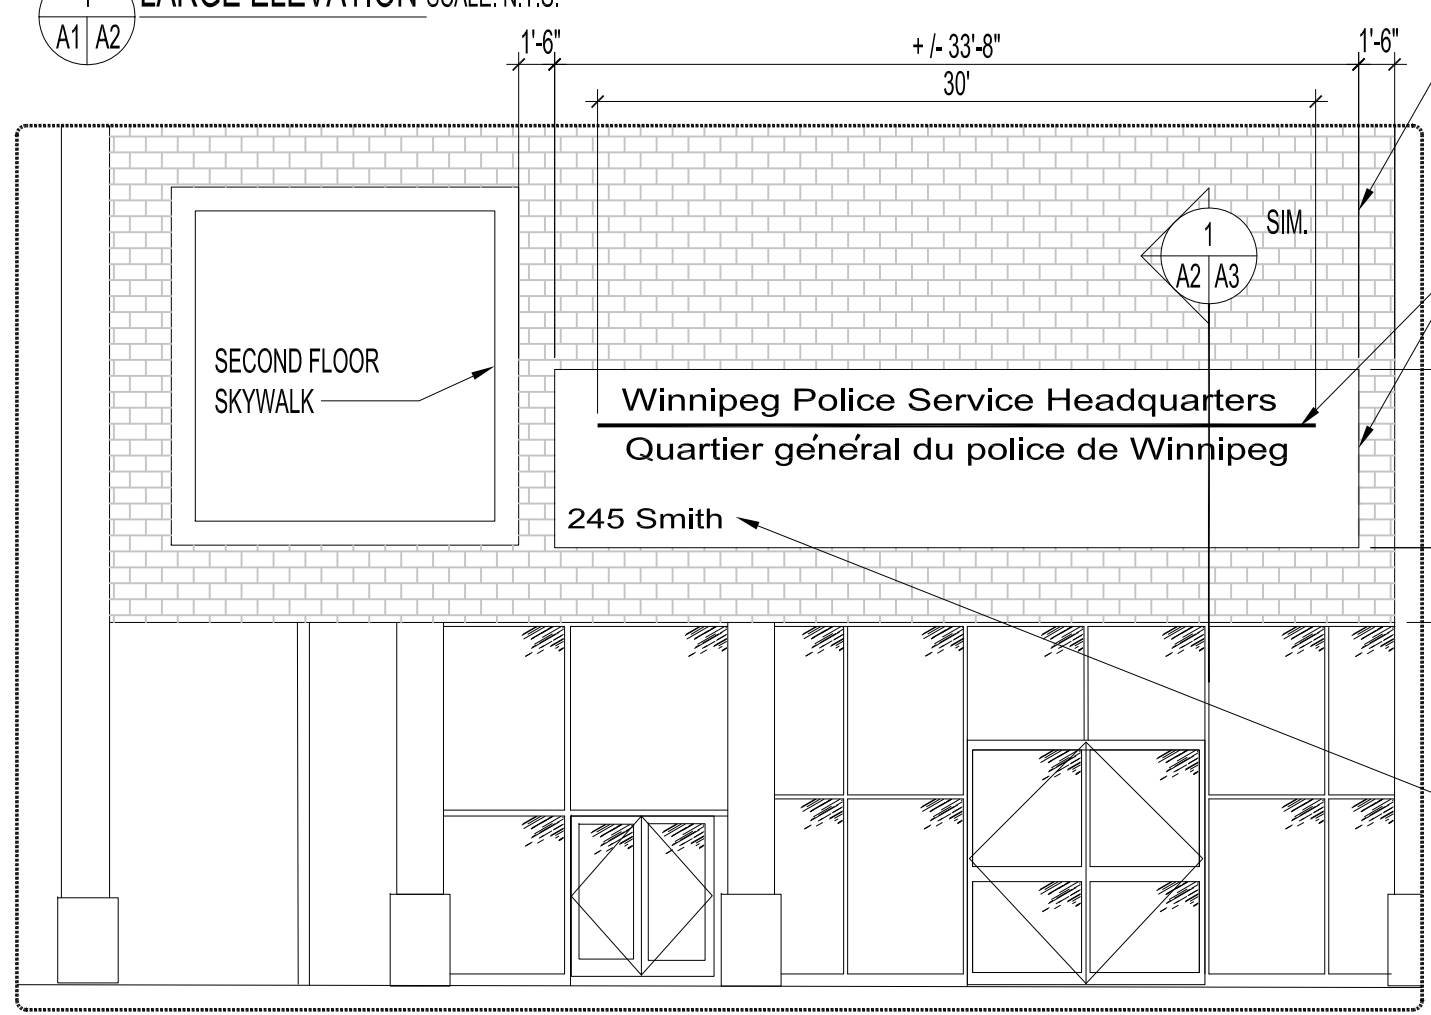

30' LONG LED LIGHT STRIP (W/ BLUE ILLUMINATION & BLUE DIBONG VALANCE) & 14" to 16" HIGH BLACK ALUMINUM LETTERS (1/4" THICK) W/ ARIAL FONT ON SMITH STREET ELEVATION.

+/- 33'-8" x +/- 7'-6" BACKER PANEL (PANEL MAY BE LARGER DEPENDING ON LETTERING), 29'-10 5/8" x 3 1/2" L.E.D. DIVIDER BAR & ILLUMINATED HALO-LIT CHANNEL LETTERS OF 8 1/4" TO 11" HIGH LETTERS W/ ARIAL FONT ON SMITH STREET. SEE SECTION FOR MORE DETAILS.

10" HIGH x 1/4" THICK FLAT MOUNTED ALUMINUM LETTERS IN ARIAL FONT, (NON-ILLUMINATED)

10" HIGH BLACK ALUMINUM LETTERS (1/4" THICK)

REVISIONS

1	-DELETE NOTES & ADD NEW SIGN NOTES	MMK	OCT19, 2016
	-CHANGE LENGTH OF DIVIDER BAR ON GRAHAM AVENUE FROM 60'-0" TO 62'-4"		

1 LARGE ELEVATION SCALE: N.T.S.
A1 A2

THE CITY OF WINNIPEG PLANNING, PROPERTY AND DEVELOPMENT DEPARTMENT MUNICIPAL ACCOMMODATIONS DIVISION 3-65 GARRY STREET, R3C 4K4			PROJECT Winnipeg Police Service Headquarters NEW EXTERIOR SIGNAGE 245 SMITH STREET		SHEET TITLE LARGE ELEVATIONS	
DRAWN BY: MMK	DESIGNED BY: RL	CHECKED BY:	APPROVED BY:	DATE: 2016.07.25 eFILE: 2016050V0.dwg	SCALE: SHOWN PROJECT No: 2016-050	SHEET No: A2R1