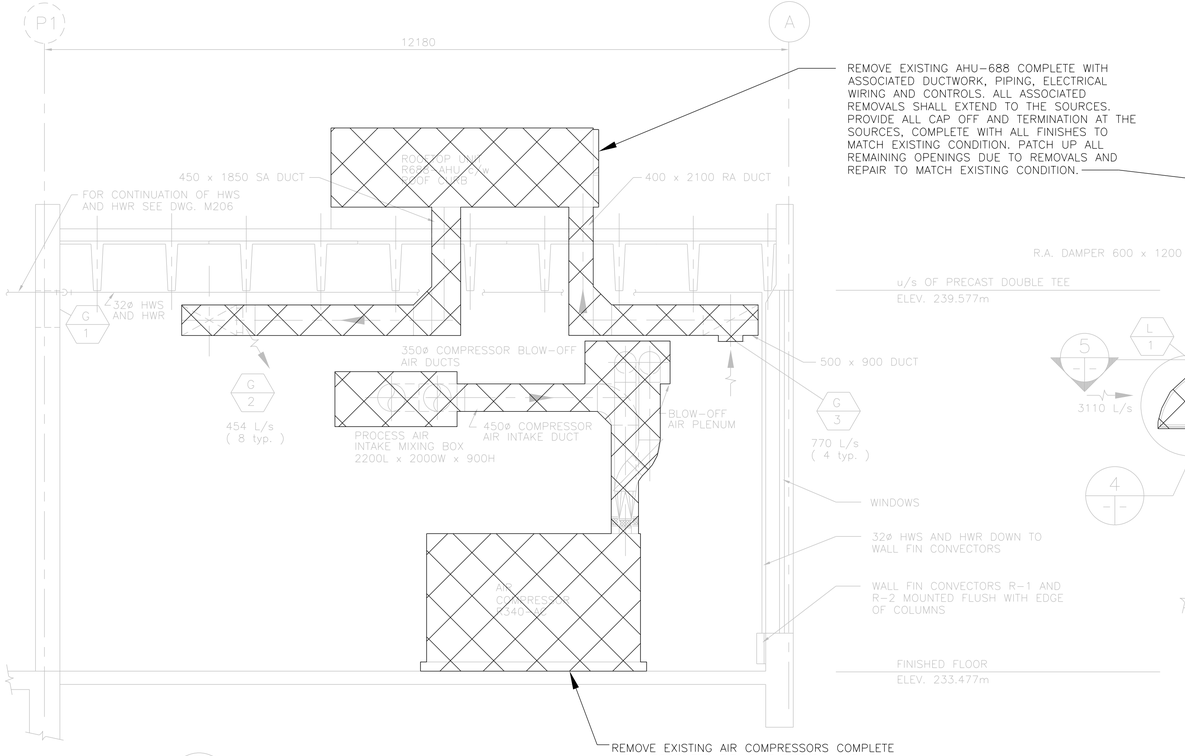

1 SECTION
M206 M207 1 : 50

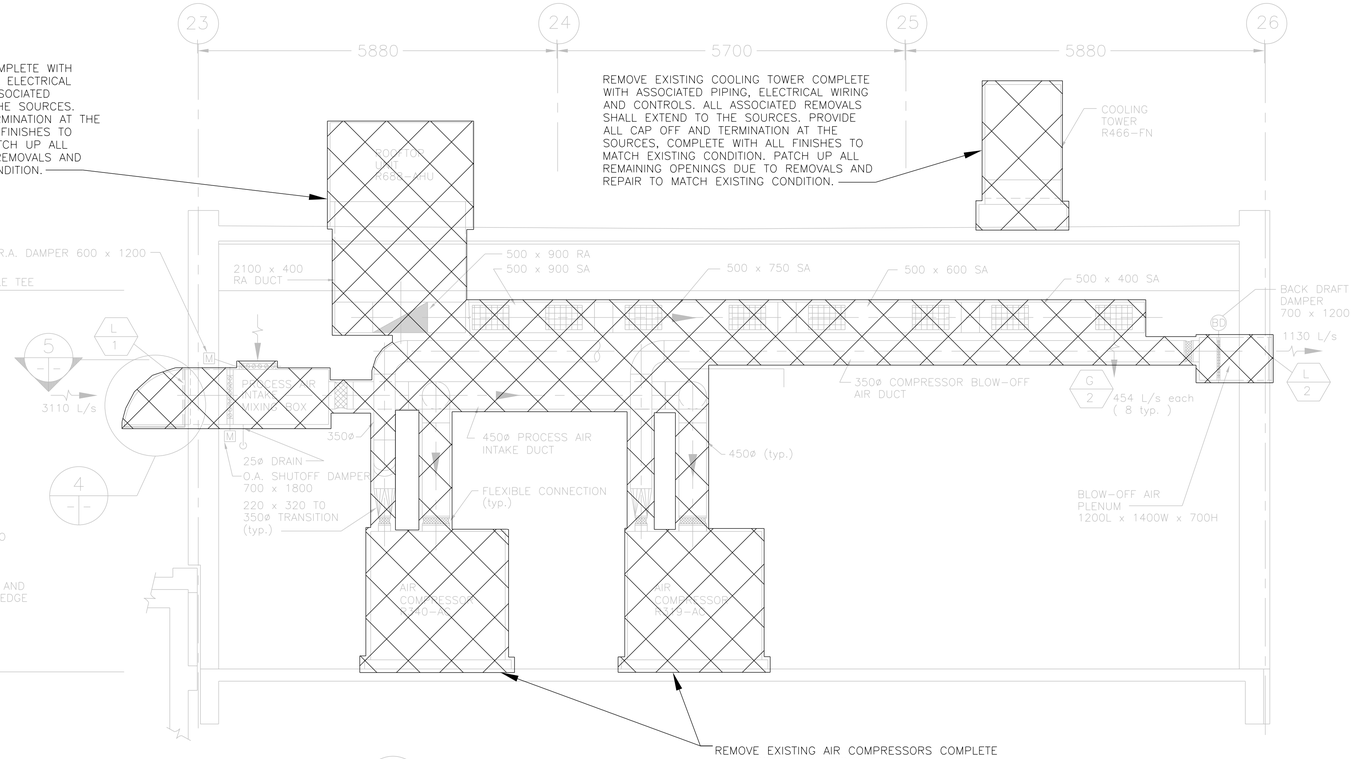

2 SECTION
M206 M207 1 : 50

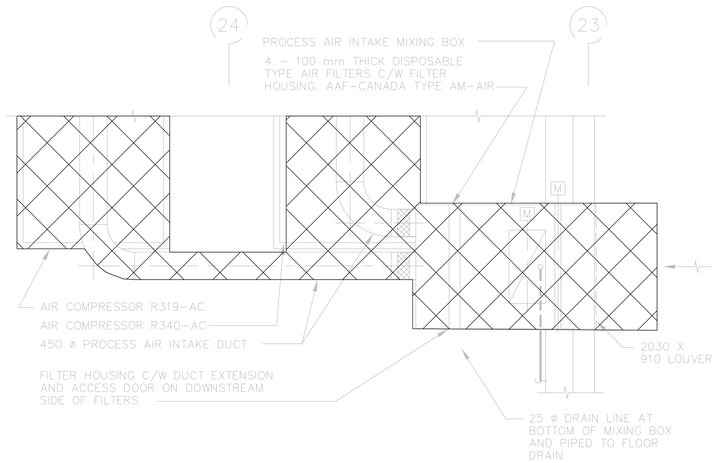

3 PSA COMPRESSOR ROOM PART PLAN
1 : 50

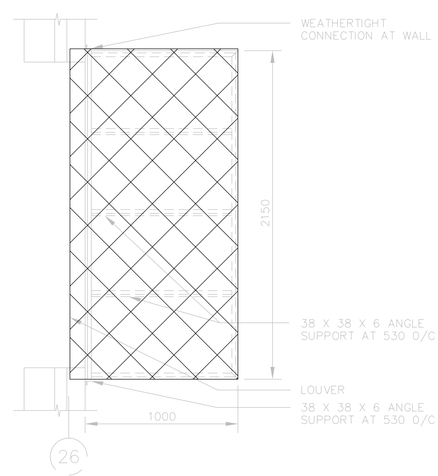

5 INTAKE HOOD
1 : 50

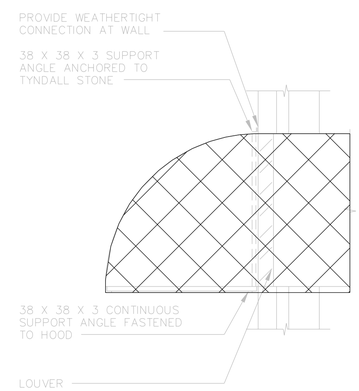

4 SECTION
1 : 20

NOTES:

1. FOR NEW CONSTRUCTION SEE PROCESS/MECHANICAL PRIMARY SLUDGE FERMENTERS/THICKENERS DRAWINGS.
2. REFER TO GENERAL DEMOLITION NOTES DRAWING 1-0102-DAAA-AD01.
3. ABESTOS CONTAINING MATERIALS MIGHT BE PRESENT IN EXISTING EQUIPMENT AND INSULATION. REFER TO SPECIFICATION SECTIONS 01 35 29, 02 82 11, 02 82 11 12, AND 02 82 13 FOR DETAILS.

AS CONSTRUCTED
DATE SEPTEMBER 1993 BY P.R.B.
APPROVED BY

NO.	REVISIONS	DATE	BY
00	ISSUED FOR CONSTRUCTION - 976-2016	04/05/2017	K.F.

B.M. ELEV.

MAC LAREN ENGINEERS INC.
WARDROP ENGINEERING INC.
ENGINEERING CONSULTANTS

DESIGNED BY	S.Q.	CHECKED BY	
DRAWN BY	V.J.H.	APPROVED BY	
HOR. SCALE: VERTICAL:	1:50	RELEASED FOR CONSTRUCTION:	
DATE	JAN.1990	DATE	

ORIGINALLY DESIGNED BY
PROVINCE OF MANITOBA T.T. TRAN Member 40578 REGISTERED PROFESSIONAL ENGINEER
Apr 11/17
CONSULTANT DRAWING NO. 870012-01-22-R-M207

THE CITY OF WINNIPEG
WORKS AND OPERATIONS DIVISION
WATERWORKS, WASTE & DISPOSAL DEPARTMENT
SOUTH END WATER POLLUTION CONTROL CENTRE
PSA EXPANSION – MECHANICAL
COMPRESSOR ROOM SECTIONS VENTILATION AND PIPING
CITY DRAWING NUMBER
SHEET OF
SEP-377