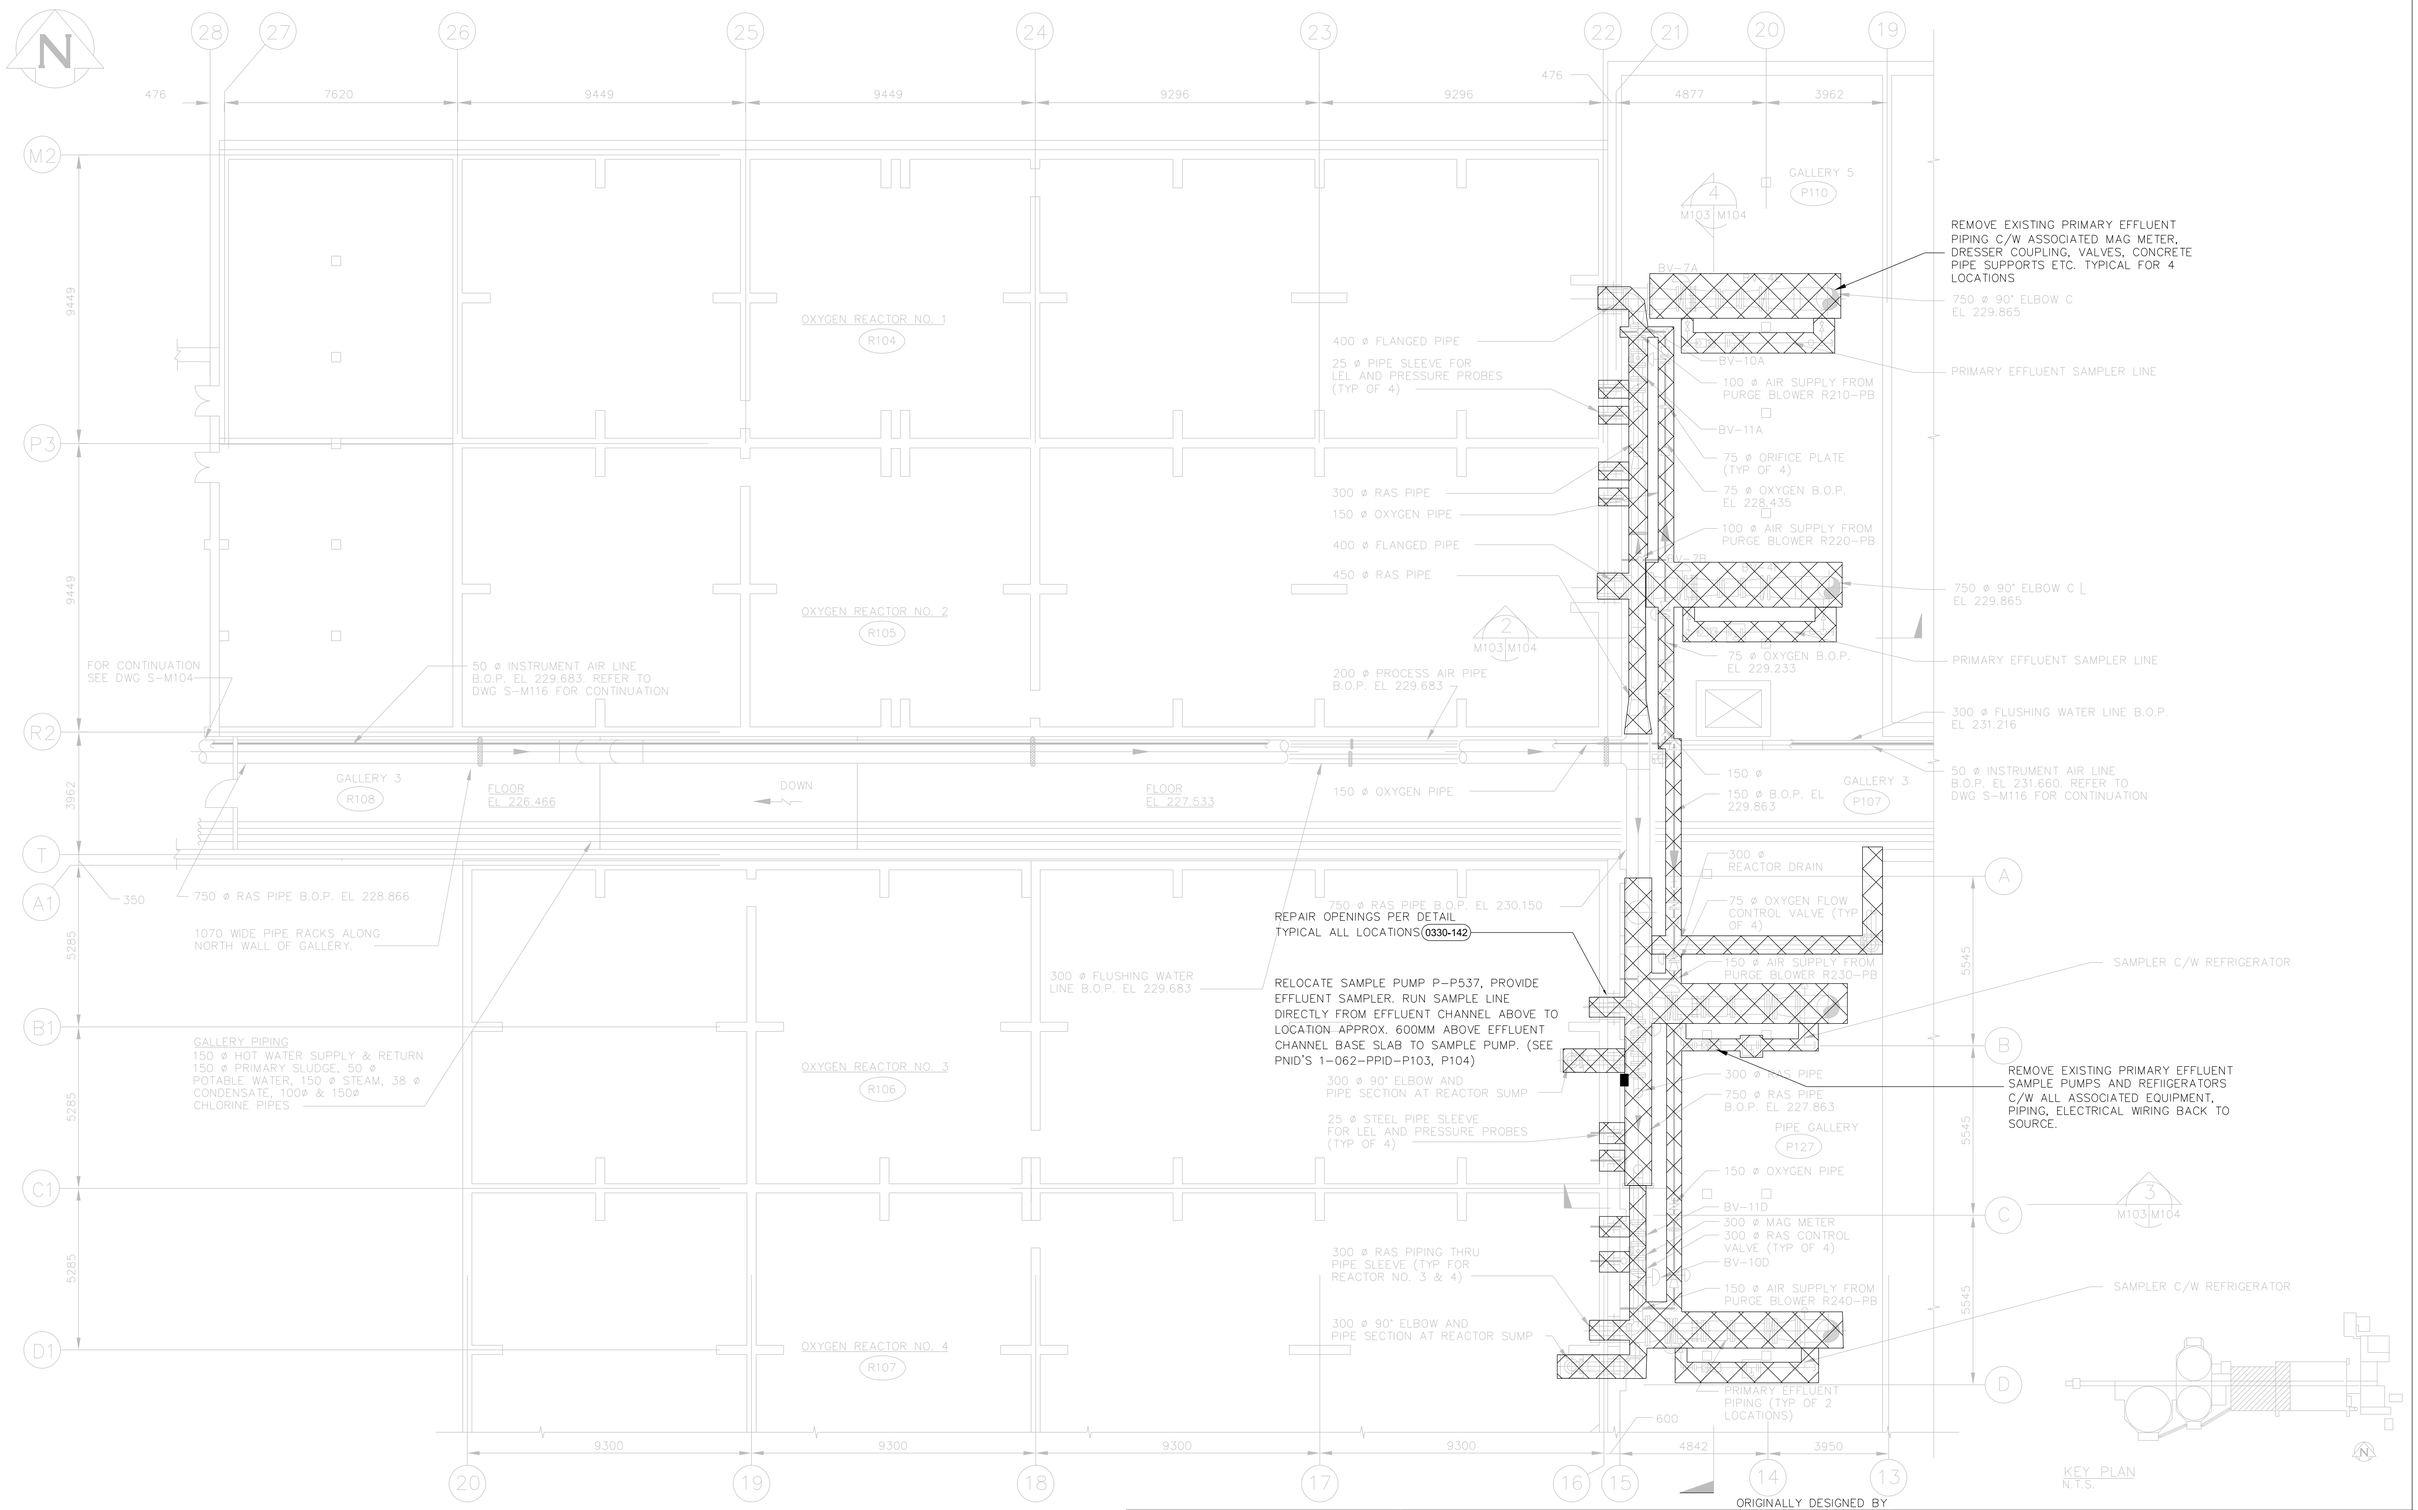

1 PLAN AT ELEVATION 227.533
1:100

NOTES:

1. FOR NEW CONSTRUCTION SEE PROCESS/MECHANICAL PRIMARY SLUDGE FERMENTERS/THICKENERS DRAWINGS.
2. REFER TO GENERAL DEMOLITION NOTES DRAWING 1-0102-DAAA-AD01.

AS CONSTRUCTED
DATE SEPTEMBER 1993 BY P.R.B.
APPROVED BY

NO.	REVISIONS	DATE	BY
00	ISSUED FOR CONSTRUCTION - 976-2016	04/05/2017	B.C.

B.M. ELEV.

MacLAREN ENGINEERS INC.
WARDROP ENGINEERING INC.
ENGINEERING CONSULTANTS

DESIGNED BY	L.C.	CHECKED BY	L.C.
DRAWN BY	E.G. /CAD	APPROVED BY	
HOR. SCALE: VERTICAL:	AS NOTED	RELEASED FOR CONSTRUCTION:	
DATE	APRIL, 1990	DATE	

ORIGINALLY DESIGNED BY
PROVINCE OF MANITOBA
F. J. ABSI
Member 36875
REGISTERED PROFESSIONAL ENGINEER
April 5, 2017
CONSULTANT DRAWING NO. 10009-R-M103

THE CITY OF WINNIPEG
WORKS AND OPERATIONS DIVISION
WATERWORKS, WASTE & DISPOSAL DEPARTMENT

SOUTH END WATER POLLUTION CONTROL CENTRE
OXYGEN REACTOR EXPANSION - MECHANICAL
OXYGEN REACTOR NO. 1, 2, 3 & 4
PLAN ELEVATION 227.533

CITY DRAWING NUMBER
SHEET OF
SEP-348