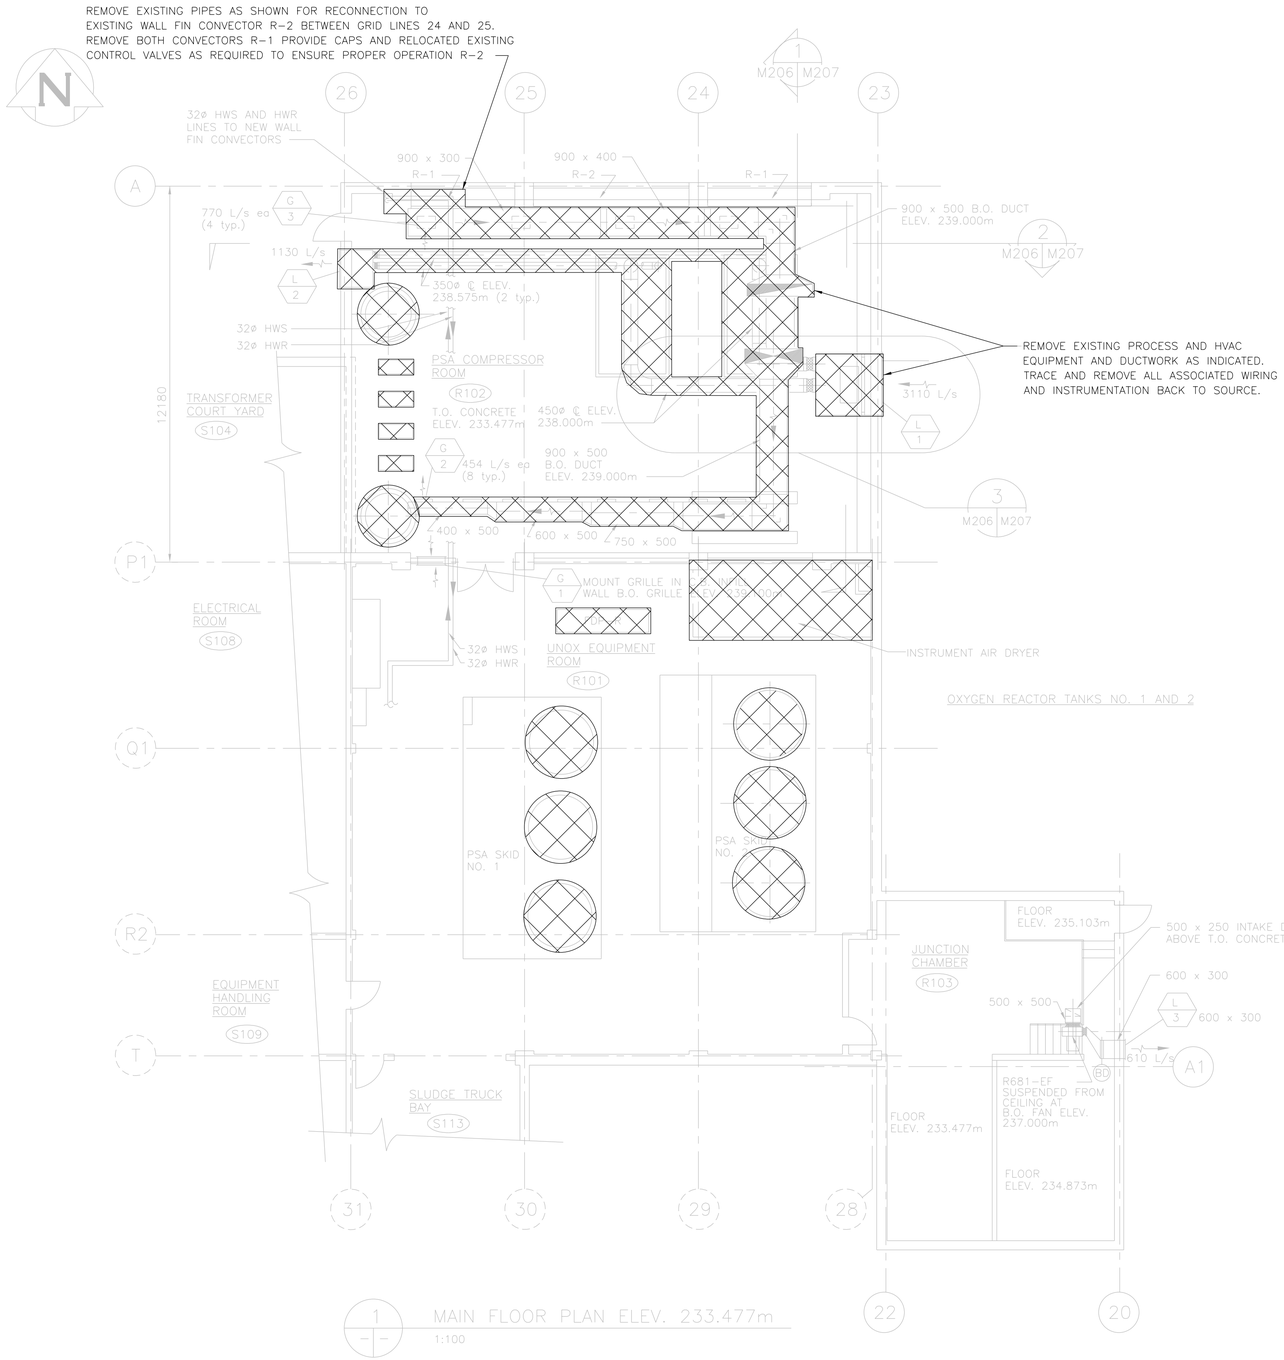

1 MAIN FLOOR PLAN ELEV. 233.477m
1:100

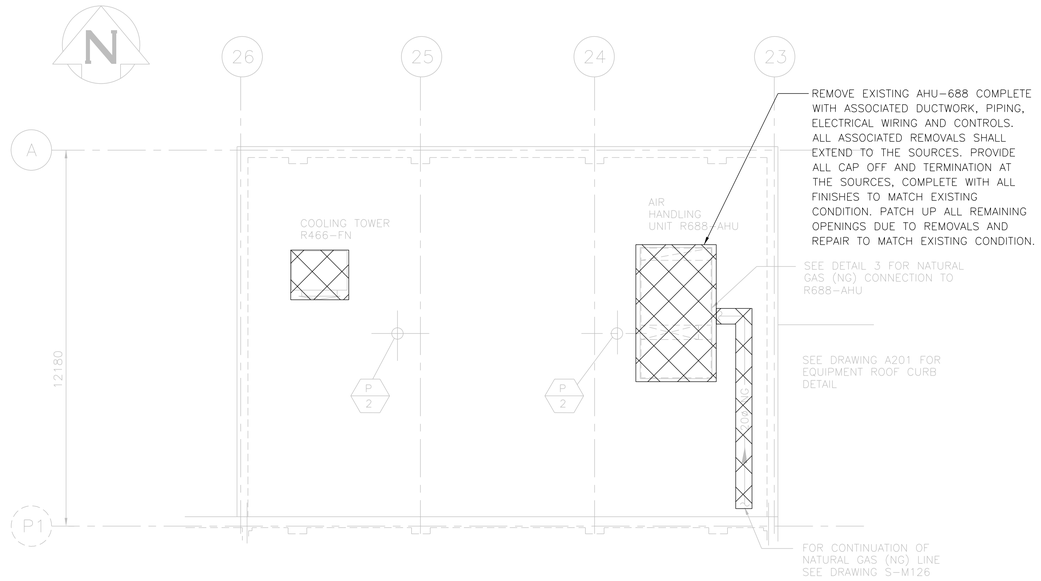

2 PARTIAL ROOF PLAN ELEV. 240.792m
1:100

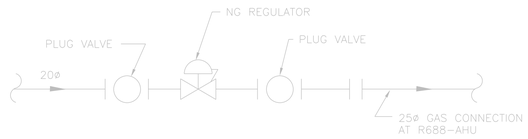

3 NATURAL GAS EQUIPMENT CONNECTION
N.T.S.

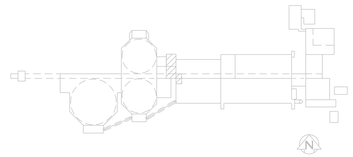

KEY PLAN
N.T.S.

NOTES:

1. FOR NEW CONSTRUCTION SEE PROCESS/MECHANICAL PRIMARY SLUDGE FERMENTERS/THICKENERS DRAWINGS.
2. REFER TO GENERAL DEMOLITION NOTES DRAWING 1-0102-DAAA-AD01.
3. ABESTOS CONTAINING MATERIALS MIGHT BE PRESENT IN EXISTING EQUIPMENT AND INSULATION. REFER TO SPECIFICATION SECTIONS 01 35 29, 02 82 11, 02 82 11 12, AND 02 82 13 FOR DETAILS.

AS CONSTRUCTED
DATE SEPTEMBER 1993 BY P.R.B.
APPROVED BY

NO.	REVISIONS	DATE	BY
00	ISSUED FOR CONSTRUCTION - 976-2016	04/05/2017	K.F.

B.M. ELEV.

MacLAREN ENGINEERS INC.
WARDROP ENGINEERING INC.
ENGINEERING CONSULTANTS

DESIGNED BY S.Q.	CHECKED BY
DRAWN BY V.J.H.	APPROVED BY
HOR. SCALE: VERTICAL: AS SHOWN	RELEASED FOR CONSTRUCTION:
DATE JAN.1990	DATE

ORIGINALLY DESIGNED BY
PROVINCE OF MANITOBA T.T. TRAN Member 40578 REGISTERED PROFESSIONAL ENGINEER
April 3/17
CONSULTANT DRAWING NO. 870012-01-22-R-M206

THE CITY OF WINNIPEG
WORKS AND OPERATIONS DIVISION
WATERWORKS, WASTE & DISPOSAL DEPARTMENT

SOUTH END WATER POLLUTION CONTROL CENTRE
PSA EXPANSION – MECHANICAL
COMPRESSOR AND PSA ROOM
FLOOR AND PARTIAL ROOF PLANS
HEAT,VENTILATION AND DUCTWORK

CITY DRAWING NUMBER
SHEET OF
SEP-376