



PRIMARY CLARIFIER 1


PRIMARY CLARIFIER 2

GALLERY 3

GALLERY 4

PRIMARY CLARIFIER 3

PRIMARY SLUDGE GALLERY

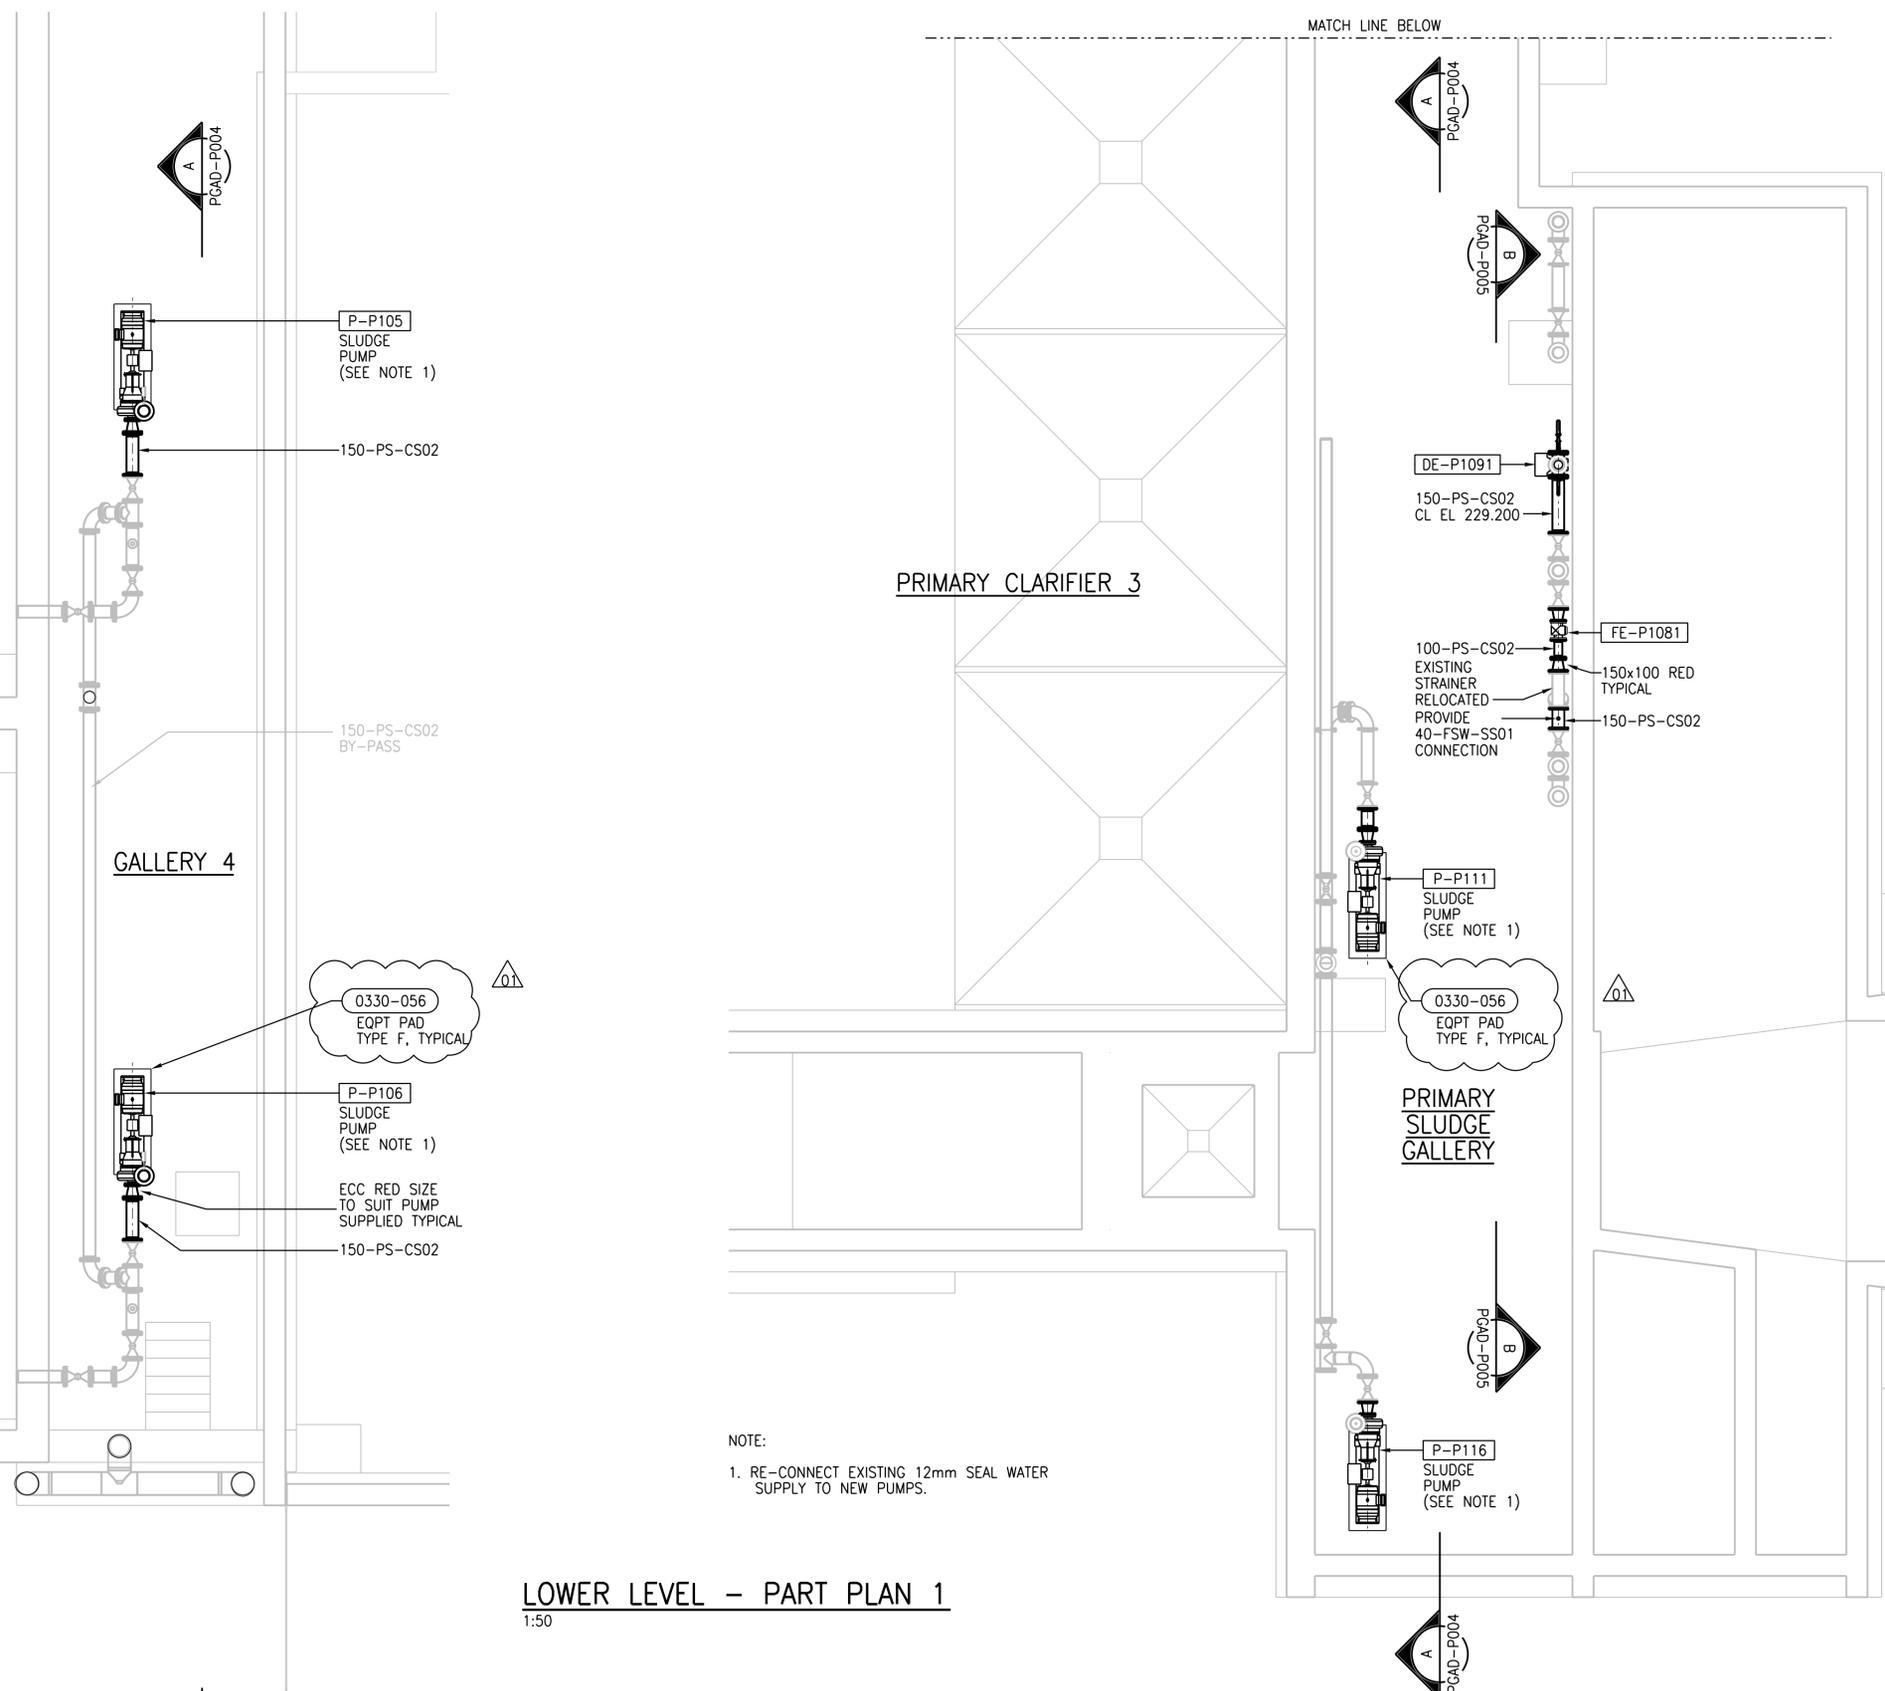

NOTE:  
1. RE-CONNECT EXISTING 12mm SEAL WATER SUPPLY TO NEW PUMPS.


**LOWER LEVEL - PART PLAN 1**

1:50



NO.	REVISIONS	DATE	DESIGN	CHECK
01	ISSUED FOR ADDENDUM 3 - 976-2016	2017/06/21	J.S.J.	J.C.
00	ISSUED FOR CONSTRUCTION - 976-2016	2017/04/05	D.G.	J.C.

<b>CH2MHILL</b>		ENGINEER'S SEAL	
SNC-LAVALIN		KGS GROUP	
DESIGNED BY: B. EDGAR	CHECKED BY: F. ABSI		
DRAWN BY: B. COOPER	APPROVED BY: H.T. FREIHAMMER		
SCALE: 1:50	ISSUED FOR CONSTRUCTION BY: J. SHUMKA		
DATE: 2017/04/05		DATE: 2017/04/05	
CONSULTANT NO.: 474248			

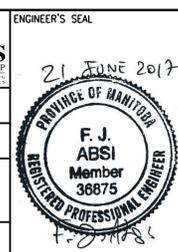

**THE CITY OF WINNIPEG**  
Winnipeg WATER AND WASTE DEPARTMENT

SOUTH END WATER POLLUTION CONTROL PLANT  
SEWPCC UPGRADE/EXPANSION PROJECT  
PROCESS  
PRIMARY CLARIFIERS  
LOWER LEVEL - PART PLAN 1

CITY DRAWING NUMBER: 1-0102-PGAD-P003 | SHEET: 001 | REV: 01 | SIZE: A1