


GROUND LEVEL PLAN
1:75

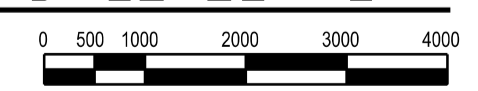

APEGM
Certificate of Authorization
CH2M HILL Canada Ltd.
No. 1441

NO.	REVISIONS	DATE	DESIGN	CHECK
01	ISSUED FOR ADDENDUM 4 - 976-2016	2017/06/30	K.F. J.C.	
00	ISSUED FOR CONSTRUCTION - 976-2016	2017/04/05	P.K. J.C.	

CH2MHILL	
DESIGNED BY: T. TRAN	CHECKED BY: D. CUDDINGTON
DRAWN BY: S. SUN	APPROVED BY: H.T. FRIEHAMMER
SCALE: 1:75	ISSUED FOR CONSTRUCTION BY: J. SHUMKA
DATE: 2017/04/05	DATE: 2017/04/05
CONSULTANT NO.: 474248	

ENGINEER'S SEAL

June 30, 2017

THE CITY OF WINNIPEG
Winnipeg WATER AND WASTE DEPARTMENT

SOUTH END WATER POLLUTION CONTROL CENTRE
SEWPC UPGRADING/EXPANSION PROJECT
MECHANICAL
GRIT AND SCREENING BUILDING
PLUMBING - GROUND FLOOR PLAN

CITY DRAWING NUMBER: 1-0102-MGAD-G513
SHEET: 001
REV: 01
SIZE: A1