


- NOTES:**
- FOR PIPE/DUCT PENETRATIONS SEE DETAILS 1,2,3,4 BDTL-A003
 - PATTERN/HATCHING OF WATER/LIQUID IS FOR CLARIFICATION PURPOSES ONLY TO INDICATE AND DIFFERENTIATE WATER/LIQUID CONTAINING STRUCTURES FROM REMAINDER OF BUILDING AREAS. IT DOES NOT REPRESENT ACTUAL LEVEL, VOLUME OR EXTENT OF WATER/LIQUID IN THESE AREAS. REFER TO PROCESS MECHANICAL FOR SUCH REQUIREMENTS.
 - DENOTES EXTENT OF FIRE RATED SEPARATION HR
 - DENOTES EXTENT OF FIRE WALL HR



BGAD-G021
BGAD-G022
BGAD-G023
BGAD-G024

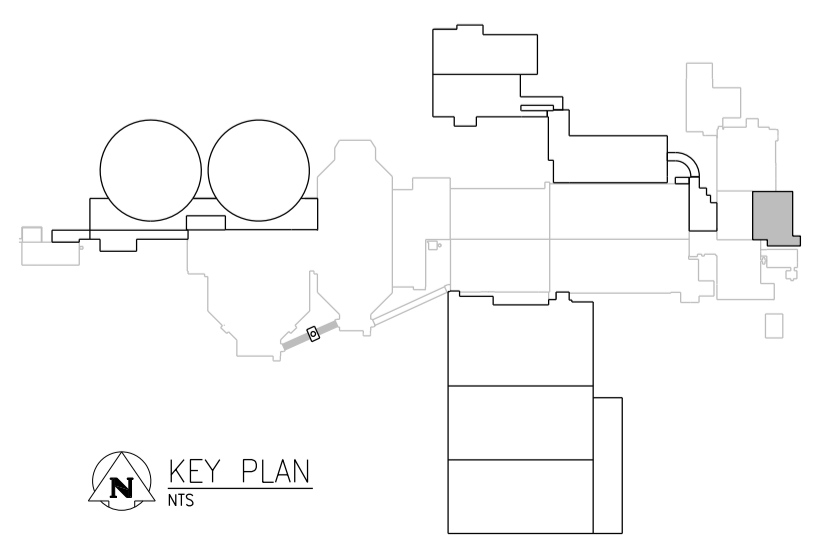


NO.	REVISIONS	DATE	DESIGN	CHECK
01	ISSUED FOR ADDENDUM 5 - 976-2016	2017/07/14	R.B.	J.C.
00	ISSUED FOR CONSTRUCTION - 976-2016	2017/04/05	J.L.	J.C.

CH2MHILL CANADA
Architects Inc.

DESIGNED BY: R. ZAKKO
DRAWN BY: J. LIN
SCALE: 1:50
DATE: 2017/04/05
CONSULTANT NO.: 474248

CHECKED BY: B. KOLIS-HUPA
APPROVED BY: H.T. FRIEHAMMER
ISSUED FOR CONSTRUCTION BY: J. SHUMKA
DATE: 2017/04/05

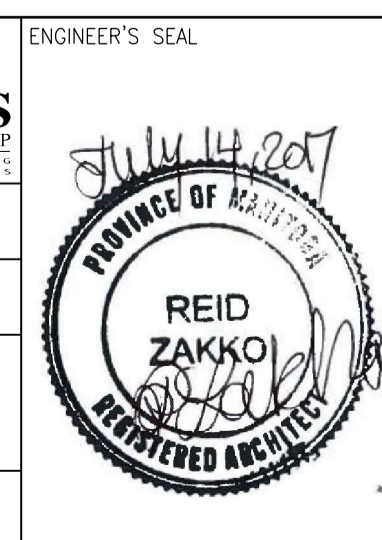

THE CITY OF WINNIPEG
Winnipeg
WATER AND WASTE DEPARTMENT

SOUTH END WATER POLLUTION CONTROL CENTRE
SEWPPC UPGRADING/EXPANSION PROJECT
BUILDING
GRIT AND SCREENINGS BUILDING
SECTION B

CITY DRAWING NUMBER: 1-0102-BGAD-G029
SHEET: 001
REV: 01
SIZE: A1