

- NOTES:**
- FOR NEW CONSTRUCTION SEE MECHANICAL HEADWORKS DRAWINGS.
  - REFER TO GENERAL DEMOLITION NOTES DRAWING 1-0102-DAAA-AD01.
  - CONFIRMED ASBESTOS CONTAINING MATERIAL IN EXTERIOR WALL PLASTER. REFER TO ASBESTOS ABATEMENT SPECIFICATIONS FOR ABATEMENT PROCEDURES.




SEALING ARCHITECT OR ENGINEER ACCEPTS RESPONSIBILITY ONLY FOR AREAS IDENTIFIED BY CLOUDING ON THIS DRAWING.

NOTE: THIS DRAWING SUPERSEDES DRAWING SEP-24



CH2MHILL CANADA Architects Inc.			
SNC-LAVALIN		KGS GROUP	
DESIGNED BY:	R. ZAKKO	CHECKED BY:	B. KOLIS-HUPA
DRAWN BY:	N. BOYCHUK	APPROVED BY:	R. ZAKKO
SCALE:	1:50	ISSUED FOR CONSTRUCTION BY:	J. SHUMKA
DATE:	2017/04/05	DATE:	2017/04/05
CONSULTANT NO.:	474248		
NO.	REVISIONS	DATE	DESIGN CHECK
03	ISSUED FOR ADDENDUM 7 - 976-2016	2017/07/20	JBC
02	ISSUED FOR CONSTRUCTION - 976-2016	2017/04/05	N.B. J.C.
01	ISSUED FOR CONSTRUCTION	10/2015	N.B. J.C.
00	ISSUED FOR TENDER	08/2015	N.B. J.C.

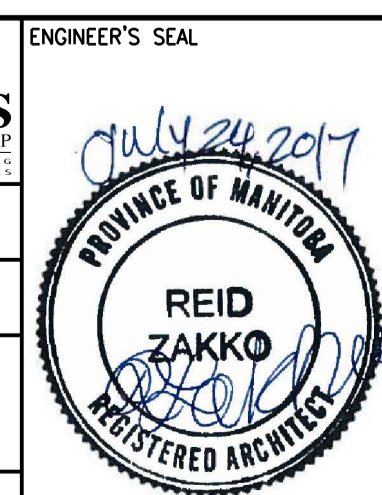

**THE CITY OF WINNIPEG**  
Winnipeg WATER AND WASTE DEPARTMENT

SOUTH END WATER POLLUTION CONTROL CENTRE  
SEWPC UPGRADING/EXPANSION PROJECT  
BUILDING  
GRIT BUILDING  
ELEVATIONS

CITY DRAWING NUMBER: 1-0102-BGAD-GD50 SHEET REV. SIZE: 03 A1