

REMOVE EXISTING TYNDALL STONE FACING, INSULATION AND ALL CAVITY WALL COMPONENTS. CLEAN EXISTING BACKUP WALL AS REQUIRED TO INSTALL AIR BARRIER, INSULATION AND STONE VENEER AS DETAILED.

REMOVE EXISTING TYNDALL STONE FACING, INSULATION AND ALL CAVITY WALL COMPONENTS. CLEAN EXISTING BACKUP WALL AS REQUIRED TO INSTALL AIR BARRIER, INSULATION AND STONE VENEER AS DETAILED.

NOTE 3.

REMOVE EXISTING TYNDALL STONE FACING, INSULATION AND ALL CAVITY WALL COMPONENTS. CUT BACK ALL MASONRY TIES FLUSH WITH EXISTING BACK UP.

NOTE 3.

REMOVE EXISTING METAL COPING FLASHING AND BUILT-UP WOOD COPING AS REQUIRED TO ACCOMMODATE WALL ASSEMBLY AS DETAILED.

REMOVE EXISTING CMU SUPPORTING TYNDALL STONE, INSULATION AND ALL CAVITY WALL COMPONENTS. CLEAN EXISTING BACKUP WALL AS REQUIRED TO INSTALL AIR BARRIER, INSULATION AND STONE VENEER AS DETAILED.

NOTE 3.

REMOVE EXISTING TYNDALL STONE FACING, INSULATION AND ALL CAVITY WALL COMPONENTS. CUT BACK ALL MASONRY TIES FLUSH WITH EXISTING BACK UP WALL.

NOTE 3.

STAINLESS STEEL SERVICE PLATFORM & LADDER LADDER RAILS 2" x 3/8" 16" CL RUNGS 3/4" x 12" @ 12" O.C. 6" FROM WALL HOOPS 2" x 1/4" @ 12" O.C. 25' HT. DIM. SLATS 1/4" x 3/4" 5 REG'S @ 20" O.C. MAX. WALL BRACKETS FOR LADDER 10" O.C. MAX. PLATFORM 3' O WIDE: BRACKETS 2" x 2" x 1/2" PLATEFORMS 35 KPA MET. (WELDED) OR EQUIV. 2" x 2" x 1/2" 150' O.C. RAILINGS 3/4" HIGH: RAILS 1 1/2" x 3/8" SS PIPE TOP & INTERMEDIATE RAILS 1 1/2" x 3/8" SS PIPE

- NOTES: 1. FOR NEW CONSTRUCTION SEE BUILDING HEADWORKS DRAWINGS. 2. REFER TO GENERAL DEMOLITION NOTES DRAWING 1-0102-DAAA-AD01. 3. CONFIRMED ASBESTOS CONTAINING MATERIALS IN EXTERIOR WALL PLASTER. REFER TO ASBESTOS ABATEMENT SPECIFICATIONS FOR ABATEMENT PROCEDURES.

SEALING ARCHITECT OR ENGINEER ACCEPTS RESPONSIBILITY ONLY FOR AREAS IDENTIFIED BY CLOUDING ON THIS DRAWING. NOTE: THIS DRAWING SUPERSEDES DRAWING SEP-20

PLAN, ELEVATIONS AND SECTION

NTS


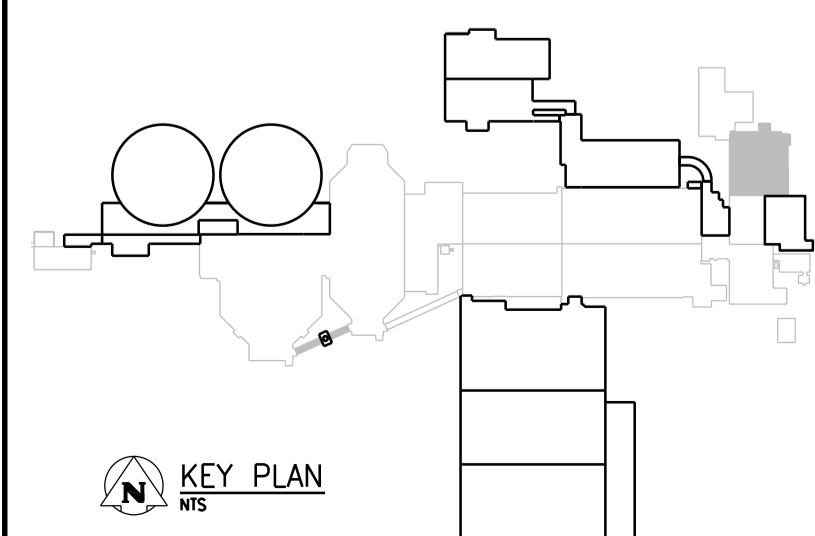


Table with columns for NO., REVISIONS, DATE, DESIGN, CHECK. Includes revision history for issued drawings.

Table with columns for CH2MHILL CANADA Architects Inc., SNC-LAVALLIN, DESIGNED BY, CHECKED BY, DRAWN BY, APPROVED BY, SCALE, DATE, ISSUED FOR CONSTRUCTION, CONSULTANT NO.

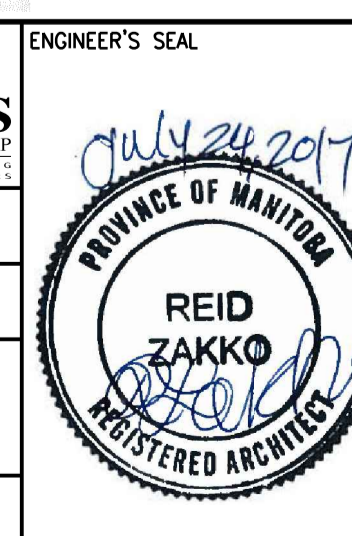

THE CITY OF WINNIPEG WATER AND WASTE DEPARTMENT SOUTH END WATER POLLUTION CONTROL CENTRE SEWPCC UPGRADING/EXPANSION PROJECT BUILDING PUMP AND SCREEN BUILDING GROUND FLOOR PLAN AND ELEVATIONS CITY DRAWING NUMBER 1-0102-BGAD-GD51 SHEET 01 SIZE A1