


- NOTES:**
- FOR NEW CONSTRUCTION SEE MECHANICAL HEADWORKS DRAWINGS.
 - REFER TO GENERAL DEMOLITION NOTES DRAWING 1-0102-DAAA-AD01.
 - REFER TO HVAC DEMOLITION NOTES DRAWING 1-0102-MCAD-GD50.


LEGEND:
 INDICATES DEMOLITION WORK

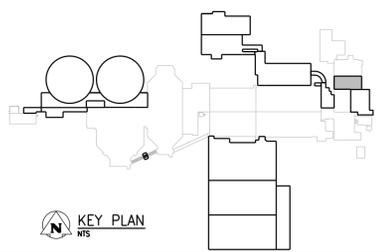

APEGM
 Certificate of Authorization
 CH2M HILL Canada Ltd.
 No. 1441

NO.	REVISIONS	DATE	DESIGN	CHECK
01	ISSUED FOR ADDENDUM 7 - 976-2016	2017/07/20	JBC	
00	ISSUED FOR CONSTRUCTION - 976-2016	2017/04/05	K.F. J.C.	

CH2MHILL		KCS GROUP	
DESIGNED BY: B. COOPER	CHECKED BY: R. BLACKWOOD	ISSUED FOR CONSTRUCTION BY: J. SHUMKA	DATE: 2017/04/05
DRAWN BY: B. COOPER	APPROVED BY: H.T. FREIHAMMER	DATE: 2017/04/05	CONSULTANT NO.: 474248
SCALE: AS SHOWN			

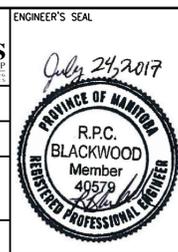

SEALING ARCHITECT OR ENGINEER ACCEPTS RESPONSIBILITY ONLY FOR AREAS IDENTIFIED BY CLOUDING ON THIS DRAWING.

NOTE: THIS DRAWING SUPERSEDES DRAWING SEP-213

THE CITY OF WINNIPEG
 WATER AND WASTE DEPARTMENT

SOUTH END WATER POLLUTION CONTROL CENTRE
 SEWPCC UPGRADING/EXPANSION PROJECT
 HEADWORKS
 PUMP AND SCREEN BUILDING
 VENTILATION FLOOR PLANS

CITY DRAWING NUMBER: 1-0102-MCAD-GD51 | SHEET: 01 | REV: 01 | SIZE: A1