


1 BASEMENT WASHROOM/LOCKERROOM PLAN ELEV 230 69m

NOTES :

1. ISOLATION VALVES PROVIDED AT ALL PIPING TIE-IN LOCATIONS.
2. ALL PIPING EXCEPT DRAINAGE WAS RUN IN CEILING SPACE OR AS INDICATED. SUPPLY PIPES DOWN FEED TO PLUMBING FIXTURES.
3. DRAINAGE LINE SLOPED AT 10mm PER METRE.
4. REFER TO SPECIFICATION FOR FIXTURE SUPPLY AND WASTE PIPE SIZES.
5. REFER TO DRAWING S102 FOR DRAINAGE ENCASMENT DETAIL.

LEGEND:

- XXXXXXXX INDICATES DEMOLITION WORK
- NOTES:
1. REFER TO DRAWINGS 1-0102-MGAD-M501 FOR NEW WORK.
 2. REFER TO GENERAL DEMOLITION NOTES DRAWING 1-0102-DAAA-ADD1.
 3. CONFIRMED ABESTOS CONTAINING MATERIALS IN HEATING WATER RETURN FITTINGS INSULATION. REFER TO ASBESTOS ABATEMENT SPECIFICATION FOR ABATEMENT PROCEDURES.

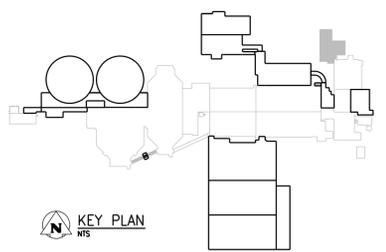

PLAN
NTS


APEGM
Certificate of Authorization
CH2M HILL Canada Ltd.
No. 1441

NO.	REVISIONS	DATE	DESIGN	CHECK
01	ISSUED FOR ADDENDUM 7 - 976-2016	2017/07/24	JBC	
00	ISSUED FOR CONSTRUCTION - 976-2016	2017/04/05	J.C.	J.C.

CH2MHILL
SNC-LAVALIN

DESIGNED BY: T. TRAN
DRAWN BY: K. FONG
SCALE: NTS
DATE: 2017/04/05
CONSULTANT NO.: 474248

CHECKED BY: D. CUDDINGTON
APPROVED BY: H.T. FREIHAMMER
ISSUED FOR CONSTRUCTION BY: J. SHUMKA
DATE: 2017/04/05

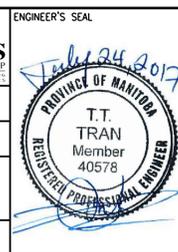

SEALING ARCHITECT OR ENGINEER ACCEPTS RESPONSIBILITY ONLY FOR AREAS IDENTIFIED BY CLOUDING ON THIS DRAWING.

NOTE: THIS DRAWING SUPERSEDES DRAWING SEP-210

THE CITY OF WINNIPEG
Winnipeg
WATER AND WASTE DEPARTMENT

SOUTH END WATER POLLUTION CONTROL CENTRE
SEWPCC UPGRADING/EXPANSION PROJECT
MECHANICAL
ADMINISTRATION BUILDING
LOCKER ROOM - DEMOLITION

CITY DRAWING NUMBER: 1-0102-MGAD-MD51
SHEET: 001
REV.: 01
SIZE: A1