



BASEMENT WASHROOM/LOCKERROOM PLAN ELEV. 230.69 m

REMOVE EXIST. WALL FIN RAD AND CAP OFF PIPES ABOVE CEILING  
NOTE 3

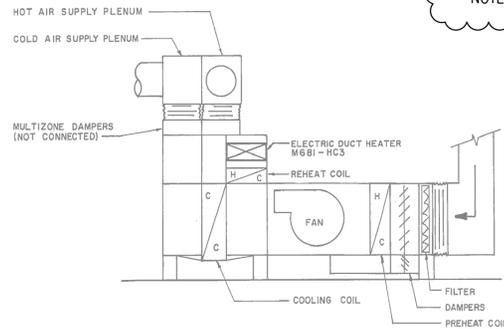

AIR HANDLING UNIT M681-F81 ELEVATION  
N.T.S.

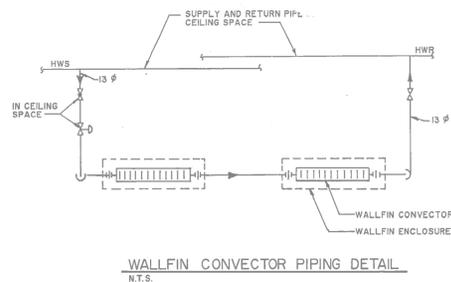

WALLFIN CONVECTOR PIPING DETAIL  
N.T.S.


LEGEND:

INDICATES DEMOLITION WORK

NOTES:

- REFER TO DRAWINGS 1-0102-MGAD-M601 FOR NEW WORK.
- REFER TO GENERAL DEMOLITION NOTES DRAWING 1-0102-DAAA-AD01.
- CONFIRMED ABESTOS CONTAINING MATERIALS IN HEATING WATER RETURN FITTINGS INSULATION. REFER TO ASBESTOS ABATEMENT SPECIFICATION FOR ABATEMENT PROCEDURES.
- CONFIRMED ABESTOS CONTAINING MATERIALS IN AIR HANDLING UNIT. REFER TO ASBESTOS ABATEMENT SPECIFICATION FOR ABATEMENT PROCEDURES.

PLAN AND SECTIONS  
NTS

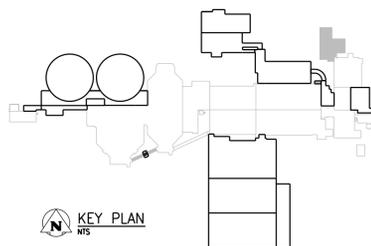

KEY PLAN  
NTS

**APEGM**  
Certificate of Authorization  
CH2M HILL Canada Ltd.  
No. 1441

NO.	REVISIONS	DATE	DESIGN	CHECK
01	ISSUED FOR ADDENDUM 7 - 976-2016	2017/07/24	JBC	
00	ISSUED FOR CONSTRUCTION - 976-2016	2017/04/05	J.C.	J.C.

<b>CH2MHILL</b>		<b>KGS GROUP</b>	
DESIGNED BY: T. TRAN	CHECKED BY: D. CUDDINGTON	ENGINEER'S SEAL	
DRAWN BY: K. FONG	APPROVED BY: H.T. FREIHAMMER		
SCALE: NTS	ISSUED FOR CONSTRUCTION BY: J. SHUMKA		
DATE: 2017/04/05	DATE: 2017/04/05	CONSULTANT NO.: 474248	

SEALING ARCHITECT OR ENGINEER ACCEPTS RESPONSIBILITY ONLY FOR AREAS IDENTIFIED BY CLOUDING ON THIS DRAWING.

NOTE: THIS DRAWING SUPERSEDES DRAWING SEP-209

**THE CITY OF WINNIPEG**  
WATER AND WASTE DEPARTMENT

SOUTH END WATER POLLUTION CONTROL CENTRE  
SEWPCC UPGRADING/EXPANSION PROJECT  
MECHANICAL  
ADMINISTRATION BUILDING  
LOCKER ROOM - DEMOLITION

CITY DRAWING NUMBER 1-0102-MGAD-MD53	SHEET 001	REV. 01	SIZE A1
---	--------------	------------	------------