




1 PLAN AT ELEV. 774'-0"

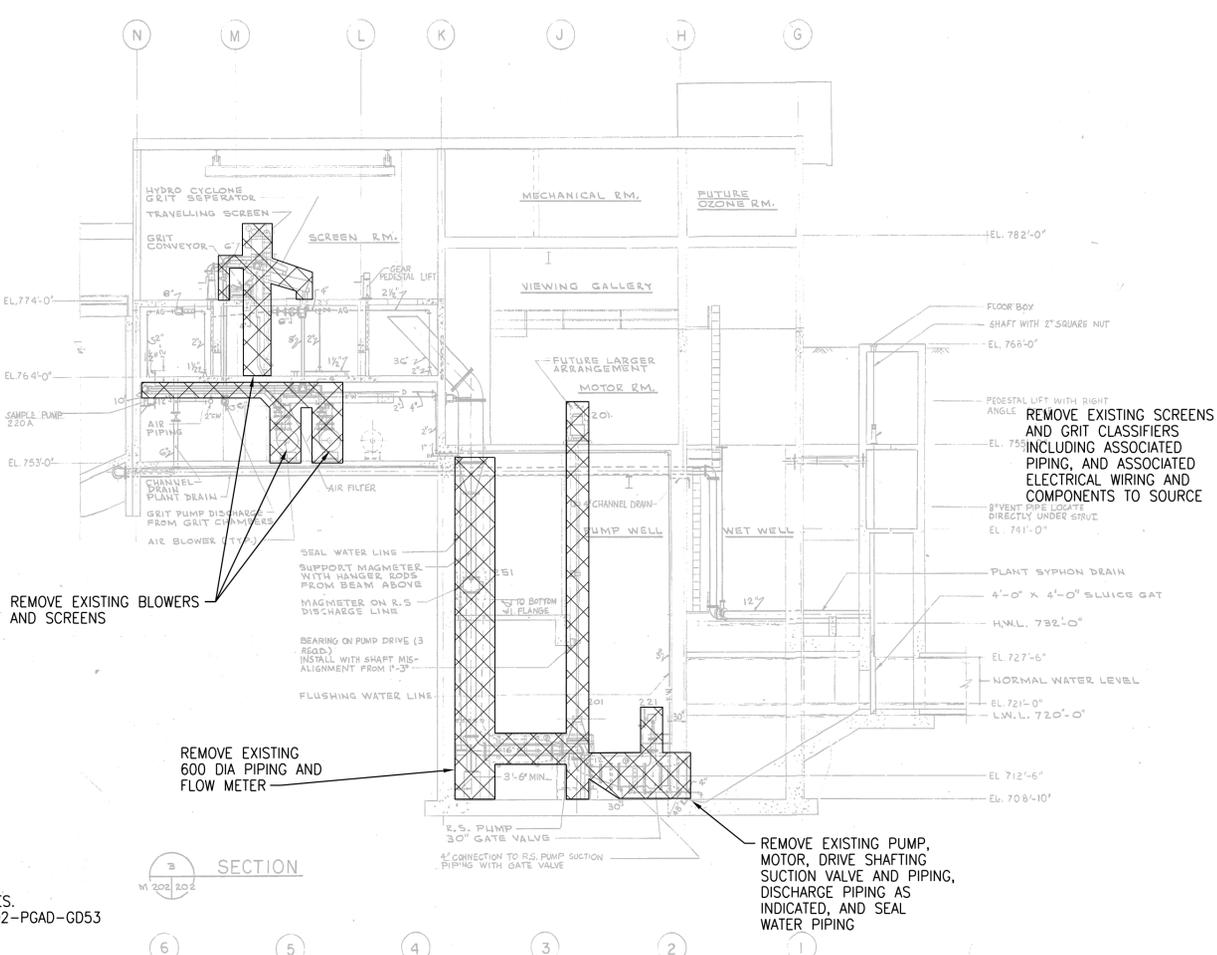

3 SECTION

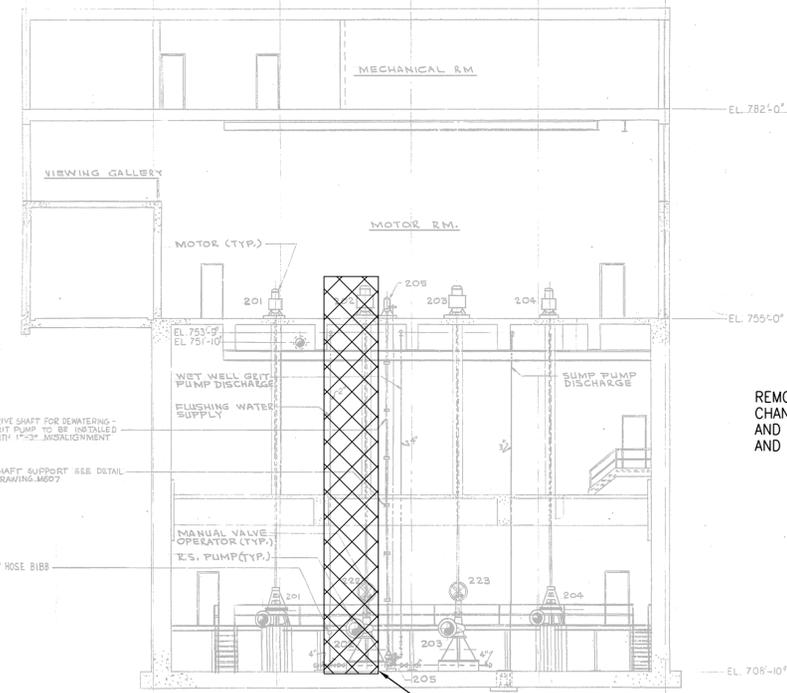

2 SECTION

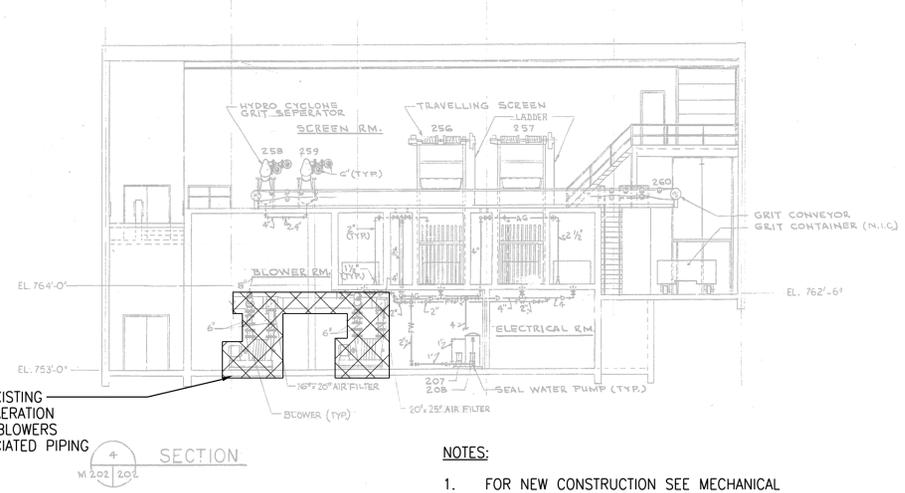

4 SECTION




1 PHOTO
NTS



2 PHOTO
NTS

PLANS AND SECTIONS
NTS

- NOTES:**
- FOR NEW CONSTRUCTION SEE MECHANICAL HEADWORKS DRAWINGS.
 - REFER TO GENERAL DEMOLITION NOTES DRAWING 1-0102-DAAA-ADD1.
 - CONFIRMED ASBESTOS CONTAINING MATERIAL ON HEATING WATER RETURN FITTINGS INSULATION. REFER TO ASBESTOS ABATEMENT SPECIFICATION FOR ABATEMENT PROCEDURES.
 - CONFIRMED ASBESTOS CONTAINING MATERIAL ON DUCTWORK INSULATION. REFER TO ASBESTOS ABATEMENT SPECIFICATION FOR ABATEMENT PROCEDURES.

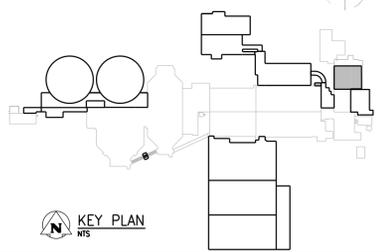

APEGM
Certificate of Authorization
CH2M HILL Canada Ltd.
No. 1441

NO.	REVISIONS	DATE	DESIGN	CHECK
01	ISSUED FOR ADDENDUM 7 - 976-2016	2017/07/20	JBC	
00	ISSUED FOR CONSTRUCTION - 976-2016	2017/04/05	B.C.	J.C.

CH2MHILL.
SNC-LAVALIN

DESIGNED BY: B. EDGAR
CHECKED BY: F. ABSI

DRAWN BY: B. COOPER
APPROVED BY: H.T. FREIHAMMER

SCALE: NTS
ISSUED FOR CONSTRUCTION BY: J. SHUMKA
DATE: 2017/04/05
DATE: 2017/04/05

CONSULTANT NO.: 474248

ENGINEER'S SEAL

24 July 2017

F. J. ABSI
Member
36875
REGISTERED PROFESSIONAL ENGINEER

SEALING ARCHITECT OR ENGINEER ACCEPTS RESPONSIBILITY ONLY FOR AREAS IDENTIFIED BY CLOUDING ON THIS DRAWING.

NOTE: THIS DRAWING SUPERSEDES DRAWING SEP-40

THE CITY OF WINNIPEG
Winnipeg
WATER AND WASTE DEPARTMENT

SOUTH END WATER POLLUTION CONTROL CENTRE
SEWPCC UPGRADING/EXPANSION PROJECT
HEADWORKS - PUMP AND SCREEN BUILDING
PROCESS EQUIPMENT AND PIPING
PLANS AND SECTIONS

CITY DRAWING NUMBER: 1-0102-PGAD-GD51
SHEET: 01
REV.:
SIZE: A1