


- NOTES:**
- FOR NEW CONSTRUCTION SEE STRUCTURAL PRIMARY SLUDGE FERMENTERS/THICKENERS DRAWINGS.
 - REFER TO GENERAL DEMOLITION NOTES DRAWING 1-0102-DAAA-AD01.

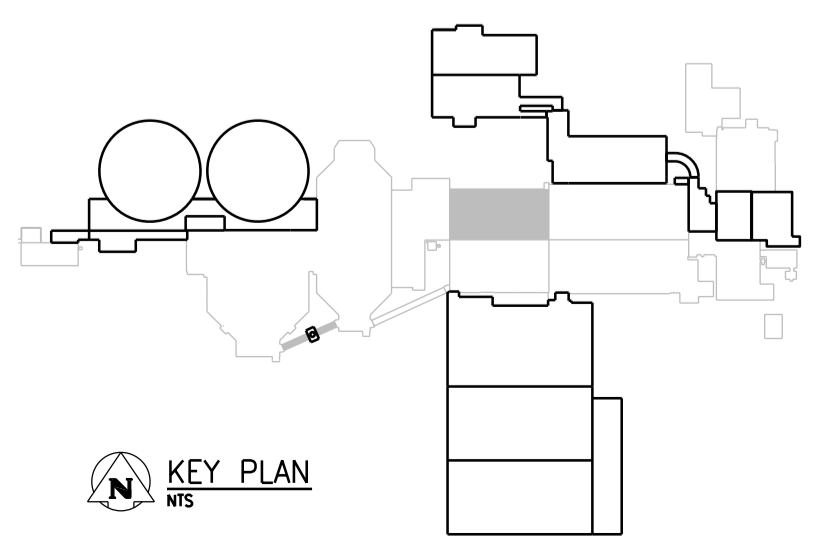

APEGM
 Certificate of Authorization
 CH2M HILL Canada Ltd.
 No. 1441

NO.	REVISIONS	DATE	DESIGN	CHECK
01	ISSUED FOR ADDENDUM 7 - 976-2016	2017/07/20	JBC	
00	ISSUED FOR CONSTRUCTION - 976-2016	2017/04/05	G.O.	J.C.

CH2MHILL.		ENGINEER'S SEAL	
SNC-LAVALIN		KCS GROUP	
DESIGNED BY: E. LUI	CHECKED BY: R. PARIKH		
DRAWN BY: G. OMORI	APPROVED BY: H.T. FREIHAMMER		
SCALE: NTS	ISSUED FOR CONSTRUCTION BY: J. SHUMKA		
DATE: 2017/04/05	DATE: 2017/04/05		
CONSULTANT NO.: 474248			

SEALING ARCHITECT OR ENGINEER ACCEPTS RESPONSIBILITY ONLY FOR AREAS IDENTIFIED BY CLOUDING ON THIS DRAWING.
 NOTE: THIS DRAWING SUPERSEDES DRAWING SEP-68

THE CITY OF WINNIPEG
 WATER AND WASTE DEPARTMENT

SOUTH END WATER POLLUTION CONTROL CENTRE
 SEWPCC UPGRADING/EXPANSION PROJECT
 STRUCTURAL
 OXYGEN REACTORS NO. 1 AND NO. 2
 SECTIONS

CITY DRAWING NUMBER: 1-0102-SGAD-DD51
 SHEET: 01
 REV: A1
 SIZE: A1