


MARK	B & D	REINFORCING	REMARKS
B201	18x24	2-#9 TOP 2-#9 BOTM #3@12% #3@12% #3@12%	
B202	12x24	3-#6 TOP 3-#6 BOTM #3@12% #3@12%	
B203	12x24	SAME AS B202	
B204	24x30	5-#9 TOP 5-#9 BOTM #3@12% #3@12%	
B205	12x36	2-#8 TOP 2-#8 BOTM #3@12% #3@12%	
B201	12x18	2-#9 TOP 2-#9 BOTM #3@12% #3@12%	
B202	12x24	2-#8 TOP 2-#8 BOTM	STIRRUPS WIDTH 1" TO ALLOW FOR WATERSTOP
B203	18x24	3-#8 TOP 2-#8 BOTM #3@12% #3@12%	

MARK	B & D	REINFORCING	REMARKS
B401	12x24	2-#8 TOP 2-#8 BOTM #3@12% #3@12%	
B402	12x24	2-#6 TOP 2-#6 BOTM #3@12% #3@12%	
B403	9/12x30	2-#8 TOP 2-#8 BOTM #3@12% #3@12%	REINFORCING FOR 6" WIDE BEAM
B404	12x30	3-#8 TOP 3-#8 BOTM #3@12% #3@12%	
B405	12x30	2-#8 TOP 2-#8 BOTM #3@12% #3@12%	
B406	12x18	2-#8 TOP 2-#8 BOTM #3@12% #3@12%	
B407	3x36	2-#8 TOP 4-#4 MID-DEPTH 2-#8 BOTM #3@12% #3@12%	REINFORCING AS PER ANCHOR WIDE BEAM
B408	12x24	3-#8 TOP 3-#8 BOTM #3@12% #3@12%	

NOTE:

- REFER TO GENERAL DEMOLITION NOTES DRAWING 1-0102-DAAA-ADD1.
- CONFIRMED ASBESTOS CONTAINING MATERIALS IN EXTERIOR WALL PLASTER. REFER TO ASBESTOS ABATEMENT SPECIFICATION FOR ABATEMENT PROCEDURES.
- COORDINATE DEMOLITION REQUIREMENTS WITH NEW CONSTRUCTION.

PLAN AT EL. 232.867
NTS

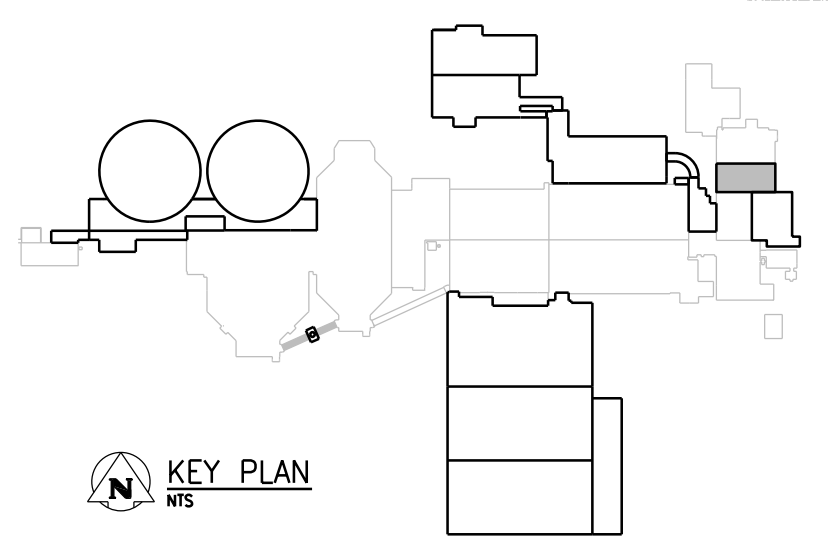

NO.	REVISIONS	DATE	DESIGN	CHECK
01	ISSUED FOR ADDENDUM 7 - 976-2016	2017/07/24	JBC	
00	ISSUED FOR CONSTRUCTION - 976-2016	2017/04/05	G.O. J.C.	

CH2MHILL
SNC-LAVALIN


DESIGNED BY: E. LUI
CHECKED BY: R. PARIKH

DRAWN BY: G. OMORI
APPROVED BY: H.T. FREIHAMMER

SCALE: NTS
ISSUED FOR CONSTRUCTION

DATE: 2017/04/05
BY: J. SHUMKA
DATE: 2017/04/05

CONSULTANT NO.: 474248

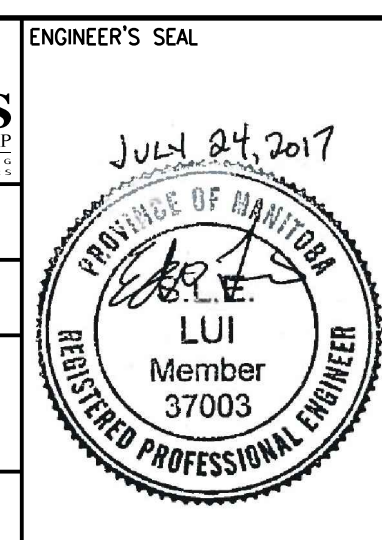

SEALING ARCHITECT OR ENGINEER ACCEPTS RESPONSIBILITY ONLY FOR AREAS IDENTIFIED BY CLOUDING ON THIS DRAWING.

NOTE: THIS DRAWING SUPERSEDES DRAWING SEP-26

THE CITY OF WINNIPEG
WATER AND WASTE DEPARTMENT

SOUTH END WATER POLLUTION CONTROL CENTRE
SEWPCC UPGRADING/EXPANSION PROJECT
STRUCTURAL
PUMP AND SCREEN BUILDING
SECTIONS AND DETAILS

CITY DRAWING NUMBER: 1-0102-SGAD-GD51
SHEET: 001
REV: 01
SIZE: A1