




CONTRACTOR TO CONFIRM ALL DIMENSIONS AND REPORT ANY DISCREPANCIES TO CONTRACT ADMINISTRATOR PRIOR TO CONSTRUCTION. LOCATION OF UNDERGROUND STRUCTURES AS SHOWN ARE BASED ON THE BEST INFORMATION AVAILABLE BUT NO GUARANTEE IS GIVEN THAT ALL EXISTING UTILITIES ARE SHOWN OR THAT THE GIVEN LOCATIONS ARE EXACT. CONFIRMATION OF EXISTENCE AND EXACT LOCATION OF ALL SERVICES MUST BE OBTAINED FROM THE INDIVIDUAL UTILITIES BEFORE PROCEEDING WITH CONSTRUCTION.

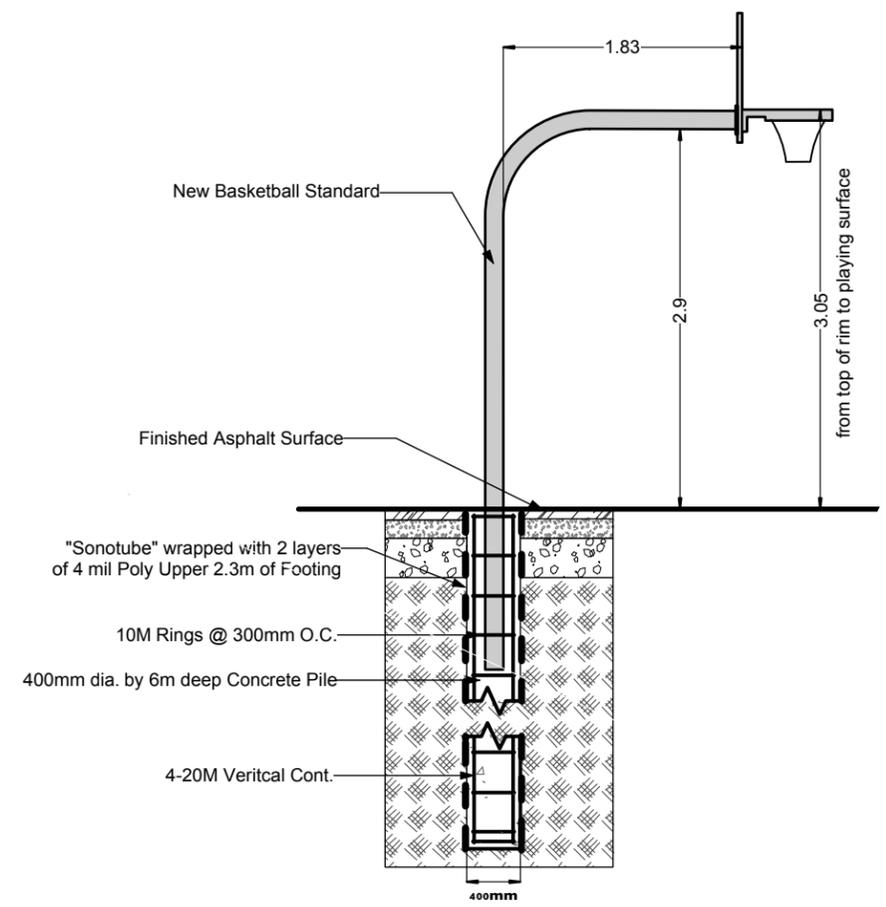

1 BASKETBALL STANDARD AND PILE
 W.20-7 NTS

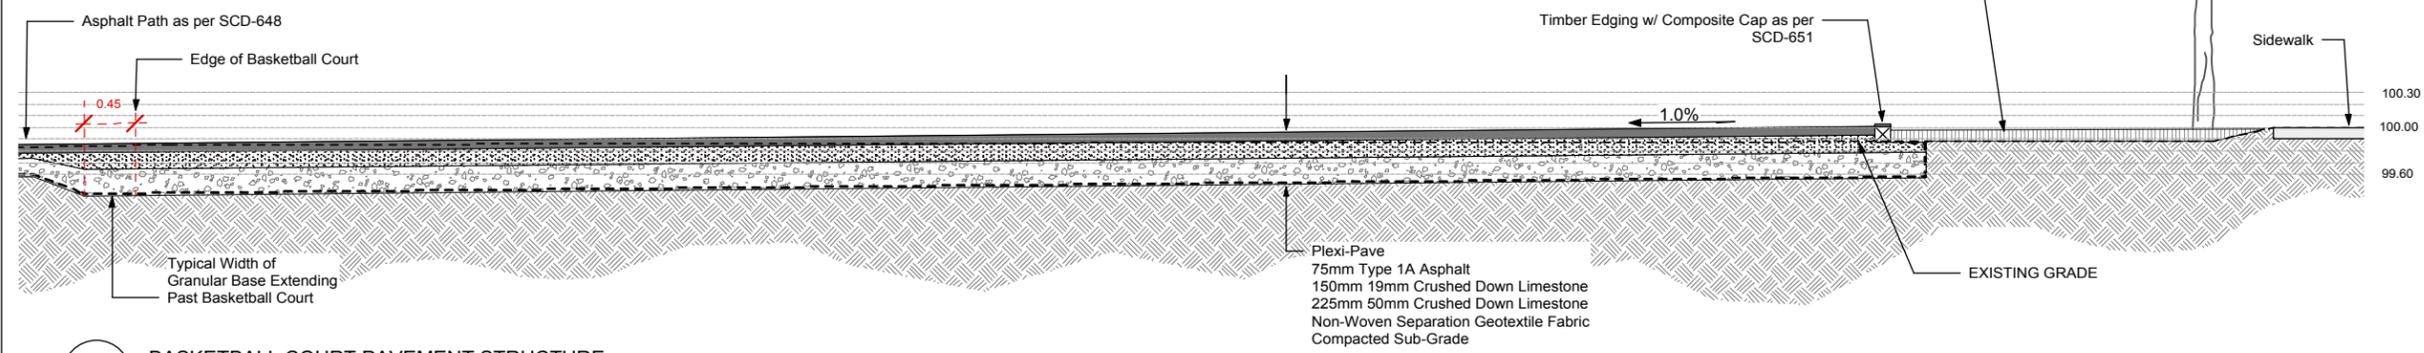

2 BASKETBALL COURT PAVEMENT STRUCTURE
 W.20-7 NTS

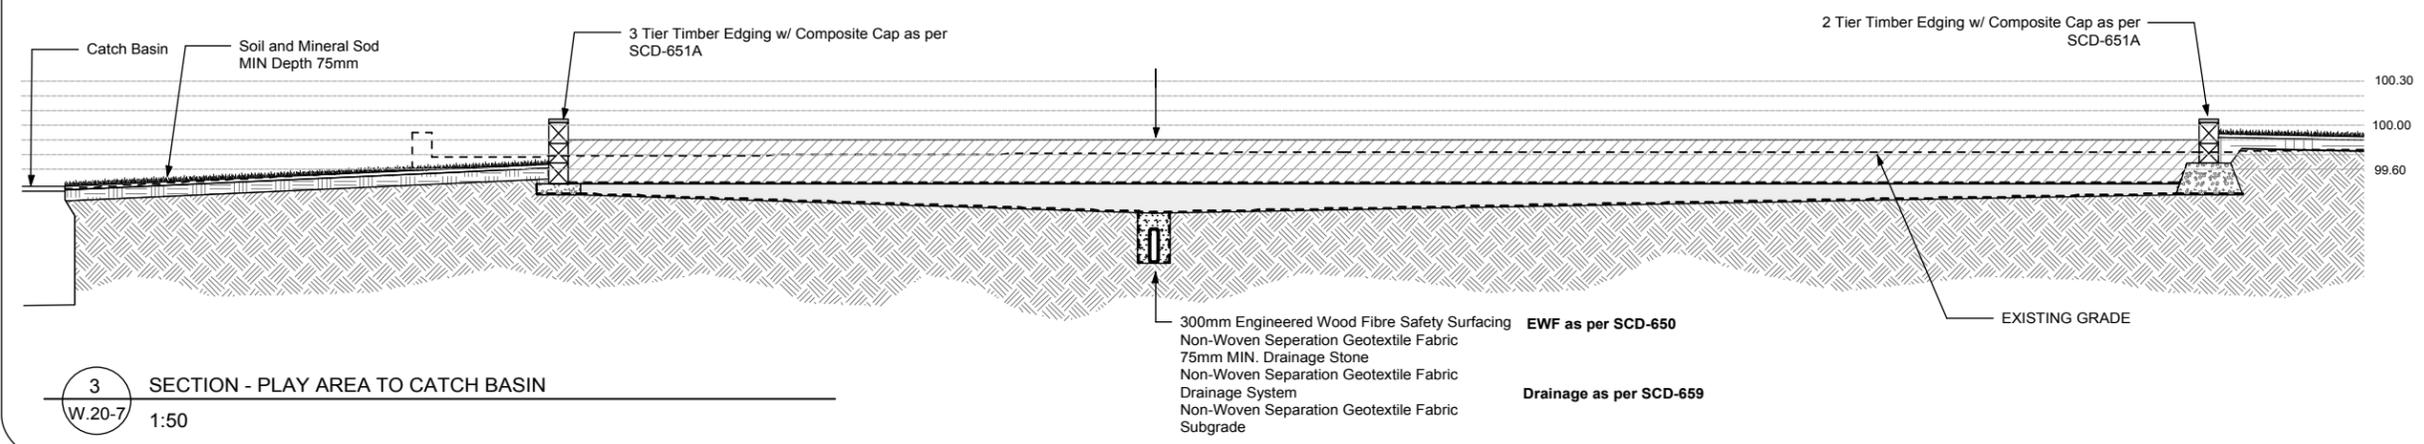

3 SECTION - PLAY AREA TO CATCH BASIN
 W.20-7 1:50



DESIGNED BY	IL	CHECKED BY	
DRAWN BY	IL	APPROVED BY	
HORIZ. SCALE	AS INDICATED		
VERT. SCALE	AS INDICATED		
DATE	MARCH 2017		
MANAGER, PARK AND OPEN SPACES		DATE	
MANAGER, URBAN DESIGN DIVISION		DATE	
DRAWING TITLE Weston Park Playground DETAILS			
SITE ADDRESS	DRAWING NO.		
299 Lock Street	W.20-7-R1		
	BID OPPORTUNITY NO.		
	153-2017		