


No.	Date	Revision Notes
1.	2017.05.02	Issued for Construction
2.	2017.06.01	Issued for Add#01E
3.	2017.06.06	Issued for Add#03ME



- NOTES:**
- DISCONNECT AND REMOVE THE EXISTING LUMINAIRE AND ALL WIRING AND CONDUIT.
 - DISCONNECT AND REMOVE ALL RECEPTACLES THAT WERE PART OF THE ORIGINAL BUILDING CONSTRUCTION AND PROVIDE BLANK COVER PLATE.
 - DISCONNECT AND REMOVE NEWER ELECTRICAL DEVICES AND ALL WIRING AND CONDUIT.
 - EXISTING ELECTRICAL DEVICE SHALL REMAIN AND BE MAINTAINED.
 - DISCONNECT AND REMOVE ALL EXISTING ELECTRICAL IN CHECK OUT DESK.
 - MOUNTED ON CEILING IN LIBRARY IN MEZZANINE.
 - DISCONNECT EXISTING MECHANICAL EQUIPMENT AND REMOVE ALL WIRING AND CONDUIT.
 - DISCONNECT AND REPLACE WITH NEW 120/208V, 3Φ, 4W PANEL.
 - EXISTING SECURITY PANEL SHALL REMAIN AND BE MAINTAINED PROVIDE INTERCONNECTION TO
 - EXISTING VIFOND FIRE ALARM PANEL SHALL REMAIN AND BE MAINTAINED.
 - EXISTING EXTERIOR LUMINAIRE SHALL REMAIN AND BE MAINTAINED.

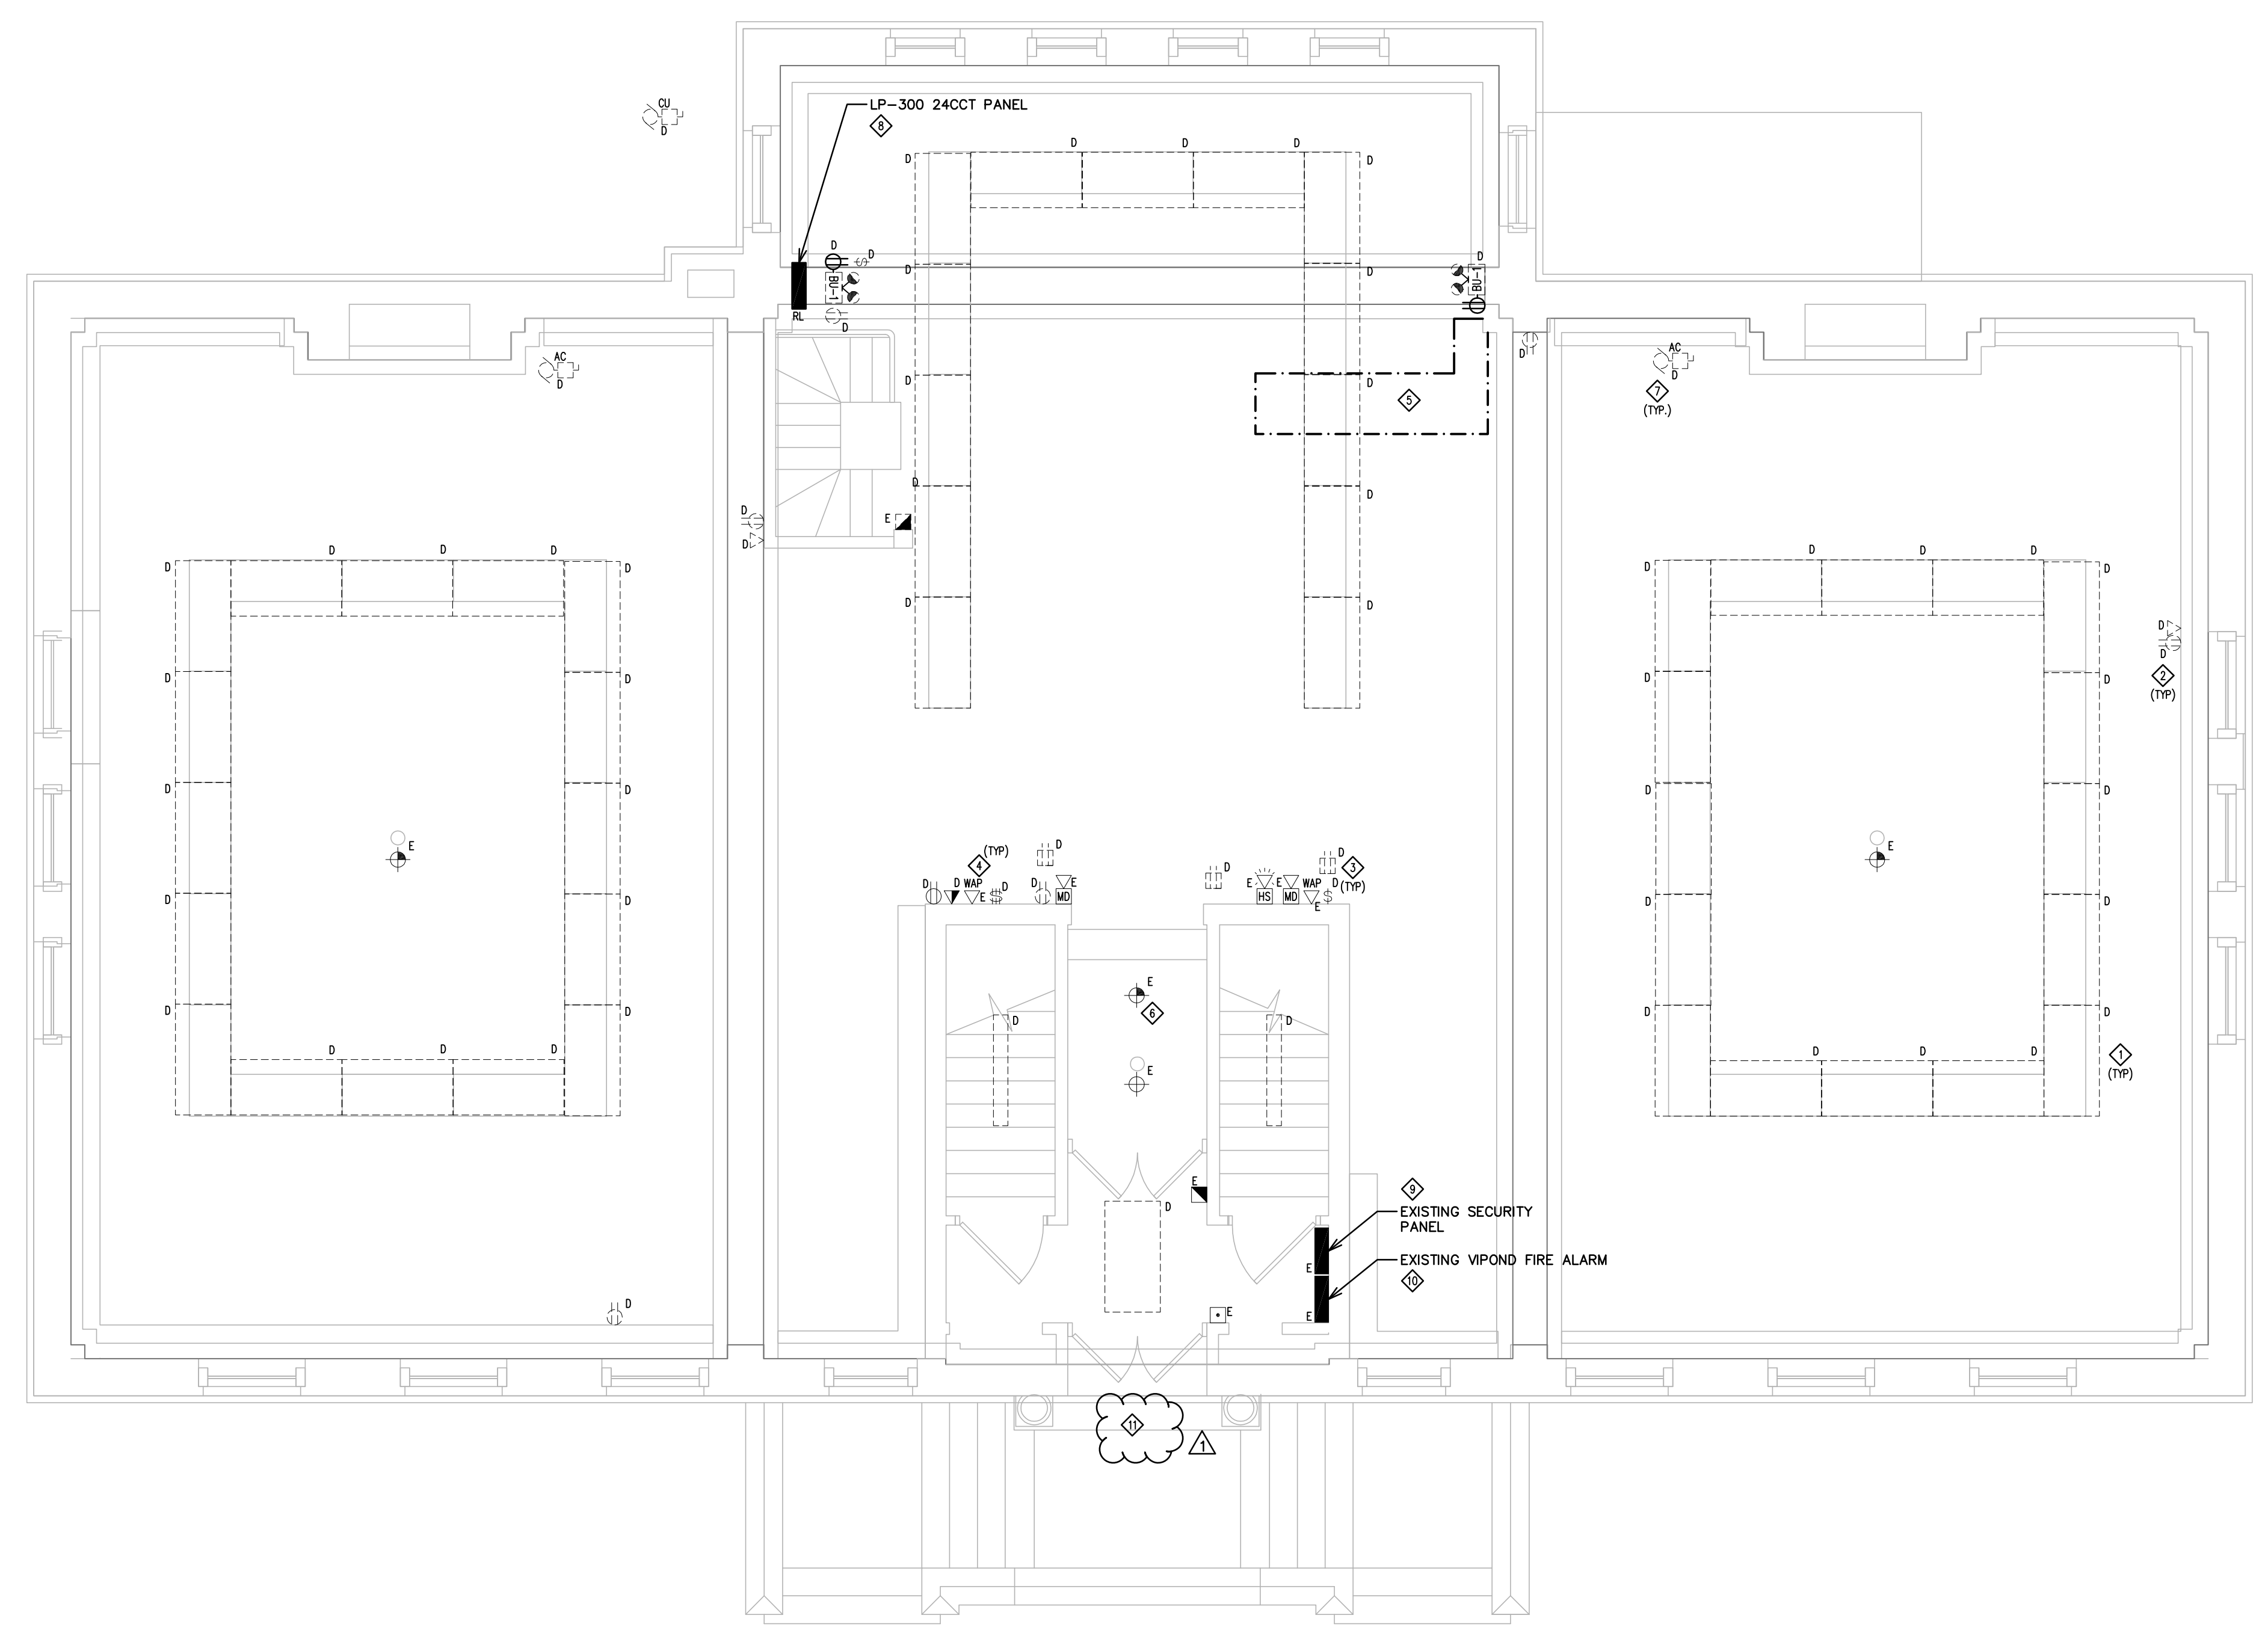

1 MAIN FLOOR - ELECTRICAL DEMOLITION LAYOUT
ED21 SCALE: 1:50

This drawing must not be scaled. The contractors shall verify all dimensions and other data on site prior to commencement of work. Discrepancies, errors, and omissions are to be reported to the Architect prior to proceeding with the Work.

Drawings and specifications as instruments of service are the property of the Architect; the copyright in the same being reserved to him.

No reproduction or revision to these drawings may be made without the permission of the Architect and when made, must bear his name. All prints to be returned to the Architect upon request.

Project
St. John's Library Renovation

Drawing
MAIN LEVEL - DEMOLITION ELECTRICAL

Drawn By: RK Reviewed By: DG
Scale: 1:50 Drawing No. ED2.1R1

Date: 2017.05.02 Project No. 1503b Revision No. 0