



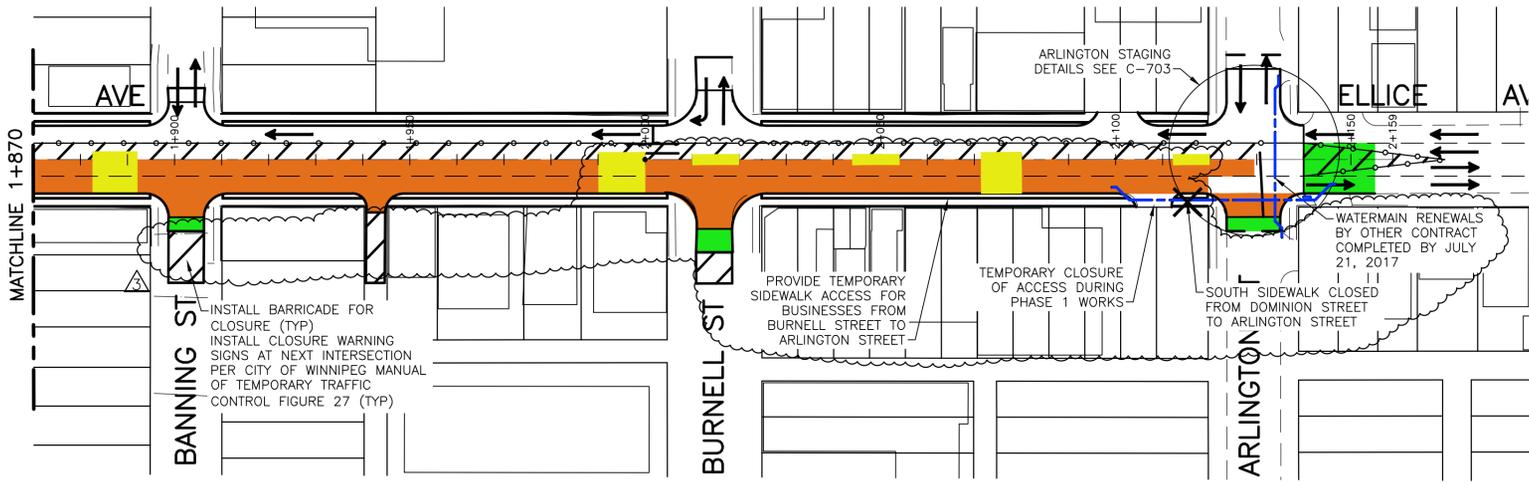

PHASE 1 - JULY 26th TO SEPTEMBER 6th

SCALE 1:750

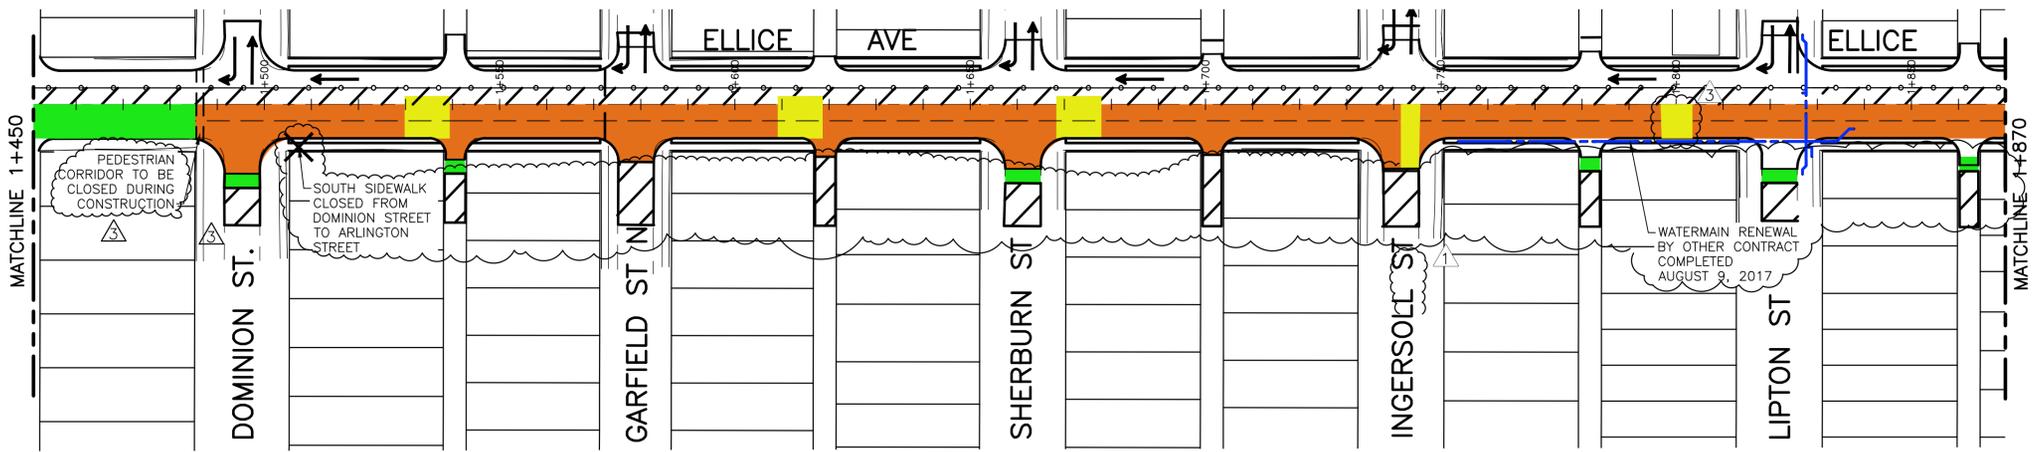

TRAFFIC CONTROL NOTES:

- LANE CLOSURES & RESTRICTIONS**
 - MIDDLE WB LANE & EB LANES CLOSED FOR CONSTRUCTION FROM ERIN ST. TO ARLINGTON ST., MAINTAIN ONE WB LANE.
 - MAINTAIN ACCESS TO SIDE STREETS AND BACK LANES BETWEEN ERIN ST. AND DOMINION ST. EXCLUDING DOMINION ST.
 - CLOSE SIDE STREET AND BACK LANE ACCESS TO ELLICE AVE. S. SIDE FROM DOMINION ST. TO ARLINGTON FOR PHASE 1 CONSTRUCTION.
 - TRAFFIC PLAN TO BE SUBMITTED AND APPROVED PRIOR TO SET UP OF TRAFFIC CONTROL.
 - ALL TRAFFIC CONTROL PROVIDED BY THE CONTRACTOR IN ACCORDANCE WITH CITY OF WINNIPEG MANUAL OF TEMPORARY TRAFFIC CONTROL.
- PEDESTRIAN TRAFFIC**
 - MAINTAIN SIDEWALKS ON ELLICE AVE. DURING CONSTRUCTION.
 - MAINTAIN ONE N-S PEDESTRIAN CROSSING AT ALL UNSIGNALIZED INTERSECTIONS AND BOTH CROSSINGS ON SIGNALIZED INTERSECTIONS.
 - REQUIRED CLOSURES FOR SIDEWALK CONSTRUCTION TO BE COORDINATED BY THE CONTRACTOR AND APPROVED BY CONTRACT ADMINISTRATOR.
- TRANSIT**
 - MAINTAIN BUS STOPS FOR DIRECTION OF TRAFFIC.
- PARKING / LOADING**
 - PARKING / LOADING RESTRICTIONS TO BE IN PLACE FOR DURATION OF STAGE
 - RESTRICTION SIGNAGE TO BE PLACED BY TRAFFIC SERVICES.

PHASE 1 MAIN CONSTRUCTION ACTIVITIES:

- STAGE 1 - JULY 26th TO AUGUST 25th:**
- ELLICE COMBINED SEWER REPAIRS/LINING - ON CENTERLINE ELLICE AVE
 - CATCH BASIN SEWER SERVICE & DRAINAGE INLET RENEWALS ON EB LANES
 - COMBINED SEWER CONNECTION STUBS FOR PROPOSED CB SEWER SERVICE RENEWALS ON WB LANES
 - WM RENEWALS (OTHER CONTRACT)


- STAGE 2 - JULY 27th TO SEPTEMBER 6th:**
- CONCRETE PAVEMENT RECONSTRUCTION EB LANES - DOMINION ST. TO ARLINGTON ST.
 - ASPHALT REHABILITATION/CONSTRUCTION - EB LANES - FROM ERIN ST. TO DOMINION ST.
 - NEW SOUTH SIDEWALK CONSTRUCTION - DOMINION ST. TO ARLINGTON ST.

**ENGINEERS
GEOSCIENTISTS
MANITOBA**
Certificate of Authorization
Stantec Consulting Ltd.
No. 1301

METRIC
WHOLE NUMBERS INDICATE MILLIMETRES
DECIMALIZED NUMBERS INDICATE METRES

WARNING
IF POWER EQUIPMENT OR EXPLOSIVES ARE TO BE USED FOR EXCAVATION ON THIS PROJECT THE CONTRACTOR MUST:
1. NOTIFY THE GAS COMPANY OF THE PROPOSED LOCATION OF EXCAVATION.
2. TAKE PRECAUTION TO AVOID DAMAGE TO GAS COMPANY INSTALLATIONS SEE PROVINCIAL REGULATION 210/72 FOR DETAILS.
3. OBTAIN EXCAVATION PERMITS PRIOR TO CONSTRUCTION.

GENERAL NOTES:
1. TRAFFIC CONTROL PROVIDED AND MAINTAINED BY CONTRACTOR IN ACCORDANCE WITH CITY OF WINNIPEG MANUAL OF TEMPORARY TRAFFIC CONTROL ON CITY STREETS AND TRAFFIC CONTROL SPECIFICATION.
2. CONTRACTOR TO SCHEDULE TRAFFIC CONTROL MEETING WITH CONTRACT ADMINISTRATOR & CITY TRAFFIC SERVICES 48 HOURS IN ADVANCE OF COMMENCING SET UP.
3. WORKS IN CLOSE PROXIMITY TO THE 400 AC WM TO BE IN COMPLIANCE TO THE CONTRACT SPECIFICATIONS.

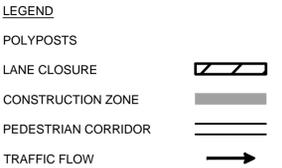

LOCATION APPROVED UNDERGROUND STRUCTURES

SUPV. U/G STRUCTURES COMMITTEE	DATE

NOTE:
LOCATION OF UNDERGROUND STRUCTURES AS SHOWN ARE BASED ON THE BEST INFORMATION AVAILABLE BUT NO GUARANTEE IS GIVEN THAT ALL EXISTING UTILITIES ARE SHOWN OR THAT THE GIVEN LOCATIONS ARE EXACT. CONFIRMATION OF EXISTENCE AND EXACT LOCATION OF ALL SERVICES MUST BE OBTAINED FROM THE INDIVIDUAL UTILITIES BEFORE PROCEEDING WITH CONSTRUCTION.

NO.	REVISIONS	DATE	BY
3	ISSUED FOR ADDENDUM 3	17.06.26	
2	ISSUED FOR ADDENDUM 1	17.06.20	
1	ISSUED FOR TENDER	17.06.12	
0	ISSUED FOR REVIEW	17.05.30	

Stantec
500 - 311 Portage Avenue, Winnipeg MB Canada
www.stantec.com

DESIGNED BY: D.L.	CHECKED BY: D.J.M.
DRAWN BY: G.P.	APPROVED BY: S.B.C.
HOR. SCALE: 1:750	RELEASED FOR CONSTRUCTION:
VERTICAL:	DATE: 2017.05.18

ENGINEER'S SEAL

CONSULTANT DRAWING NO.
C701

THE CITY OF WINNIPEG
PUBLIC WORKS DEPARTMENT
ENGINEERING DIVISION

2017 REGIONAL STREET RENEWAL PROGRAM
ELLICE AVENUE
ERIN STREET TO ARLINGTON STREET
TRAFFIC CONTROL / STAGING

SHEET 17 OF 20
CAD FILE DRAWING NUMBER 07271c-701-xxx.dwg
CITY DRAWING NUMBER P-3485-17

V:\1137\active\113707271\0300_drawing\0302_sheet_files\02_civil\07271c-701-xxx.dwg