


CONTROL GEOMETRY PLAN
 SCALE: 1:200

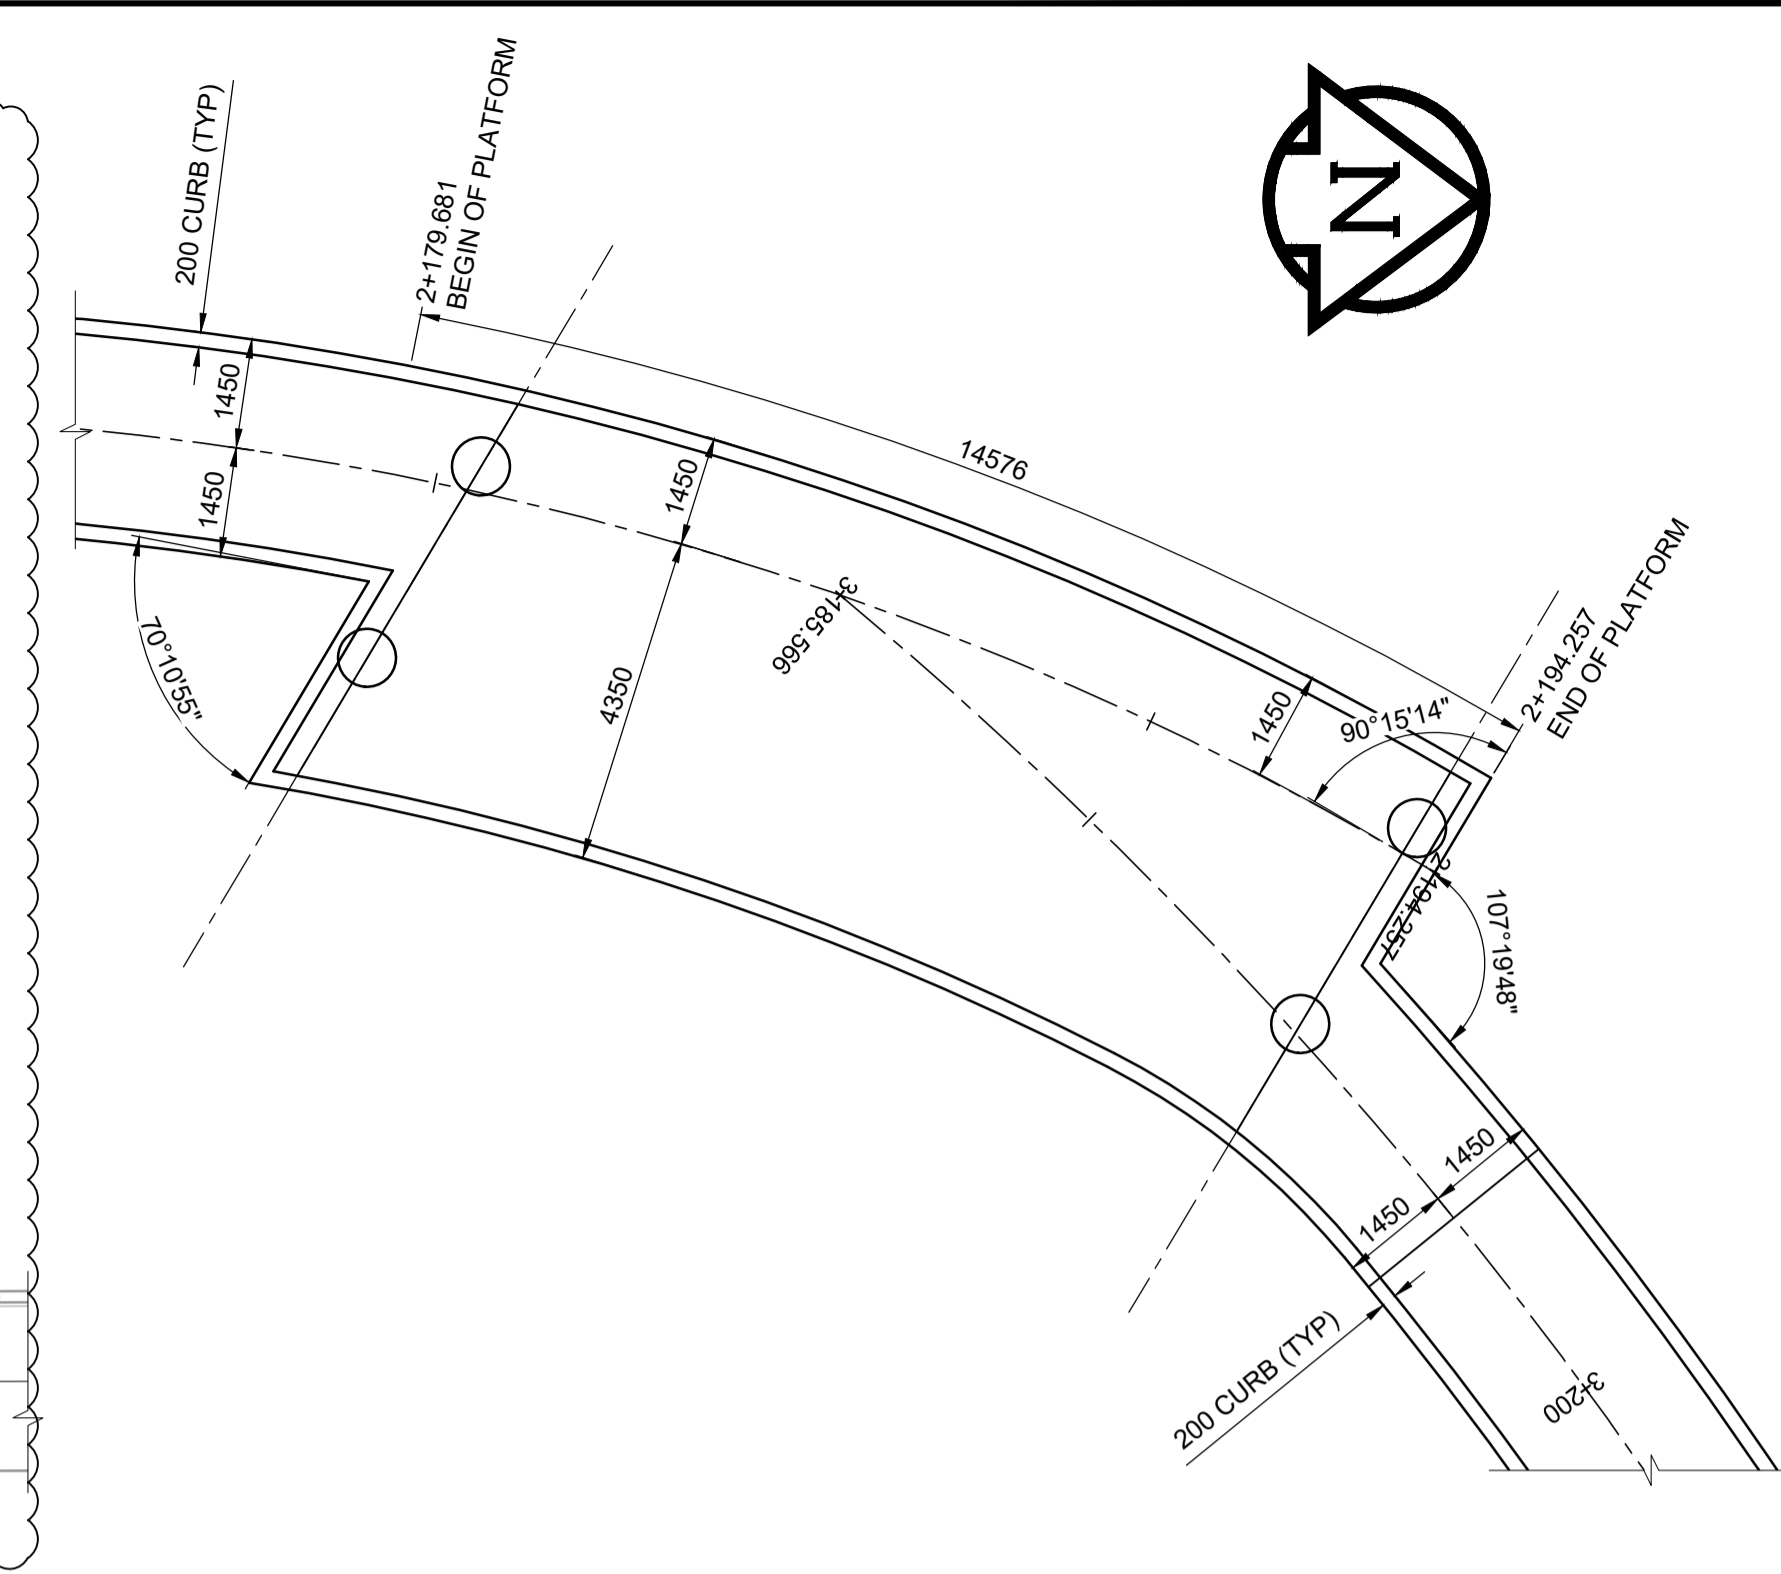

LOOKOUT PLATFORM CONTROL GEOMETRY
 SCALE: 1:100

ID	CENTRE POINT		RADIUS TO BRIDGE CONTROL LINE	RADIUS TO W DECK EDGE	RADIUS TO E DECK EDGE
	NORTHING	EASTING			
ARC 1	9733.4461	9945.6832	60.000	58.550	61.450
ARC 2	9800.3403	10024.0378	43.000	44.450	41.550
ARC 3	9776.5150	10031.4172	60.000	61.450	58.550
ARC 4	9755.3437	10005.4478	NA	N/A	2.200
ARC 5	9811.3304	9997.5795	N/A	N/A	10.000
ARC 6	9824.3343	9999.3966	N/A	N/A	1.000
ARC 7	9832.5480	9993.8699	N/A	6.000	N/A

POINT	STATION	DESCRIPTION
1	2+100.000	BC ARC 1
2	2+142.923	EC ARC 1
3	2+145.223	BC ARC 2
4	2+194.257	EC ARC 2

POINT	STATION	DESCRIPTION
1	3+185.566	BC ARC 3
2	3+215.171	EC ARC 3

BRIDGE CONTROL LINE (BCL) OR ARC	STATION	O/S FROM CONTROL LINE	DESCRIPTION
BCL 1	2+112.960	-1450	BC
BCL 1	2+142.923	-1450	EC / BT
BCL 1	2+145.223	-1450	ET / BC
BCL 1	2+194.257	-1450	EC/KINK
SEE PLAN / BCL 2	3+193.998	SEE PLAN / -1450	KINK/BC
BCL 2 / ARC 7	3+207.502	-1450 / ON ARC 7	EC/BC
ARC 7	3+211.587		EC

BRIDGE CONTROL LINE (BCL) OR ARC	STATION	O/S FROM CONTROL LINE	DESCRIPTION
ARC 4	2+120.999	O ARC 4	BC
ARC 4 / BCL 1	2+122.924	1450	BCEC / BT
BCL 1	2+142.923	1450	EC / BT
BCL 1	2+145.223	1450	ET / BC
BCL 1 / SEE PLAN	2+179.387	1450 / SEE PLAN	EC / KINK
SEE PLAN / BCL 1	2+178.220	SEE PLAN / 4350	KINK / BC
ARC 5	2+191.578	ON ARC 5	EC / BC
ARC 5 / BCL 2	3+196.635	1450	EC / BC
BCL 2 / ARC 6	3+207.502	1450	EC / BC
ARC 6	3+208.423		EC



METRIC
 WHOLE NUMBERS INDICATE MILLIMETRES
 DECIMALIZED NUMBERS INDICATE METRES

LOCATION APPROVED
 UNDERGROUND STRUCTURES

SUPR. U/G STRUCTURES DATE

NOTE:
 LOCATION OF UNDERGROUND STRUCTURES AS SHOWN ARE BASED ON THE BEST INFORMATION AVAILABLE BUT NO GUARANTEE IS GIVEN THAT ALL EXISTING UTILITIES ARE SHOWN OR THAT THE GIVEN LOCATIONS ARE EXACT. CONFIRMATION OF EXISTENCE AND EXACT LOCATION OF ALL SERVICES MUST BE OBTAINED FROM THE INDIVIDUAL UTILITIES BEFORE PROCEEDING WITH CONSTRUCTION.

No.	REVISIONS	DATE	BY
1	ISSUED FOR ADDENDUM 1	17/10/27	DAN
0	ISSUED FOR TENDER	17/10/13	DAN

MORRISON HERSHFIELD

DESIGNED BY: DAN
 CHECKED BY: AF
 DRAWN BY: AH
 APPROVED BY: BE

HOR SCALE: AS SHOWN
 VERT SCALE: AS SHOWN

DATE: 17/10/13

RELEASED FOR CONSTRUCTION

PROFESSIONAL'S SEAL

PROVINCE OF MANITOBA

D.A. NEILSON
 Member
 37248

REGISTERED PROFESSIONAL ENGINEER

CONSULTANT FILE NAME
 5170563 - DD03 - CG.dwg

BID OPPORTUNITY No. 754-2017

THE CITY OF WINNIPEG
 PUBLIC WORKS DEPARTMENT
 ENGINEERING DIVISION

TACHE PROMENADE TREETOP LOOKOUT

CONTROL GEOMETRY

CITY DRAWING NUMBER: B250-17-29
 SHEET 29 OF 70
 DRAWING No. REV 03 1