


PLAN
SCALE: 1:250

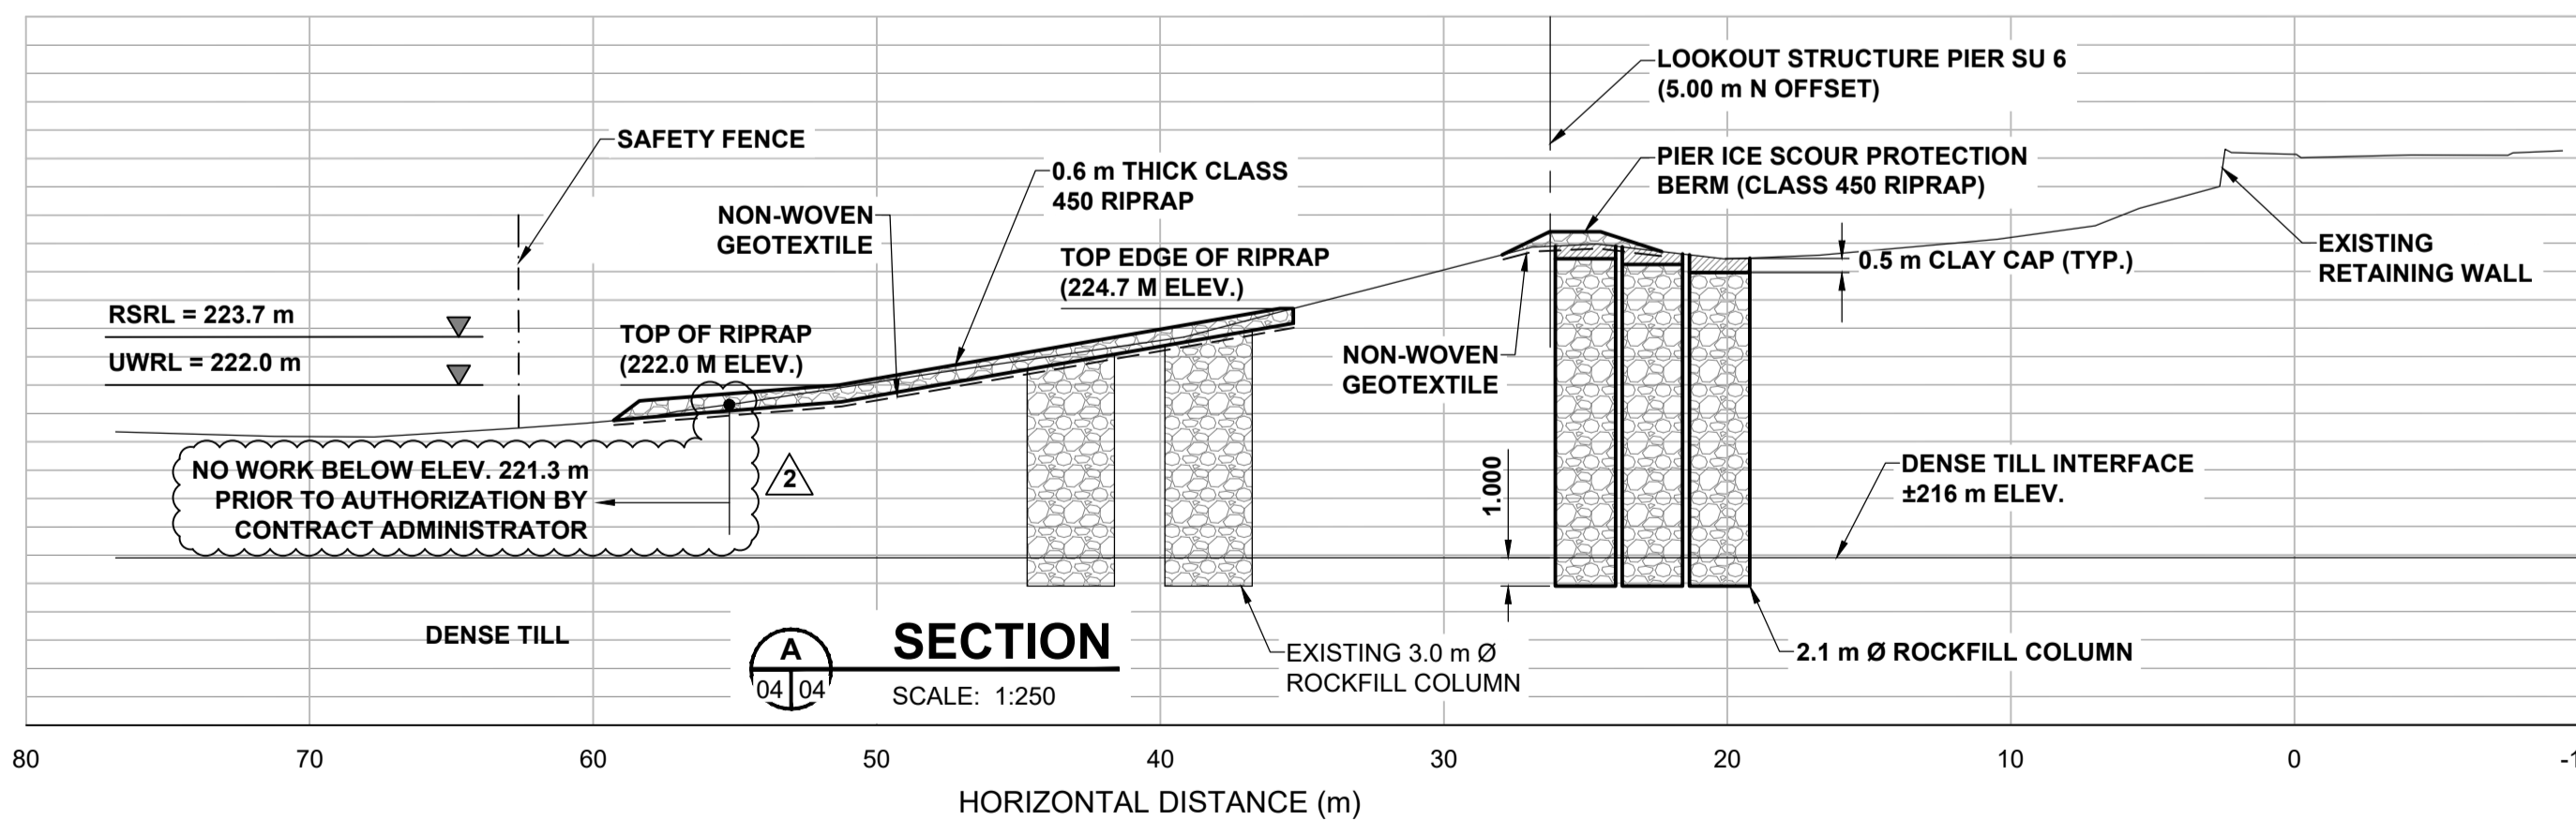

SECTION
SCALE: 1:250

- NOTES:**
1. RSRL = REGULATED SUMMER RIVER LEVEL = 223.7 m
 2. UWRL = UNREGULATED WINTER RIVER LEVEL = 222.0 m
 3. ROCKFILL COLUMN COORDINATES TO BE PROVIDED TO CONTRACTOR DURING CONSTRUCTION.
 4. ROCKFILL COLUMN LOCATIONS TO BE ADJUSTED DURING CONSTRUCTION TO AVOID CONFLICTS WITH PIER FOUNDATION PILES AND MINIMIZE TREE REMOVALS.

METRIC
WHOLE NUMBERS INDICATE MILLIMETRES
DECIMALIZED NUMBERS INDICATE METRES

---	GAS	○	MANHOLE	●	CONCRETE PAVEMENT	■	LOCATION APPROVED
⊕	MTS HANDWELL/PEDESTAL	□	CATCH BASIN/CATCH PIT	■	CONC SIDEWALK/MEDIAN	■	UNDERGROUND STRUCTURES
⊕	HYDRO HANDWELL/CABINET	△	CURB INLET WITH BOX	▲	ASPHALT PAVEMENT	■	
---	CATV/FIBRE OPTIC	○	TREE	▲	PAVING STONE	■	
⊕	TRAFFIC SIGNALS/PIT	⊕	TEST HOLE	⊕	GRAVEL	■	
---	LAND DRAINAGE SEWER	⊕	PROPERTY LINE	⊕	RAMP CURB	■	
---	SANITARY/COMBINED SEWER	⊕	SURVEY BAR	⊕	PLANING/REMOVAL	■	
---	CB LEAD/SSP/DCP	⊕	FENCE	⊕		■	
---	WATERMAIN	⊕	BOC/EDGE OF PAVEMENT	⊕		■	
---	SUBDRAIN	33.000	ELEVATION	(33.333)		■	
---	DITCH	---	TRAFFIC SIGN	---		■	

LOCATION APPROVED
UNDERGROUND STRUCTURES

SUPR. U/G STRUCTURES COMMITTEE DATE

NOTE:
LOCATION OF UNDERGROUND STRUCTURES AS SHOWN ARE BASED ON THE BEST INFORMATION AVAILABLE BUT NO GUARANTEE IS GIVEN THAT ALL EXISTING UTILITIES ARE SHOWN OR THAT THE GIVEN LOCATIONS ARE EXACT. CONFIRMATION OF EXISTENCE AND EXACT LOCATION OF ALL SERVICES MUST BE OBTAINED FROM THE INDIVIDUAL UTILITIES BEFORE PROCEEDING WITH CONSTRUCTION.

1	ISSUED FOR ADDENDUM 2	17/11/08	JGK
0	ISSUED FOR TENDER	17/10/13	JGK
No.	REVISIONS	YY/MM/DD	BY

DESIGNED BY	MVH	CHECKED BY	KMS
DRAWN BY	KMB	APPROVED BY	BWB
RELEASED FOR CONSTRUCTION			
DATE	17/10/13	DATE	



THE CITY OF WINNIPEG
PUBLIC WORKS DEPARTMENT
ENGINEERING DIVISION

TACHE PROMENADE

TACHE AVENUE STABILIZATION WORKS
PLAN & SECTION
RUE DESPINS TO STA 0+860

CITY DRAWING NUMBER: B250-17-12
SHEET 12 OF 70
DRAWING No. REV: 04 1

CONSULTANT FILE NAME: 5170563-Tache-SW-04.dwg



BID OPPORTUNITY No. 754-2017

MATCH LINE - STA 0+860 - SEE SHT No. 13

