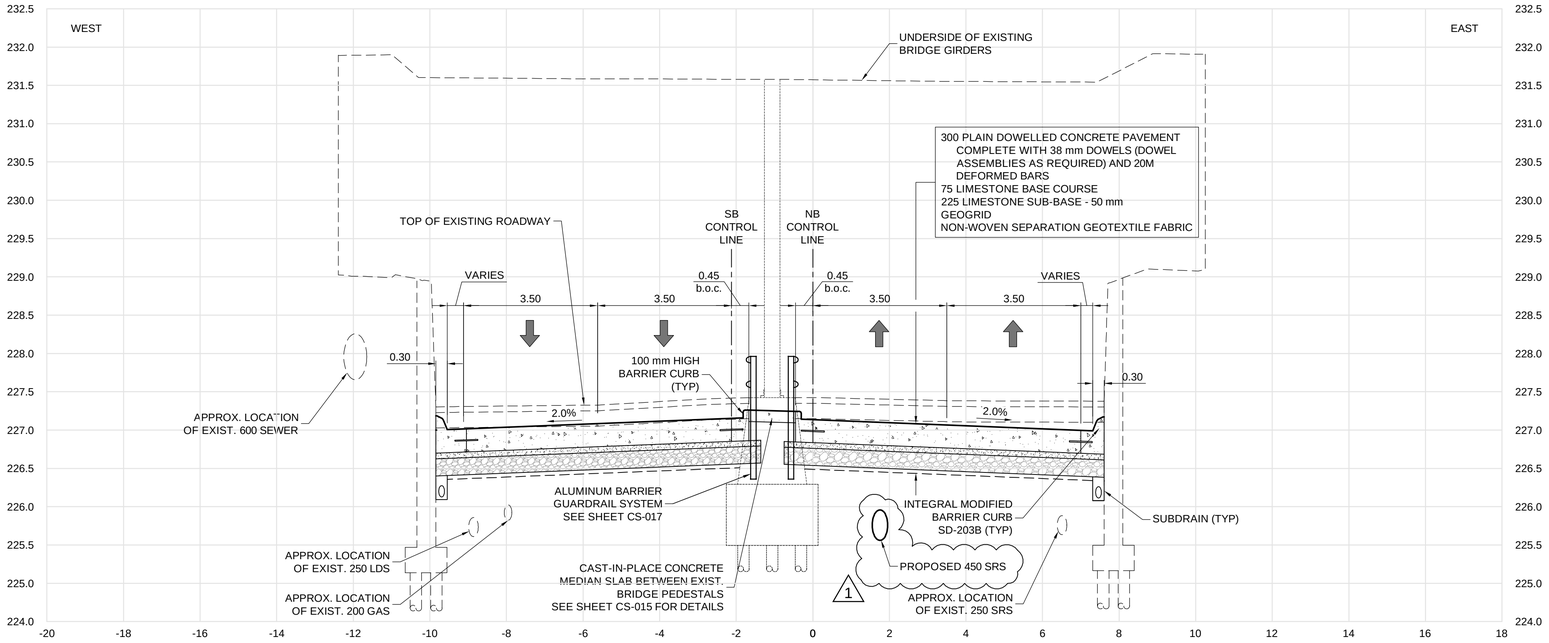

F CT-CT-007/020 SECTION - STA. 0+500

SCALE: H = 1:80, V = 1:40

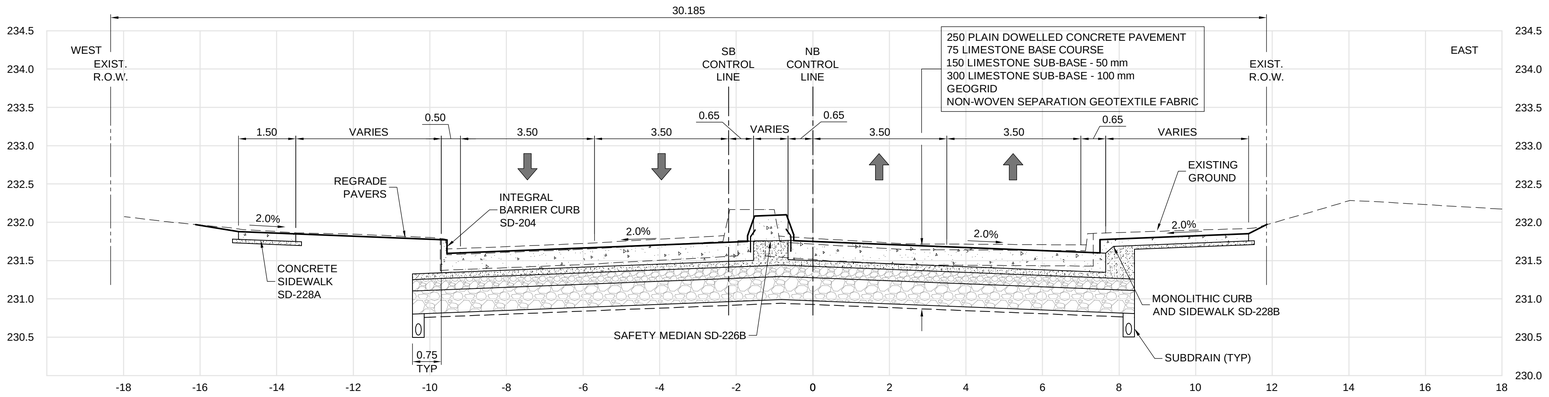

G CT-CT-010/020 SECTION - STA. 0+620

SCALE: H = 1:80, V = 1:40

APEGM
Certificate of Authorization
Dillon Consulting Limited (MB)
No. 1789 Date: 18/03/16

UNDERGROUND STRUCTURES

SUPV. U/G STRUCTURES DATE

LOCATION OF UNDERGROUND STRUCTURES AS SHOWN ARE BASED ON THE BEST INFORMATION AVAILABLE, BUT NO GUARANTEE IS GIVEN THAT ALL EXISTING UTILITIES ARE SHOWN OR THAT THE GIVEN LOCATIONS ARE EXACT. CONFIRMATION OF EXISTENCE AND EXACT LOCATION OF ALL SERVICES MUST BE OBTAINED FROM THE INDIVIDUAL UTILITIES BEFORE PROCEEDING WITH CONSTRUCTION.

B.M.
ELEV.

NO.	REVISIONS	DATE	BY
1	ISSUED FOR ADDENDUM 1	18/03/26	TJP
0	ISSUED FOR TENDER	18/03/16	TJP

DESIGNED BY RTP
DRAWN BY TJH
CHECKED BY TS
APPROVED BY TJP
HOR. SCALE AS NOTED
VERTICAL AS NOTED
DATE

DILLON CONSULTING

RELEASED FOR CONSTRUCTION
DATE

ENGINEER'S SEAL
PROVINCE OF MANITOBA
ORIGINAL STAMPED BY
T.J. PETERS
18/03/16
Member
22309
REGISTERED PROFESSIONAL ENGINEER

CONSULTANT PROJECT NUMBER
17-6152

Winnipeg

THE CITY OF WINNIPEG
PUBLIC WORKS DEPARTMENT

2018 REGIONAL STREET RENEWAL PROJECT
McPHILLIPS STREET RECONSTRUCTION AND UNDERPASS
STRUCTURAL IMPROVEMENTS
LOGAN AVENUE TO JARVIS AVENUE

SECTIONS (3 OF 3)

CITY DRAWING NUMBER
P-3492-2018-CT-020

SHEET 020 OF 022

CONSULTANT DRAWING NUMBER
CT-020

G:\CAD\176152\Drawings\Roadworks\Contract\176152-CON-CT-SECTIONS.dwg