
MARYLAND BRIDGE - SHERBROOK STREET (FIRE ACCESS ROUTE)

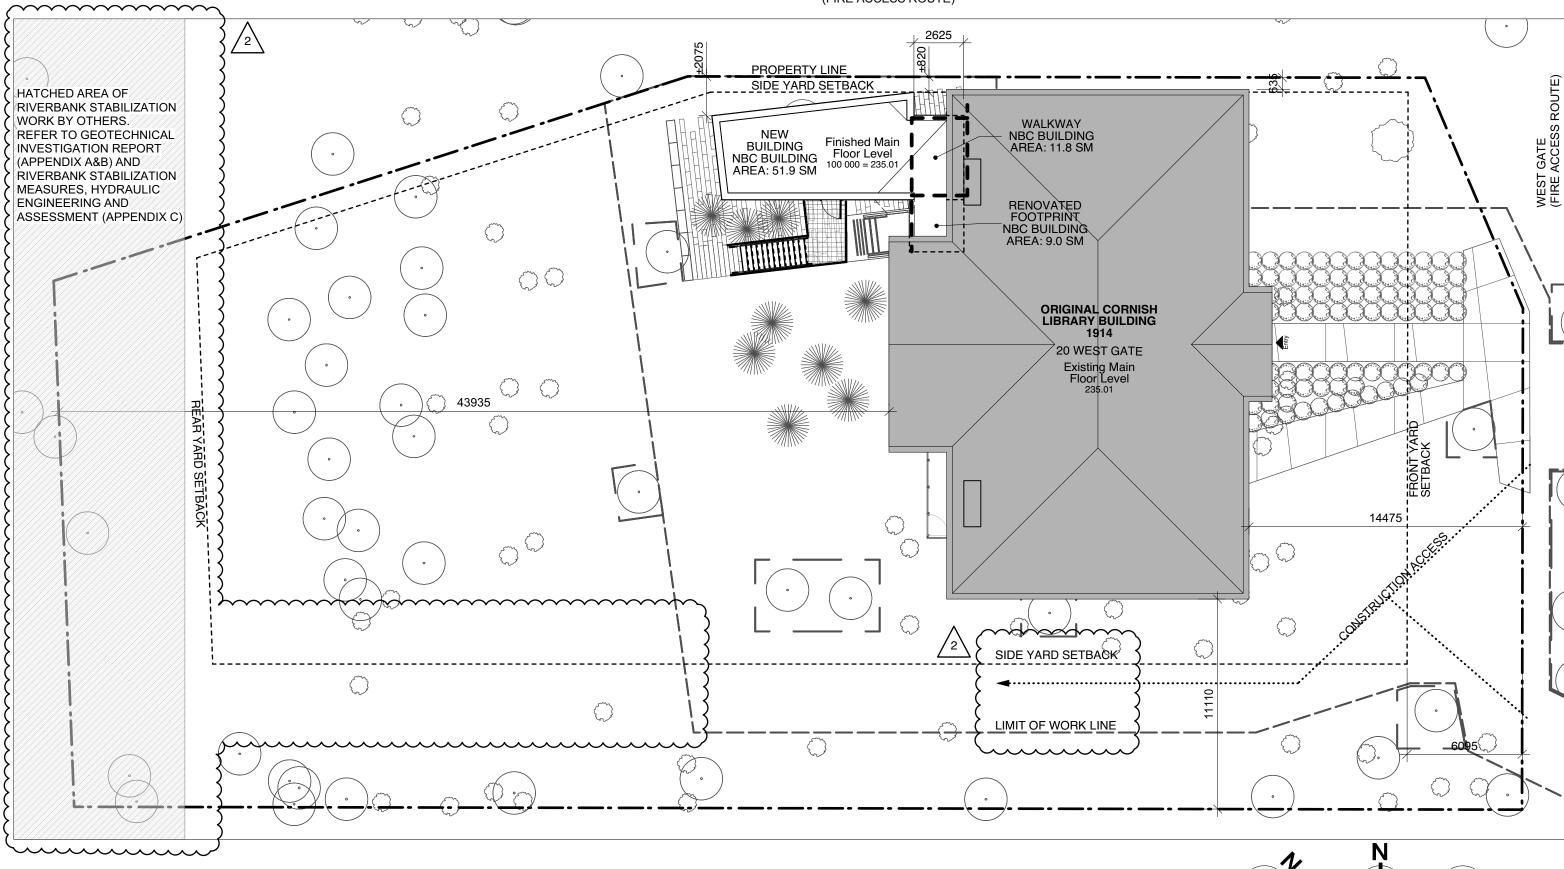




OWNER: The City of Winnipeg 185King Street Winnipeg, Manitoba, R3B 1J1 (204) 794-4418 (204) 986-4354

ARCHITECT & LANDSCAPE ARCHITECT: Public City Architecture Inc. 707 Sara Avenue Winnipeg, Manitoba, R3G 0Y8 (204) 475-9323





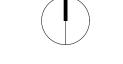

Key Plan Scale: 1:200

A-000/

Construction North True North

MECHANICAL ENGINEER: MCW / AGE 210 1821 Wellington Avenue Winnipeg, Manitoba, R3H 0G4 (204) 779-7900

ELECTRICAL ENGINEER: MCW / AGE 210 1821 Wellington Avenue Winnipeg, Manitoba, R3H 0G4 (204) 779-7900

CORNISH LIBRARY ADDITION & RENOVATION 20 WEST GATE, WINNIPEG, MANITOBA

Building and Site Design Summary

Legal Description LOT 59 and 60 Plan 119 WLTO Exc out of lot 60 Plans 10078 and 10681 WLTO in RL 86 Parish of St. James Lot Dimensions: ~ 63.2m x 30.2m

Lot Area: 2780 SQ. M Zoning

Property Type Building Use

Setbacks

North (side yard) East (front yard) South (side yard)

West (rear yard) Parking

No. of Parking Spaces No. of Bicycle Spaces

R1-L "Residental, Large" Library (refer to City of Winnipeg Conditional Use file #DCU 162807/2017C)

820mm (2'-8") (refer to City of Winnipeg Variance file #DAV 162818/2017C) 6096mm (20'-0") 7620mm (25'-0") 7620mm (25'-0")

0 (refer to City of Winnipeg Variance file #DAV 162818/2017C)

Manitoba Building Code Design Summary

Section 3.1 General Major occupancy classification New Building Area: Existing Building Area: TOTAL Building Area: Building height: Facing number of streets: Building is sprinklered: Firewalls:

Design occupant load: Section 3.2 Building Fire Saf Construction article: Construction:

New Building Spatial separation: North Wal South Wal

East Wall:

West Wall:

Section 3.4 Exits Main Floor: Number o

asement

Distance b Max. trave Number o Distance b

Max. trave Section 3.7 Health Requirem Using a reduced occupant load

Required: (100-10)/2 = 45 persons of each *UTR allows occupant laod to b

Provided: Existing building, basement le Existing building, main level

Section 3.8 Barrier Free

Barrier-free access provided to Power door operators required Barrier-free washrooms provid

ABBREVIATIONS:

AFF AACA AFF AACA AFF AACA AFF AACA ABB BB BA ABB BB BO BC CO	bustic ceiling tile finished ceiling finished floor cess hatch cess panel use resistant butic wall panel se board se board heater rrier free ttom of ck rest ntract administr ve base st in place ntrol joint iling ty masonry ncrete masonry lumn ncrete masonry ncrete masonry ncrete masonry ncrete masonry lumn ncrete ramic tile rtain Wall mplete with nking fountain or operator wn extor call panel oxy paint sting e Annunciator F e Extinguisher or drain rce flow heater or grille or Hatch or mat bab bar or grate psum wall boar se bib llow metal dro meter
---	---

GENERAL NOTES otherwise. companies prior to commencement of work.

	, in Outinitial y			
n:	Group A Divisio 52 sq. m (Read 395 sq. m 458.1 sq. m 1 storey		sq. m (Wa	alkway)= 63.1 sq. m
	2 No No			
	100			
fety	3.2.2.28 Group Non-combustib			/
II:	NA			
ll:	Limiting distance: Exposed building face: Unprotected openings: FRR:		 7.0 m 38.8 sq. m 89% allowed, 75% actual Construction of separate fire compartments within 7.0 m to meet 45 minute FRR. Non-combustible 7.0 m 4.8 sq. m 89% allowed, 75% actual Construction of separate fire compartments within 7.0 m to meet 45 minute ERP 	
	Construction: Cladding:			
:	Limiting distance: Exposed building face: Unprotected openings: FRR:			
I:	Construction: Cladding: N/A		to meet 45 minute FRR. Non-combustible Non-combustible	
of exits: between e el distance	exits: See to exit: See	uired, 2 provid 2/A-001 2/A-001		
of exits: between e el distance nents id of 100 p	exits: See e to exit: See	juired, 2 provid 1/A-001 1/A-001	led	
	= 1 male, 2 fen	nale required,	total.	
evel	= 1 universal to = 1 universal to		nisex WC	
	= 3 fixtures tota			
o all floor	areas:			Yes, via platform
	l on barrier-free floor areas:	door at entrar	nce:	Yes Yes
е	MIR MTL	Mirror Metal		
	MTL DK MF NIC	Exposed me Main Floor Not in contra		
	O/C O/F	On centre Outside face		
r	0/H 0/0 0TA	Overhead Outside to or Open to abo		
ator	OTB OWSJ	Open to belo Open web st	w teel joist	
aloi	P/A PL PNT PRTN	Public addre Plastic lamin Paint Partition	ate	
' unit	PT PTD PTL	Pressure tre Paper Towel Push to lock	Dispenser	r
	PW RB RBSF	Plywood Rubber base Rubber spor		
	RD RFG	Roof Drain Refrigerator		
	RH R/O RSB	Robe hook Rough Oper Recessed sv	iing vitch box	
l r	RSF RTU RV	Resilient she Roof top unit Relief vent	et flooring	
	SB SCR	Switch box Screen		
anel	SD SF SG	Soap dispen Storefront Steel sign	ser	
	SIM SP SS	Similar Splash pad Stainless ste	ما	
	ST STM	Stain Stone masor		
anel	STN TB TG	Station Tack board Tempered gl		
d	T/O TP	Top of Toilet paper Toilet Partitic		
	TPTN TYP U/S	Typical Underside		
on	VCT VOS WC	Vinyl Compo Verify on site Washroom	site Tile e	
	WD WG	Wood Wall grille		
	WI GL WP WR WW XSTG	Wired glass Water proof Waste recep Window Wal Existing	tacle I	
		-		

1. All dimensions are to grid lines and/or face of finished assembly unless noted 2. Contractor shall verify the location of all site services with their respective utility 3. Clean up all construction debris from the site regularly and repair any damage to the site resulting from demolition and construction upon completion of the work.


Drawing List

Drawing List				
ARCHITECTURAL & LANDSCAPE				
A-000 A-001 A-002	TITLE PAGE CODE ANALYSIS AND GLAZING ELEVATIONS SCHEDULES AND ASSEMBLIES			
A-101	DEMOLITION PLANS			
L-101 L-102	MATERIALS & PLANTING PLAN GRADING & LAYOUT PLAN			
L-501 L-502	LANDSCAPE DETAILS LANDSCAPE DETAILS			
A-200 A-201 A-203 A-204	MAIN FLOOR PLAN BASEMENT FLOOR PLAN REFLECTED CEILING PLAN REFLECTED CEILING PLAN AND ROOF PLAN			
A-300	BUILDING SECTIONS			
A-400	EXTERIOR ELEVATIONS			
A-500	WALL SECTIONS AND DETAILS			
A-600 A-601 A-602 A-603	DETAILS DETAILS DETAILS DETAILS			
A-700 A-701	INTERIOR ELEVATIONS INTERIOR ELEVATIONS, MILLWORK DETAILS			
STRUCTURAL				
S-0 S-1 S-2	GENERAL NOTES FOUNDATION & BASEMENT FRAMING PLAN MAIN FLOOR, BASEMENT EXIT LANDING, & ENTRY RAMP FRAMING PLAN			
S-3 S-4 S-5 S-6 S-7	ROOF FRAMING PLAN SECTIONS & DETAILS SECTIONS & DETAILS SECTIONS & DETAILS SECTIONS & DETAILS			
MECHAN	lical			
M0.0 M1.1 M2.1 M2.2 M3.1 M3.2	DRAWING LIST & LEGEND BASEMENT - PLUMBING DEMOLITION LAYOUT BASEMENT - HVAC DEMOLITION LAYOUT MAIN FLOOR - HVAC DEMOLITION LAYOUT BASEMENT - PLUMBING RENOVATION LAYOUT MAIN FLOOR - PLUMBING RENOVATION LAYOUT			
M4.1 M4.2 M5.1	BASEMENT - HVAC RENOVATION LAYOUT MAIN FLOOR - HVAC RENOVATION LAYOUT MECHANICAL DETAILS AND SCHEMATICS			
ME1.1	MECHANICAL SPECIFICATIONS, SCHEDULES & CHARTS			
ELECTRICAL				
E1.0 ED2.0	SYMBOL LEGEND AND DETAILS ELECTRICAL BASEMENT - ELECTRICAL DEMOLITION LAYOUT			
ED2.1 EL2.0 EL2.1	MAIN FLOOR - DEMOLITION ELECTRICAL BASEMENT - LIGHTING RENOVATION LAYOUT MAIN FLOOR - LIGHTING RENOVATION			
EP2.0	LAYOUT BASEMENT - POWER AND SYSTEMS			
EP2.1	RENOVATION LAYOUT MAIN FLOOR - POWER AND SYSTEMS			
E5.0	RENOVATION LAYOUT PANELBOARD SCHEDULES			


Symbol Legend

Elevation Mark ⁄ x A-XX

Room Name Room Number

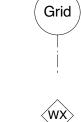

X ∖A-XX

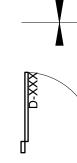

Floor Finish/Transition Refer to Specifications for Thresholds

Elevation Marker

Section Marker

Room Marker

Assembly Tag

Detail Marker

Grid Line and Bubble

New Door

Existing Door

Key Note

X

PUBLICCITY Public City Architecture Inc 707 Sara Avenue Winnipeg Manitoba R3G 0Y8 204 475 9323 publiccityarchitecture.com

Owner City of Winnipeg 185 King Street Winnipeg, Manitoba, R3B 1J1 (204) 794-4418 (204) 986-4354

Rev. No. Date **Revision Notes** 1. 2017.11.28 Issued for Construction 2. 2018.01.08 Re-Issued for Construction



This drawing must not be scaled. The contractors shall verify all dimensions and other data on site prior to commencement of work. Discrepancies, errors, and omissions are to be reported to Public City Architecture Inc. prior to proceeding with the Work. Drawings and specifications as instruments of service are the property of Public City Architecture Inc.; the copyright in the same being reserved.

No reproduction or revision to these drawings may be made without the permission of Public City Architecture Inc., and when made, must bear their name. All prints to be returned to Public City Architecture Inc. upon request.

Project Cornish Library Renovation

Drawing Title Page

Drawn Bv TH Scale As Noted

Reviewed Bv PS Drawing No. A-000

Date 2016.10.06 1503a

Project No