


ADDRESS	SIZE (mm) MATERIAL	P. DIST JUNCTION TIE	REMARKS
k 571 BERESFORD AVE RESIDENTIAL	150 —	_ _	RENEW TO F W/ 150 PVC
\$572 BERESFORD AVE RESIDENTIAL	150 —	- -	OUTSIDE LIMITS -
\$573 BERESFORD AVE RESIDENTIAL	150 —	_ _	RENEW TO P. W/ 150 PVC WYED W/ 575
\$574 BERESFORD AVE RESIDENTIAL	150 —	- -	OUTSIDE LIMITS
#575 BERESFORD AVE RESIDENTIAL	150 —	- -	RENEW TO P. W/ 150 PVC WYED W/ 573
\$576 BERESFORD AVE RESIDENTIAL	150 —	- -	RENEW TO P W/ 150 PVC
\$577 BERESFORD AVE RESIDENTIAL	150 —	- -	RENEW TO P W/ 150 PVC
★578 BERESFORD AVE RESIDENTIAL	150 —		RENEW TO P W/ 150 PVC
₹579 BERESFORD AVE RESIDENTIAL	150 —	_ _	RENEW TO P W/ 150 PVC
₹580 BERESFORD AVE RESIDENTIAL	150 —	-	RENEW TO P W/ 150 PVC
₹581 BERESFORD AVE RESIDENTIAL	150 —	-	RENEW TO P W/ 150 PVC
1582 BERESFORD AVE RESIDENTIAL	150 —		RENEW TO P W/ 150 PVC
16583 BERESFORD AVE RESIDENTIAL	150 —	_ _	RENEW TO P W/ 150 PVC WYED W/ 585
₹584 BERESFORD AVE RESIDENTIAL	150 —	-	RENEW TO P W/ 150 PVC
₹585 BERESFORD AVE RESIDENTIAL	150 —	-	RENEW TO P W/ 150 PVC WYED W/ 583
1587 BERESFORD AVE RESIDENTIAL	150 —	-	RENEW TO P W/ 150 PVC WYED W/ 589
₹589 BERESFORD AVE RESIDENTIAL	150 _	_ _	RENEW TO P. W/ 150 PVC WYED W/ 587
16591 BERESFORD AVE RESIDENTIAL	150 —	-	RENEW TO P W/ 150 PVC
₹593 BERESFORD AVE RESIDENTIAL	150 —	_ _	RENEW TO P W/ 150 PVC
₹595 BERESFORD AVE RESIDENTIAL	150 _	- -	OUTSIDE LIMITS
\$596 BERESFORD AVE RESIDENTIAL	150 —		RENEW TO P W/ 150 PVC
\$598 BERESFORD AVE RESIDENTIAL	150		RENEW TO P W/ 150 PVC
★600 BERESFORD AVE RESIDENTIAL	150		RENEW TO P W/ 150 PVC
604 BERESFORD AVE	150 –	- 	RENEW TO P W/ 150 PVC
RESIDENTIAL 608 BERESFORD AVE	 150		RENEW TO P W/ 150 PVC

ADDRESS	SIZE (mm) MATERIAL (STREET)	SHORT & LONG MEASUREMENT	CORP. LOCATION	REMARKS
★ 571 BERESFORD AVE RESIDENTIAL	20 COPPER	2.5 EEL BASEMENT 0.5 EEL	1.4 E S/C	
★ 573 BERESFORD AVE RESIDENTIAL	_	- -	-	_
★574 BERESFORD AVE RESIDENTIAL	<u>-</u>	- -	_	-
★575 BERESFORD AVE RESIDENTIAL		-	_	-
★576 BERESFORD AVE RESIDENTIAL	20 COPPER	3.3 WEL BASEMENT	OPPOSITE S/C	-
★577 BERESFORD AVE RESIDENTIAL	20 COPPER	1.7 EEL HOUSE 125 WWL NASSAU ST	0.6 W S/C	-
★578 BERESFORD AVE RESIDENTIAL	20 COPPER	0.3 WEL HOUSE 115.8 WWL NASSAU ST	0.3 W S/C	-
★579 BERESFORD AVE RESIDENTIAL	20 COPPER	1.8 EWL BASEMENT 2.2 EWLL	OPPOSITE S/C	-
★580 BERESFORD AVE RESIDENTIAL	12 LEAD	1.1 WEL HOUSE 90.2 EEL DALY ST	89.3 EEL DALY	-
★581 BERESFORD AVE RESIDENTIAL	20 COPPER	0.2 WEL HOUSE 68.6 EEL DALY ST	OPPOSITE S/C	
★582 BERESFORD AVE RESIDENTIAL	12 LEAD	1.8 WEL HOUSE 81.1 EEL DALY ST	0.3 W S/C	-
★583 BERESFORD AVE RESIDENTIAL	- -	2.4 EWL HOUSE 53.3 W 1ST HYD E DALY ST	0.9 W S/C	_
★584 BERESFORD AVE RESIDENTIAL	12 LEAD	1.2 WEL HOUSE 71 EEL DALY ST	0.9 W S/C	_
★585 BERESFORD AVE RESIDENTIAL	_	2.7 EWL HOUSE 583 53.6 W 1ST HYD E DALY ST	0.9 W S/C	_
★ 587 BERESFORD AVE RESIDENTIAL	20 COPPER	3.4 WEL HSE 39.2 EEL DALY	0.3 E S/C	_
★ 589 BERESFORD AVE RESIDENTIAL	20 COPPER	4.7 EEL HOUSE 38.7 EEL DALY ST	0.5 E S/C	_
★ 591 BERESFORD AVE RESIDENTIAL	12 LEAD	0.9 EEL HOUSE 25 EEL DALY ST	SAME AS S/C	-
★ 593 BERESFORD AVE RESIDENTIAL	16 LEAD	0.6 EWL OF HOUSE 593 11 EEL DALY ST	11.3 EEL DALY ST	-
★ 596 BERESFORD AVE RESIDENTIAL	20 COPPER	1.5 EWL HOUSE 51.8 W 1ST HYD E DALY ST	0.6 W S/C	-
★598 BERESFORD AVE RESIDENTIAL	20 COPPER	3 WELL HOUSE 49.7 EEL DALY ST	0.2 W S/C	_
★600 BERESFORD AVE RESIDENTIAL	16 LEAD	1.2 EWL BASEMENT 39.3 EEL DALY ST	40.5 EEL DALY ST	-
★604 BERESFORD AVE RESIDENTIAL	20 LEAD	2.4 WELL HOUSE 27.4 EEL DALY ST	26.5 EEL DALY ST	
★ 608 BERESFORD AVE RESIDENTIAL	20 COPPER	1.1 WEL HOUSE 11.6 EEL DALY ST	0.3 W S/C	-

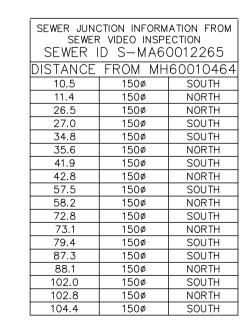

ENGINEERS GEOSCIENTISTS **Certificate of Authorization WSP Canada Group Limited** No. 6657

NOTE: ALL VALVES TO BE INSTALLED COUNTERCLOCKWISE TO CLOSE

> **METRIC** WHOLE NUMBERS INDICATE MILLIMETRES DECIMALIZED NUMBERS INDICATE METRES

WARNING IF POWER EQUIPMENT OR EXPLOSIVES ARE TO BE USED FOR EXCAVATION ON THIS PROJECT THE CONTRACTOR MUST:

1) NOTIFY THE GAS COMPANY OF THE PROPOSED LOCATION OF EXCAVATION. 2) TAKE PRECAUTION TO AVOID DAMAGE TO GAS COMPANY INSTALLATIONS.

SEE PROVINCIAL REGULATION 210/72 FOR DETAILS

UNDERGROUND STRUCTURES SUPV. U/G STRUCTURES NOTE: LOCATION OF UNDERGROUND STRUCTURES AS SHOWN ARE BASED ON THE BEST INFORMATION AVAILABLE BUT NO GUARANTEE IS GIVEN THAT ALL EXISTING UTILITIES ARE SHOWN OR THAT THE GIVEN LOCATIONS ARE EXACT. CONFIRMATION OF EXISTENCE AND EXACT LOCATION OF ALL SERVICES MUST BE OBTAINED FROM THE INDIVIDUAL UTILITIES BEFORE PROCEEDING WITH CONSTRUCTION.

LOCATION APPROVED

BY N	
BY N	
	MCW
DRAWN	HK
BY	
SCALE:	
	250
A ADDENDUM 3 2018/04/02 SM VERTICAL 1:5	1:50

REVISIONS

DATE BY

WSP Canada Inc Suite 111 - 93 Lombard Ave Winnipeg, MB R3B 3B1 t. 204.943.3178 f 204 943 4948 www.wsp.com CHECKED BY MCW SM APPROVED HK SM

2018 03 28

2018 03 28

PLOT DATE:

RELEASED FOR

CONSTRUCTION

DATE

####

WONG 32500 CONSULTANT DRAWING NUMBER

Winnipeg

THE CITY OF WINNIPEG WATER AND WASTE DEPARTMENT ENGINEERING DIVISION

2018 LOCAL STREET RENEWAL PROGRAM SHEET 21 OF 21

BERESFORD AVENUE DALY STREET SOUTH TO OSBORNE STREET SEWERMAIN RENEWALS STA. 0+93.93 TO STA. 2+40

BID OPPORTUNITY 32-2018

FILE NAME: 17M-02167-00 Beresford Ave Sewer Main Renewal.dwg

BID OPPORTUNITY: 32-2018 CONTRACT NUMBER####

17M-02167-00-C-21

ENGINEER'S SEAL

FILE PATH: P:\2017\17M-02167-00 - 2018 Local Streets and Alley Renewal Program\WSP DWG\Construction Drawings\