
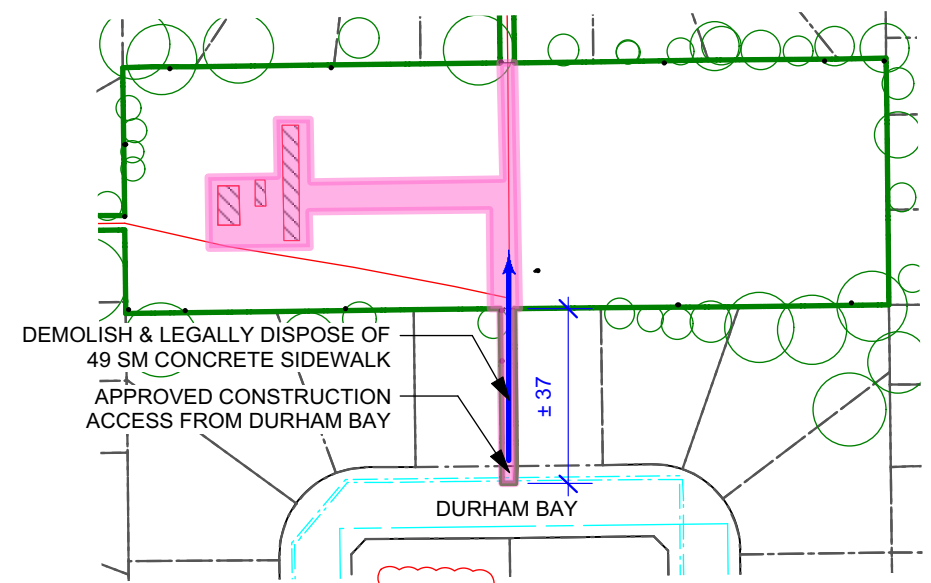


LEGEND

- PARK PROPERTY LINE
- - - PRIVATE PROPERTY LINE
- - - WATERMAIN
- - - SEWER MAIN
- - - LIMIT OF PLAY AREA
- - - LIMIT OF LANDSCAPING
- EXIST. HYDRO POLE
- EXIST. BOLLARDS
- EXIST. TREE

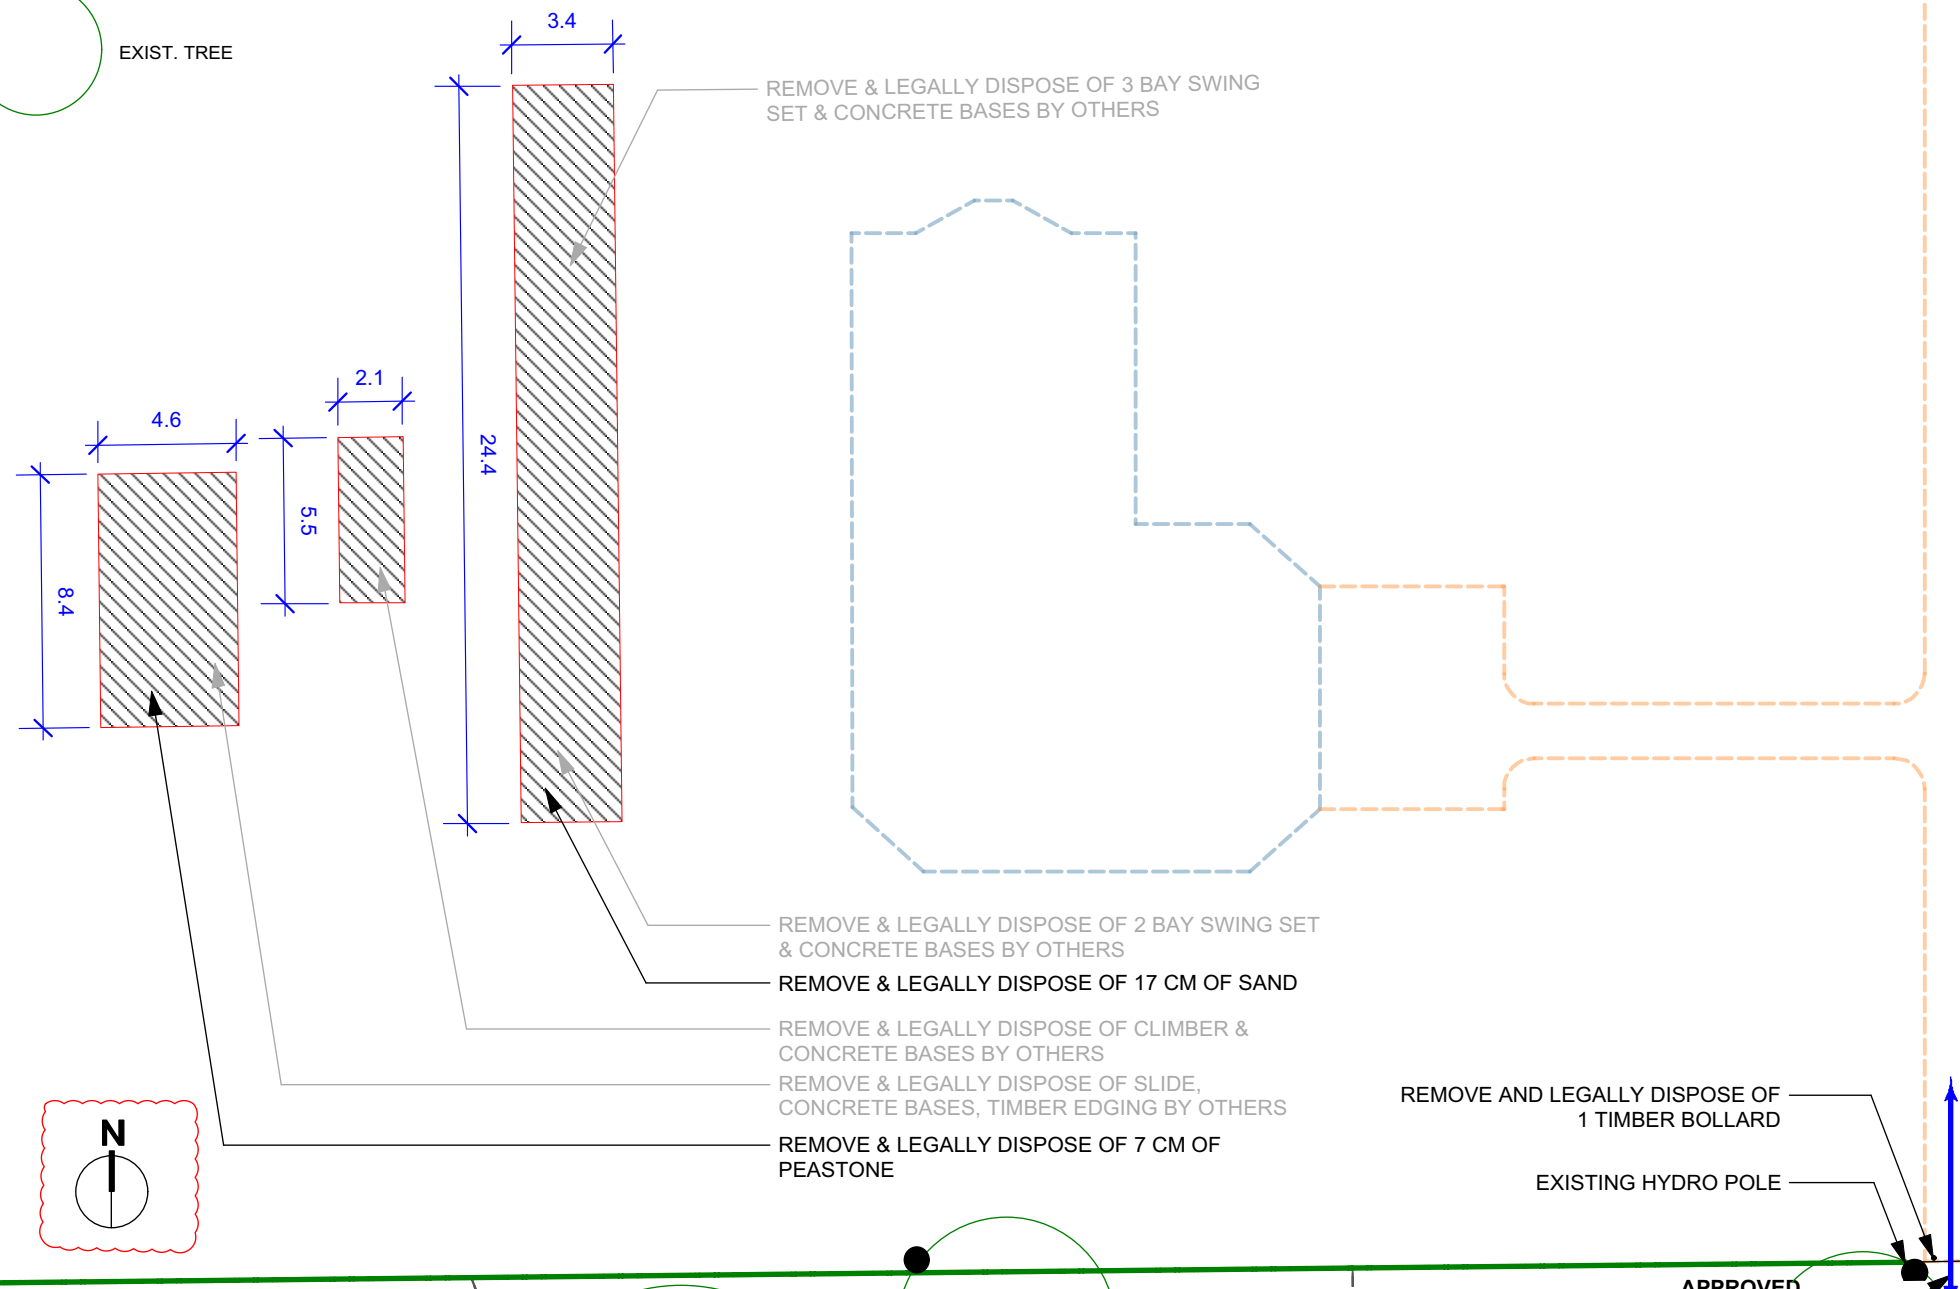

1 Key Plan
D.33-A4 NTS

LEGEND
LIMIT OF WORK AREA

DEMOLITION & REMOVALS NOTES

1. ALL WORK TO CONFORM TO CURRENT CITY OF WINNIPEG STANDARD CONSTRUCTION SPECIFICATIONS AND DETAILS UNLESS OTHERWISE NOTED.
2. DIMENSIONS ARE IN METERS UNLESS OTHERWISE NOTED.
3. REPORT ANY DISCREPANCIES TO THE CONTRACT ADMINISTRATOR IMMEDIATELY.
4. DO NOT SCALE DRAWING.
5. PROTECT EXISTING TREES TO REMAIN AS PER CW 1130.
6. SECURE CONSTRUCTION SITE AND STAGING AREA WITH CONSTRUCTION FENCING C/W SAFETY SIGNAGE.
7. SITE ACCESS VIA DURHAM BAY ONLY.

CONTRACTOR TO CONFIRM ALL DIMENSIONS AND REPORT ANY DISCREPANCIES TO CONTRACT ADMINISTRATOR PRIOR TO CONSTRUCTION. LOCATION OF UNDERGROUND STRUCTURES AS SHOWN ARE BASED ON THE BEST INFORMATION AVAILABLE BUT NO GUARANTEE IS GIVEN THAT ALL EXISTING UTILITIES ARE SHOWN OR THAT THE GIVEN LOCATIONS ARE EXACT. CONFIRMATION OF EXISTENCE AND EXACT LOCATION OF ALL SERVICES MUST BE OBTAINED FROM THE INDIVIDUAL UTILITIES BEFORE PROCEEDING WITH CONSTRUCTION.

1 DURHAM PARK REMOVALS
D.33-A4 Scale: 1:250

DESIGNED BY	LL	CHECKED BY	CH	MANAGER, PARK AND OPEN SPACES	DATE
DRAWN BY	LL	APPROVED BY	CH		
HORIZ. SCALE	AS NOTED			MANAGER, PLANNING AND LAND USE DIVISION	DATE
VERT. SCALE					
DATE	JULY 2018				



THE CITY OF WINNIPEG
Planning, Property and Development Department
Planning and Land Use Division
Unit 15 - 30 Fort Street, Winnipeg, MB, (R3C 4X5)

DRAWING TITLE	DRAWING NO.
Durham Park Playground Redevelopment Demolition & Removals Plan	D.33-A1-R2
SITE ADDRESS 57 DULUTH BAY	BID OPPORTUNITY NO. 594-2018