

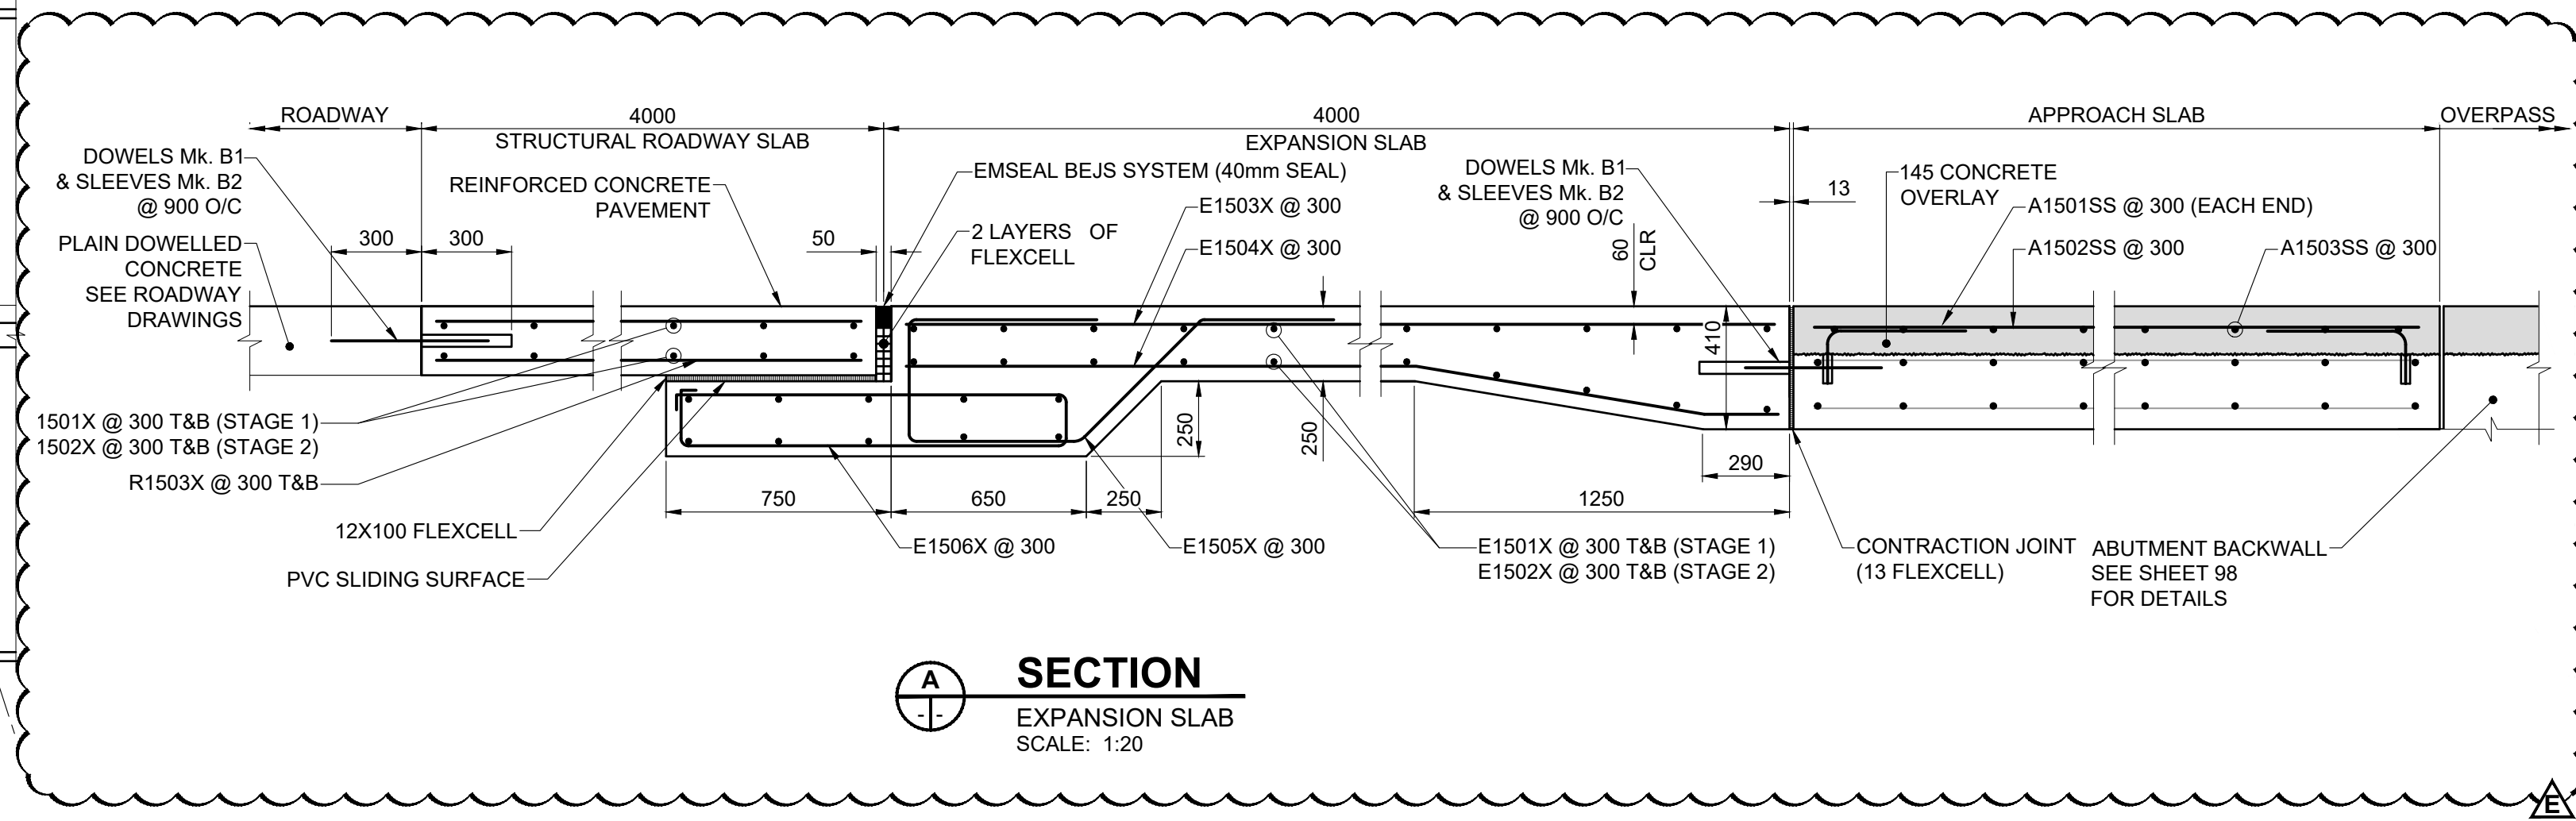
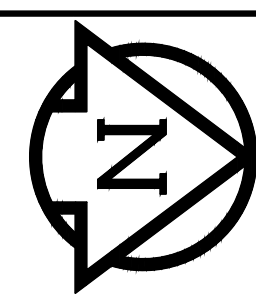
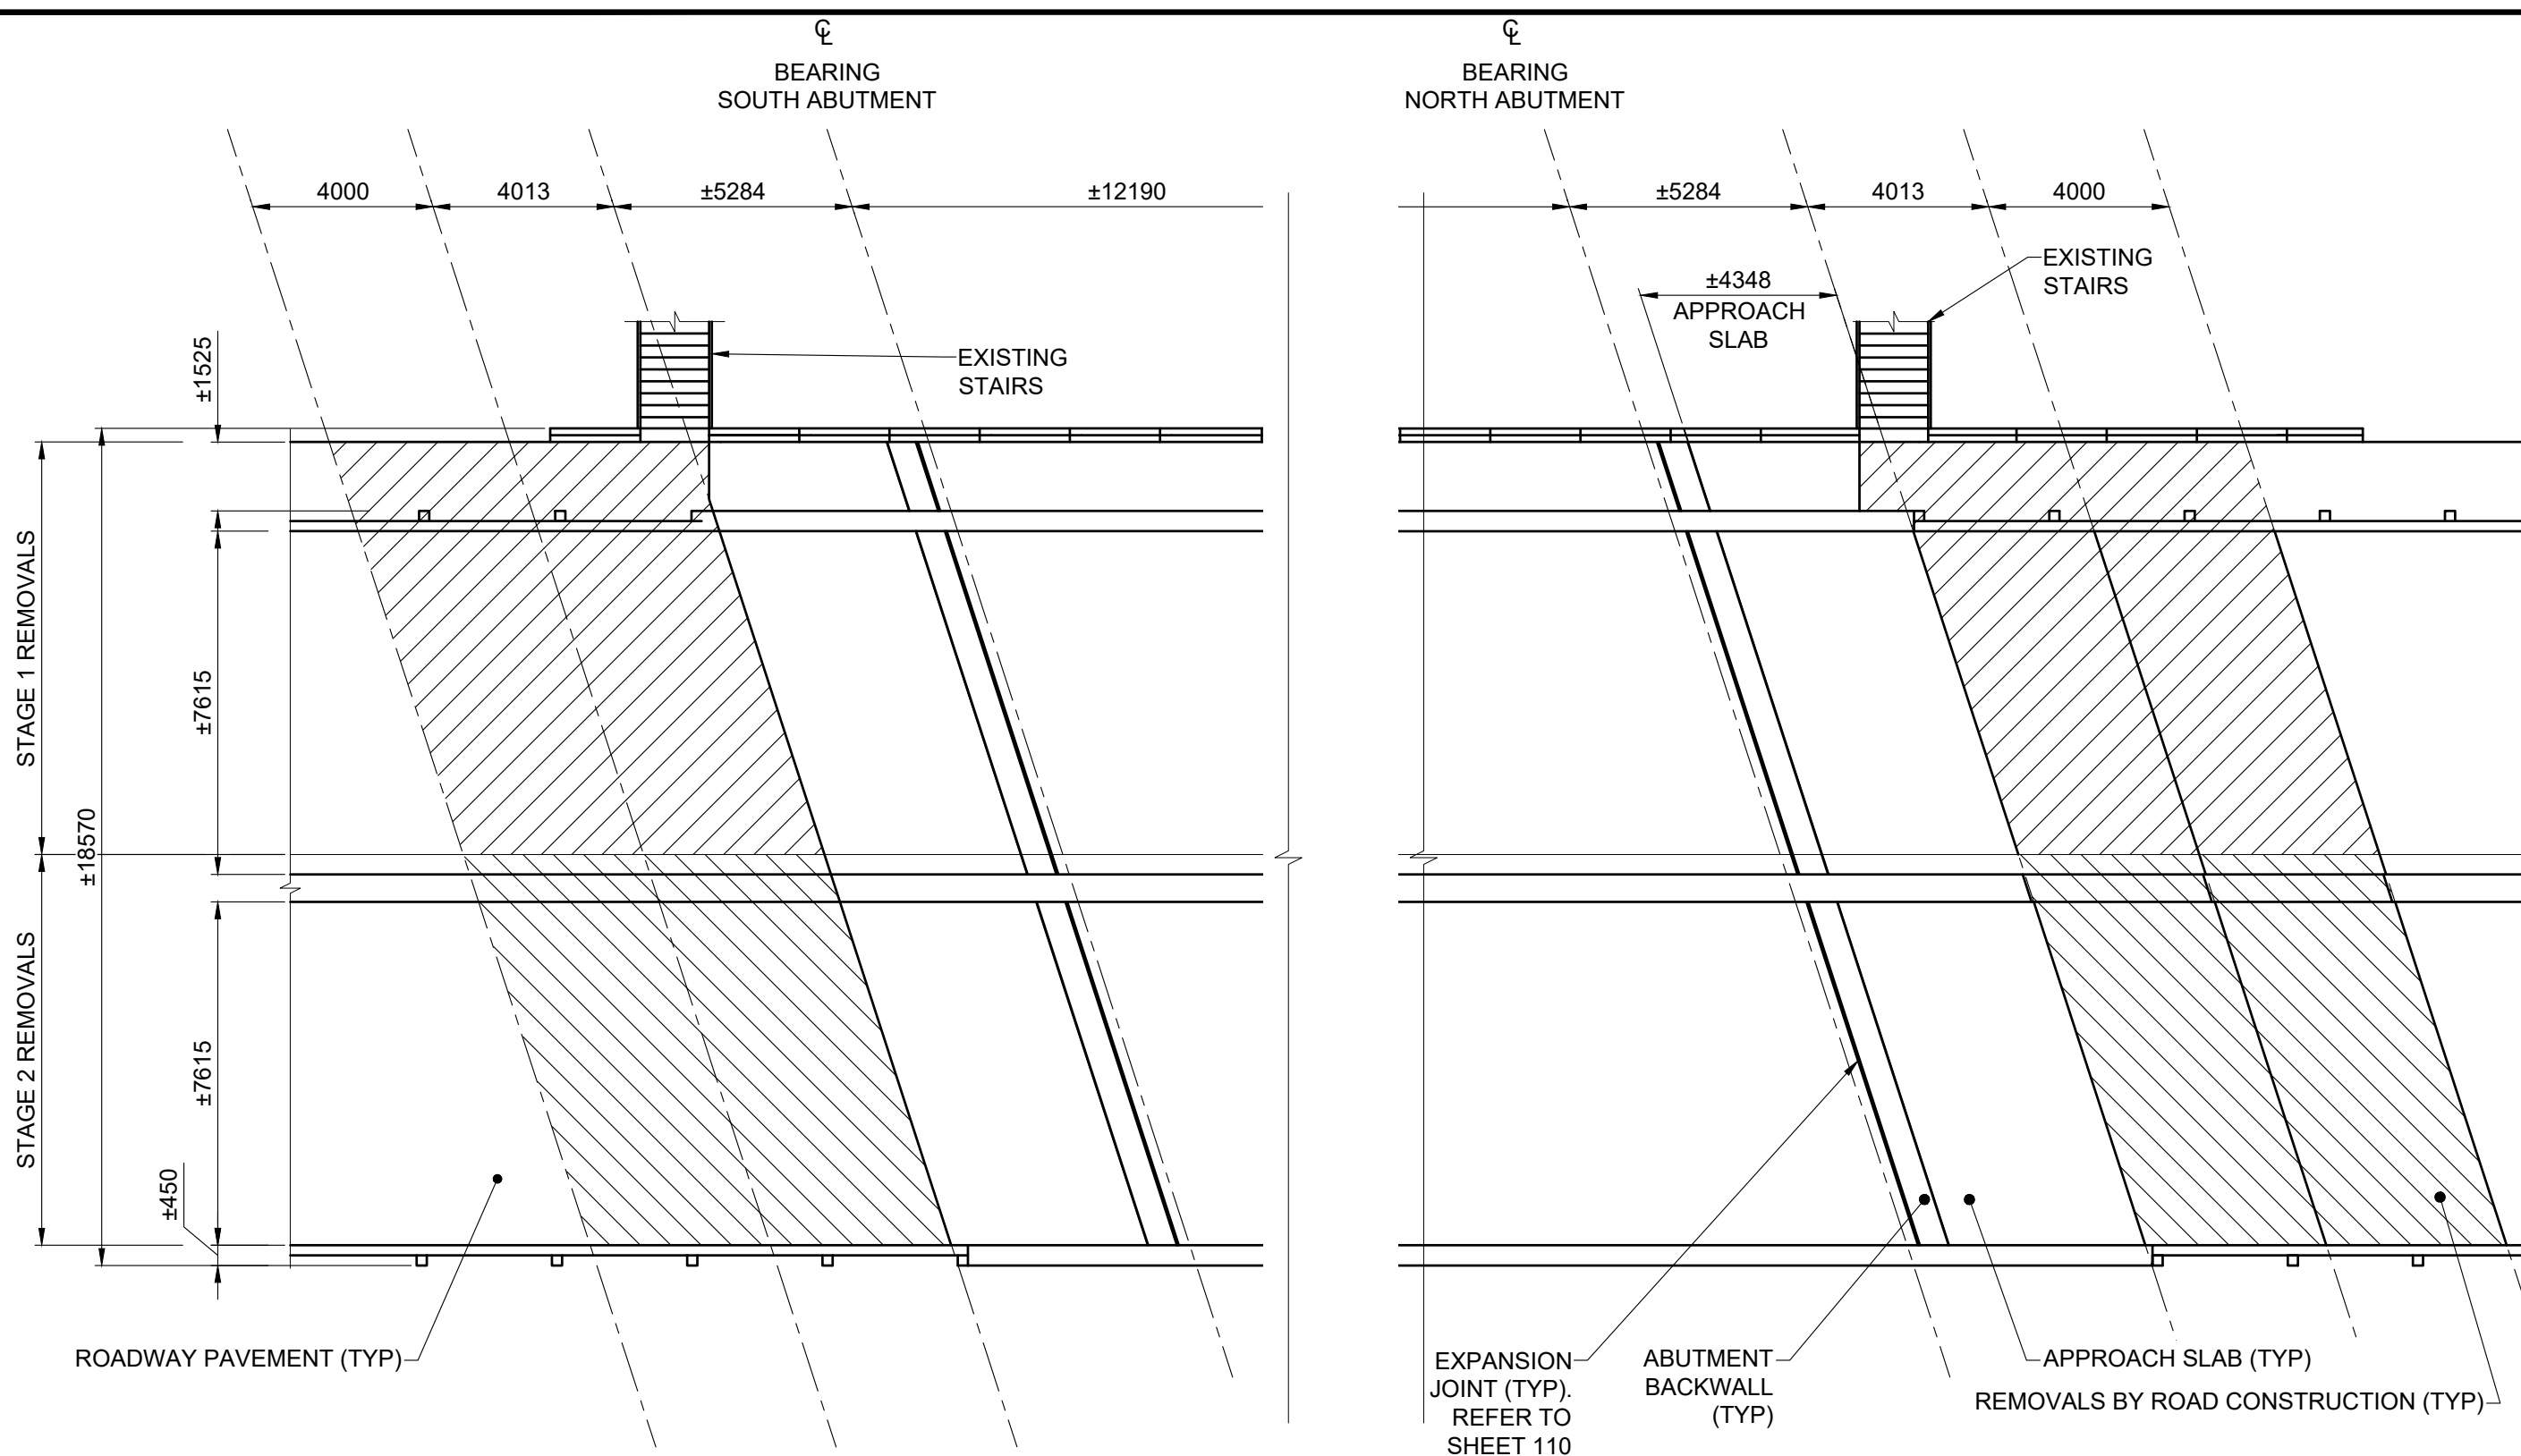
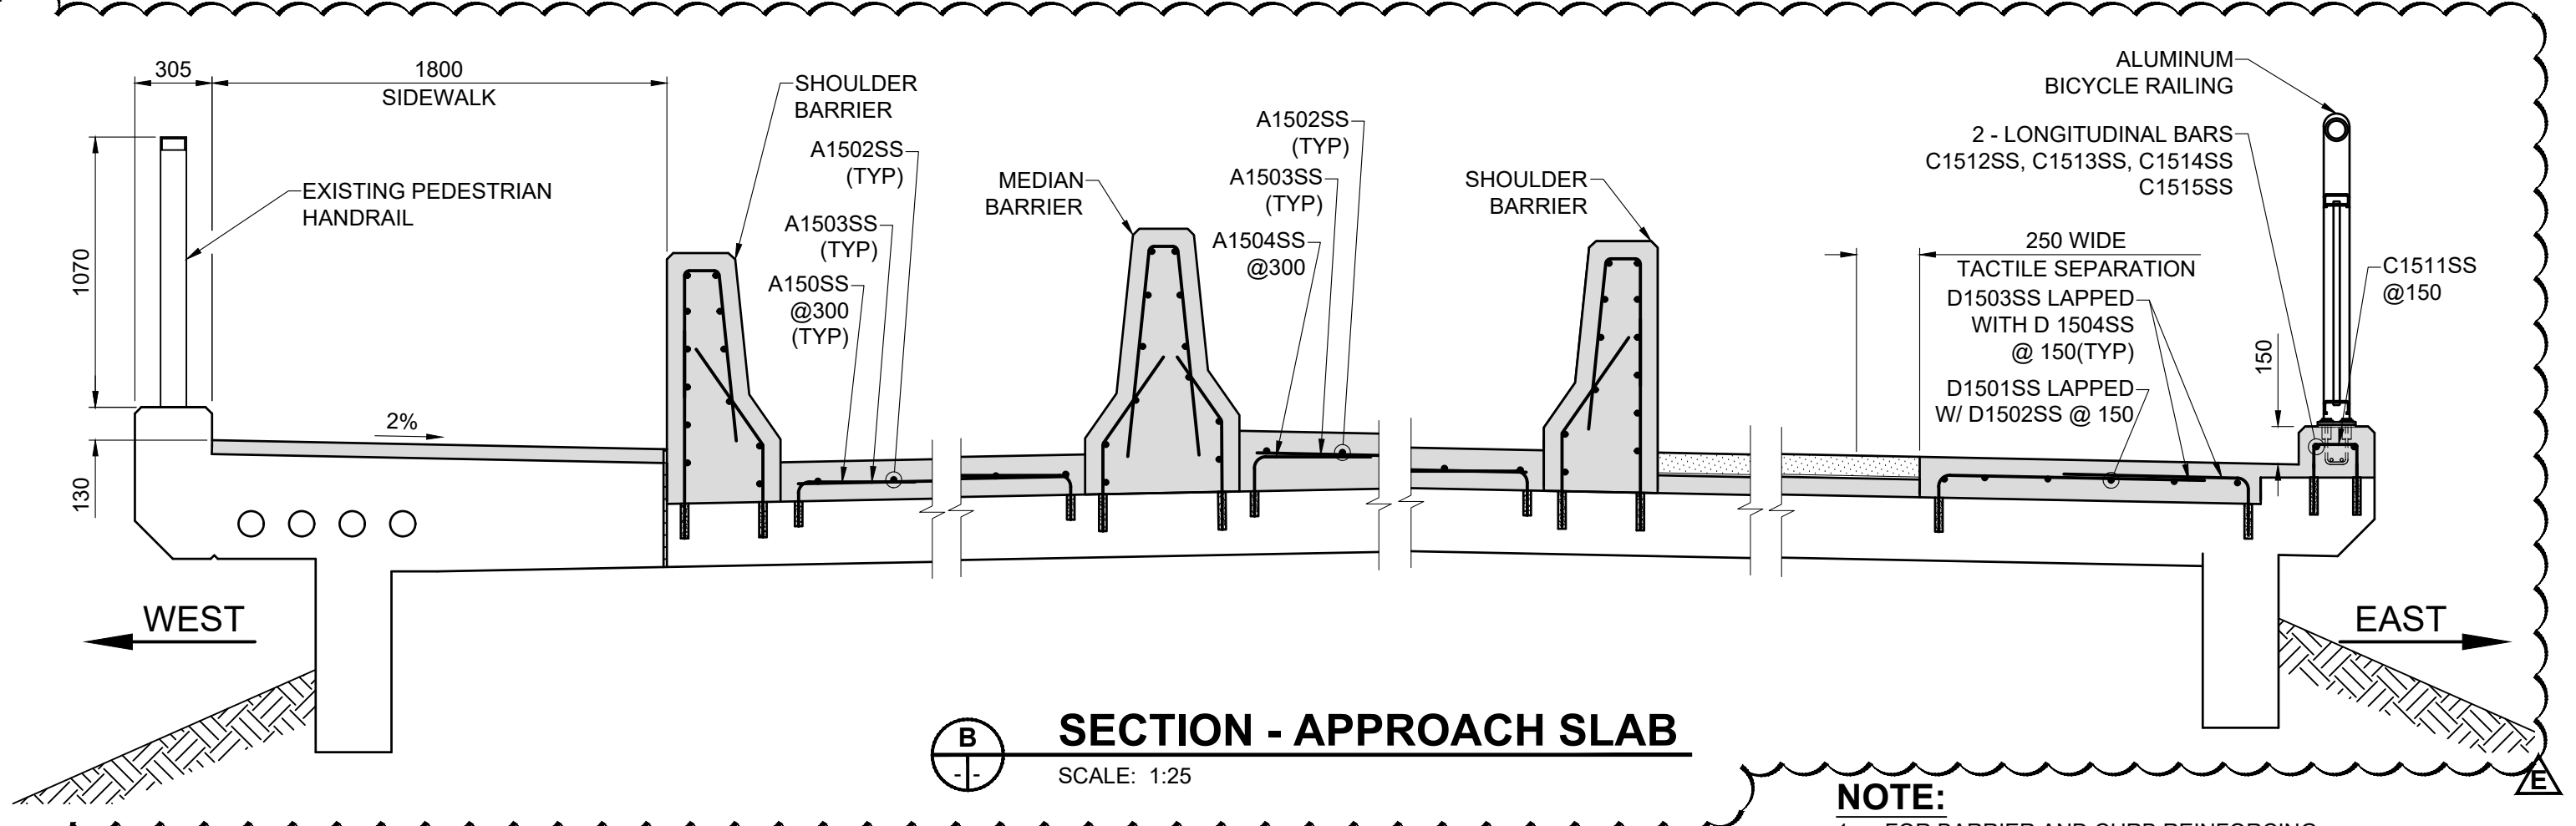


GENERAL NOTES:
 1. SUBSTRUCTURE NOT SHOWN FOR CLARITY.

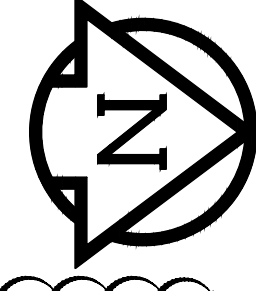

PLAN OF EXISTING ROADWAY SLAB REMOVAL
 SCALE 1:150

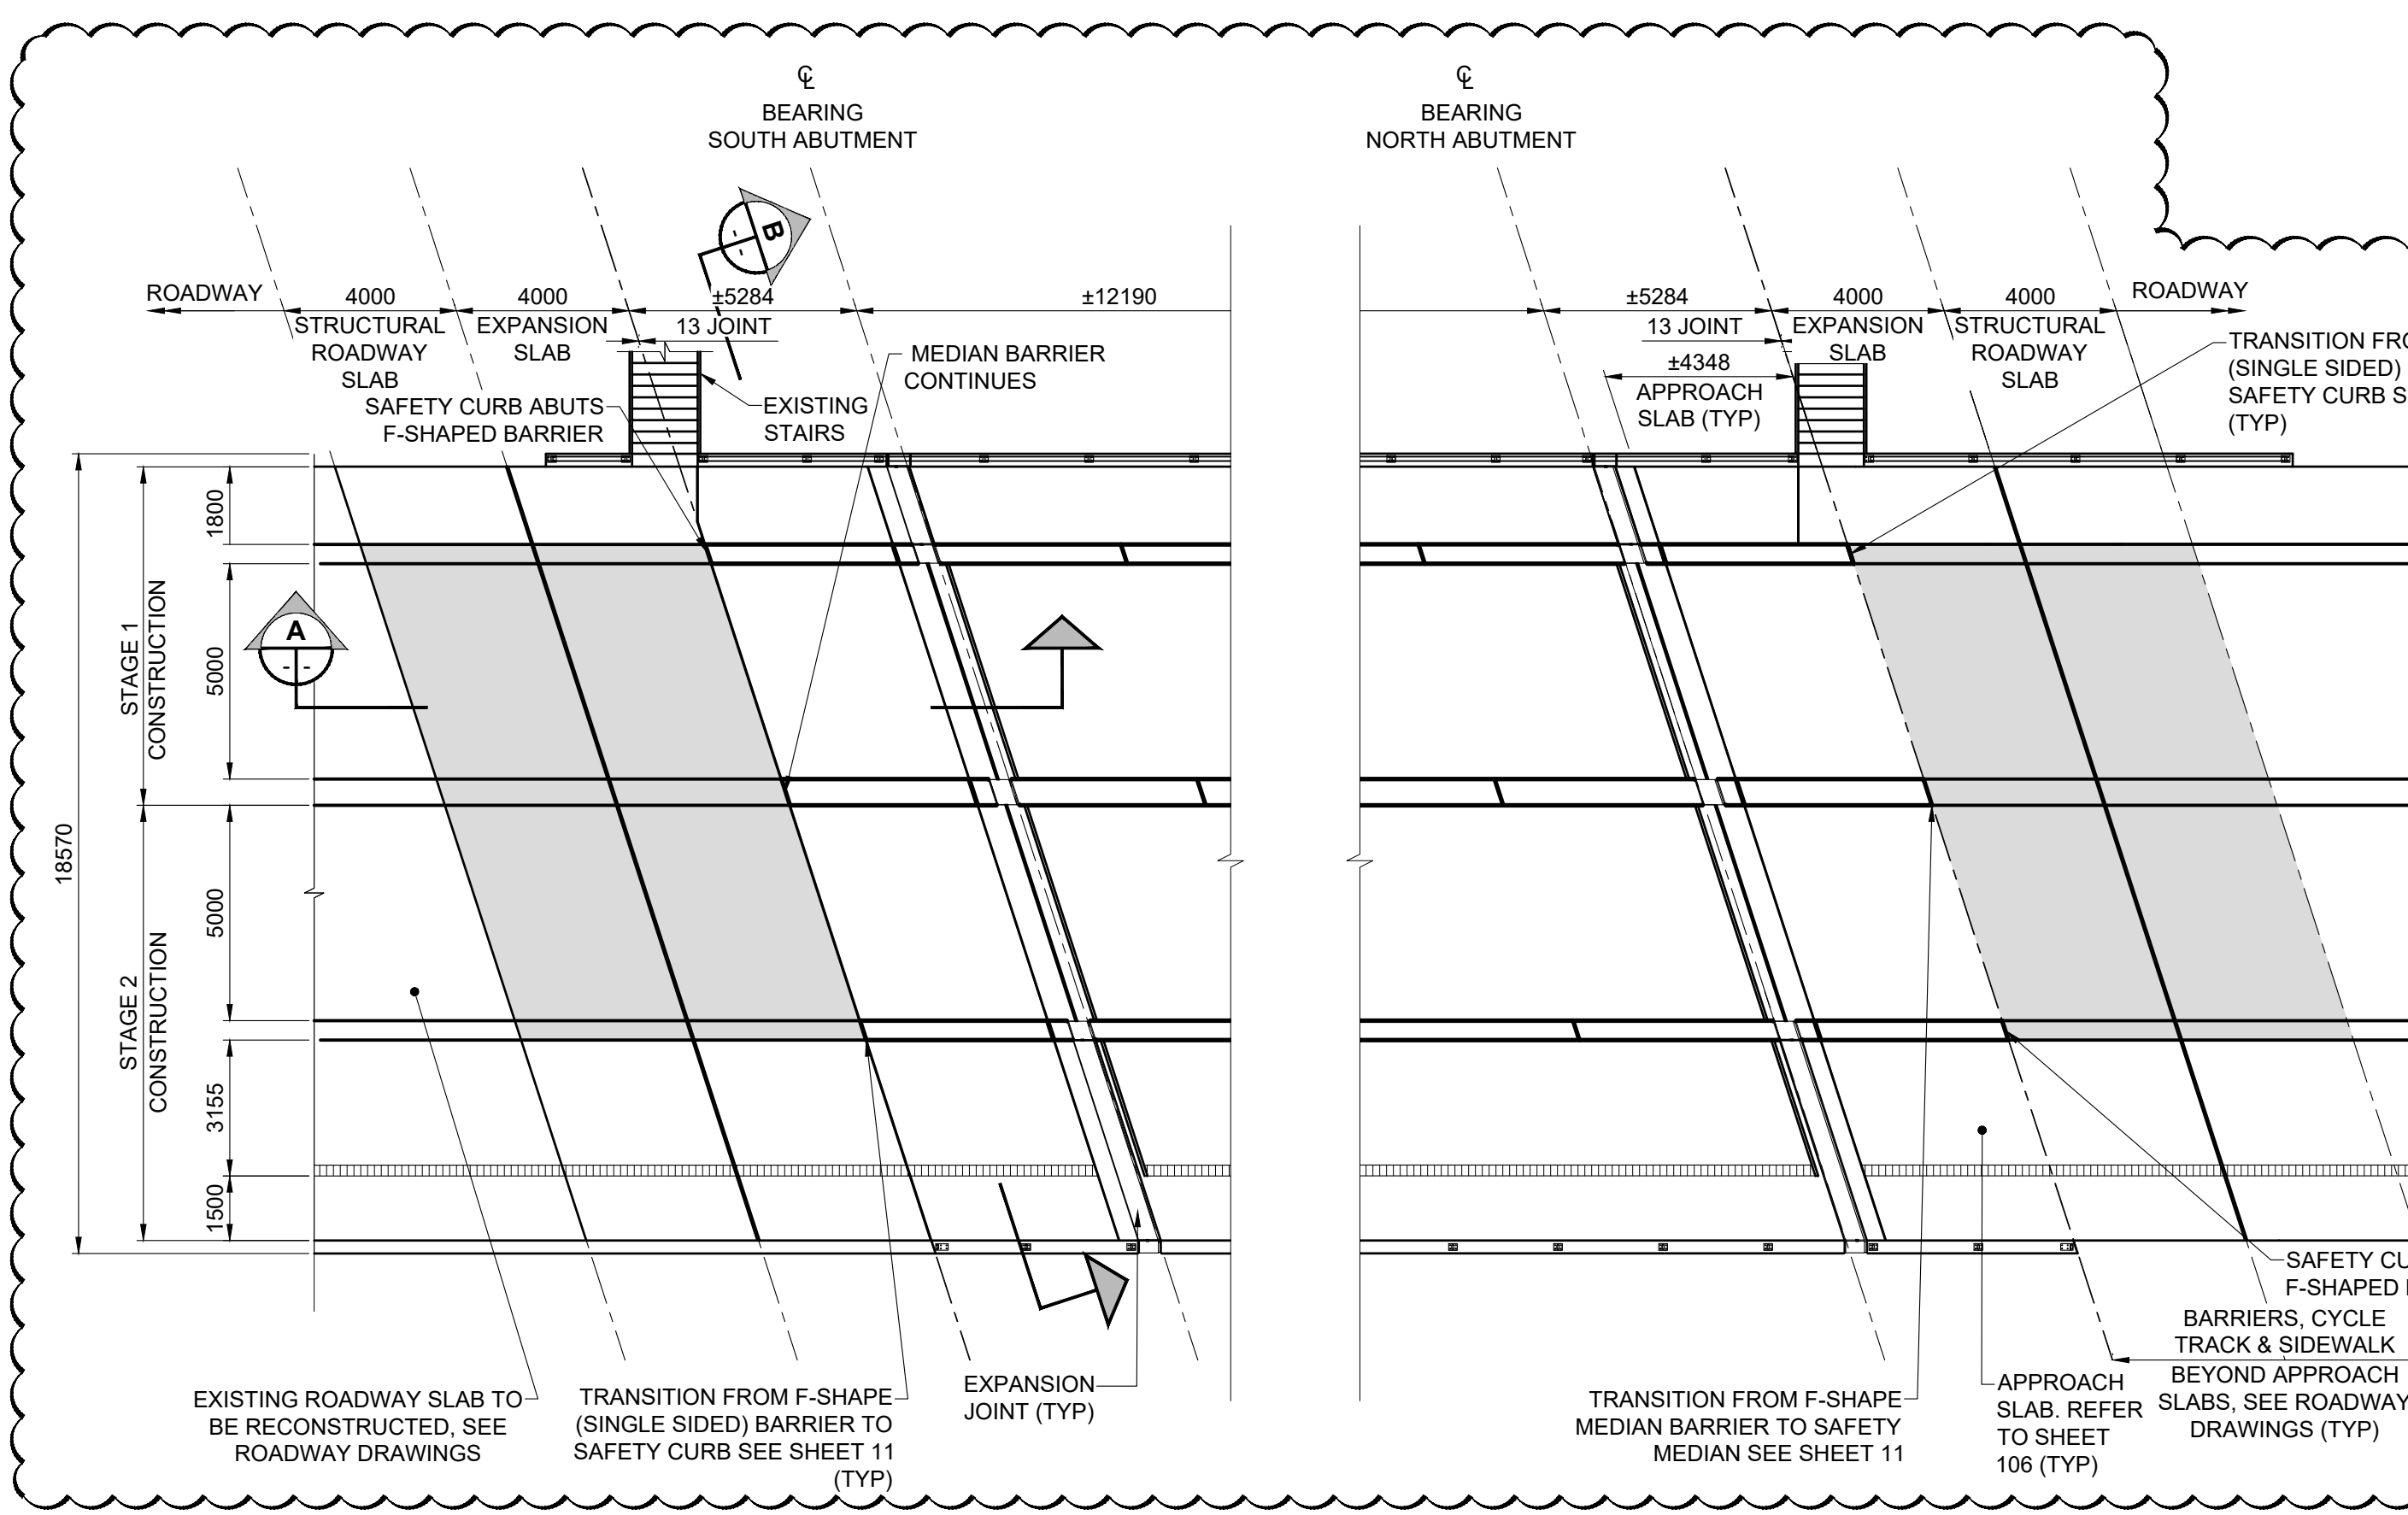

PLAN OF EXPANSION AND ROADWAY SLAB CONSTRUCTION
 SCALE 1:150

NOTE:
 1. FOR BARRIER AND CURB REINFORCING DETAILS SEE SHEET 107.

- LEGEND:**
- NEW CONCRETE
 - SLAB REMOVAL STAGE 1
 - SLAB REMOVAL STAGE 2



METRIC
 WHOLE NUMBERS INDICATE MILLIMETRES
 DECIMALIZED NUMBERS INDICATE METRES


LOCATION APPROVED UNDERGROUND STRUCTURES

DATE: _____

NOTE:
 LOCATION OF UNDERGROUND STRUCTURES AS SHOWN ARE BASED ON THE BEST INFORMATION AVAILABLE BUT NO GUARANTEE IS GIVEN THAT ALL EXISTING UTILITIES ARE SHOWN OR THAT THE GIVEN LOCATIONS ARE EXACT. CONFIRMATION OF EXISTENCE AND EXACT LOCATION OF ALL SERVICES MUST BE OBTAINED FROM THE INDIVIDUAL UTILITIES BEFORE PROCEEDING WITH CONSTRUCTION.

NO.	REVISIONS	DATE	BY
E	ISSUED FOR ADDENDUM 1	18/10/05	BAP
D	ISSUED FOR TENDER	18/09/04	BAP
C	ISSUED FOR 95% DESIGN REVIEW	18/08/07	BAP
B	ISSUED FOR 50% DESIGN REVIEW REV 1	18/06/28	AF
A	ISSUED FOR 50% DESIGN REVIEW	18/04/03	AF

MORRISON HERSHFIELD	
DESIGNED BY: AF	CHECKED BY: YM
DRAWN BY: ALP	APPROVED BY: BE
HOR SCALE: AS SHOWN	RELEASED FOR CONSTRUCTION
VERT SCALE: AS SHOWN	N/A
DATE: _____	DATE: _____

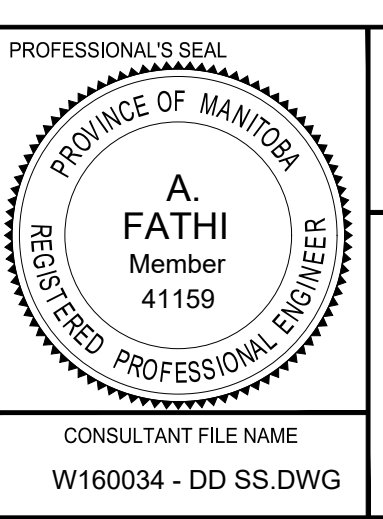

THE CITY OF WINNIPEG PUBLIC WORKS DEPARTMENT ENGINEERING DIVISION

EMPRESS STREET PROJECT OVERPASS REHABILITATION WORKS SUPERSTRUCTURE EXPANSION SLAB AND STRUCTURAL ROADWAY SLAB

CITY DRAWING NUMBER: P-3494-112
 SHEET 112 OF 169
 DRAWING No. 112 REV E

CONSULTANT FILE NAME: W160034 - DD SS.DWG

BID OPPORTUNITY No. 602-2018

O:\Winnipeg\Proj\W160034\Design\11 Drawings\06 Sheets\Deleted\Design\Structural\W160034 - DD SS.dwg Last Saved: 10/05/2018 2:17 PM by: A.Heggenreder Printed: 10/05/2018 3:28 PM by: Alex Heggenreder