


SECTION STA 1+673
 SCALE: 1:50 H 5m
 SCALE 1:50 V 5m

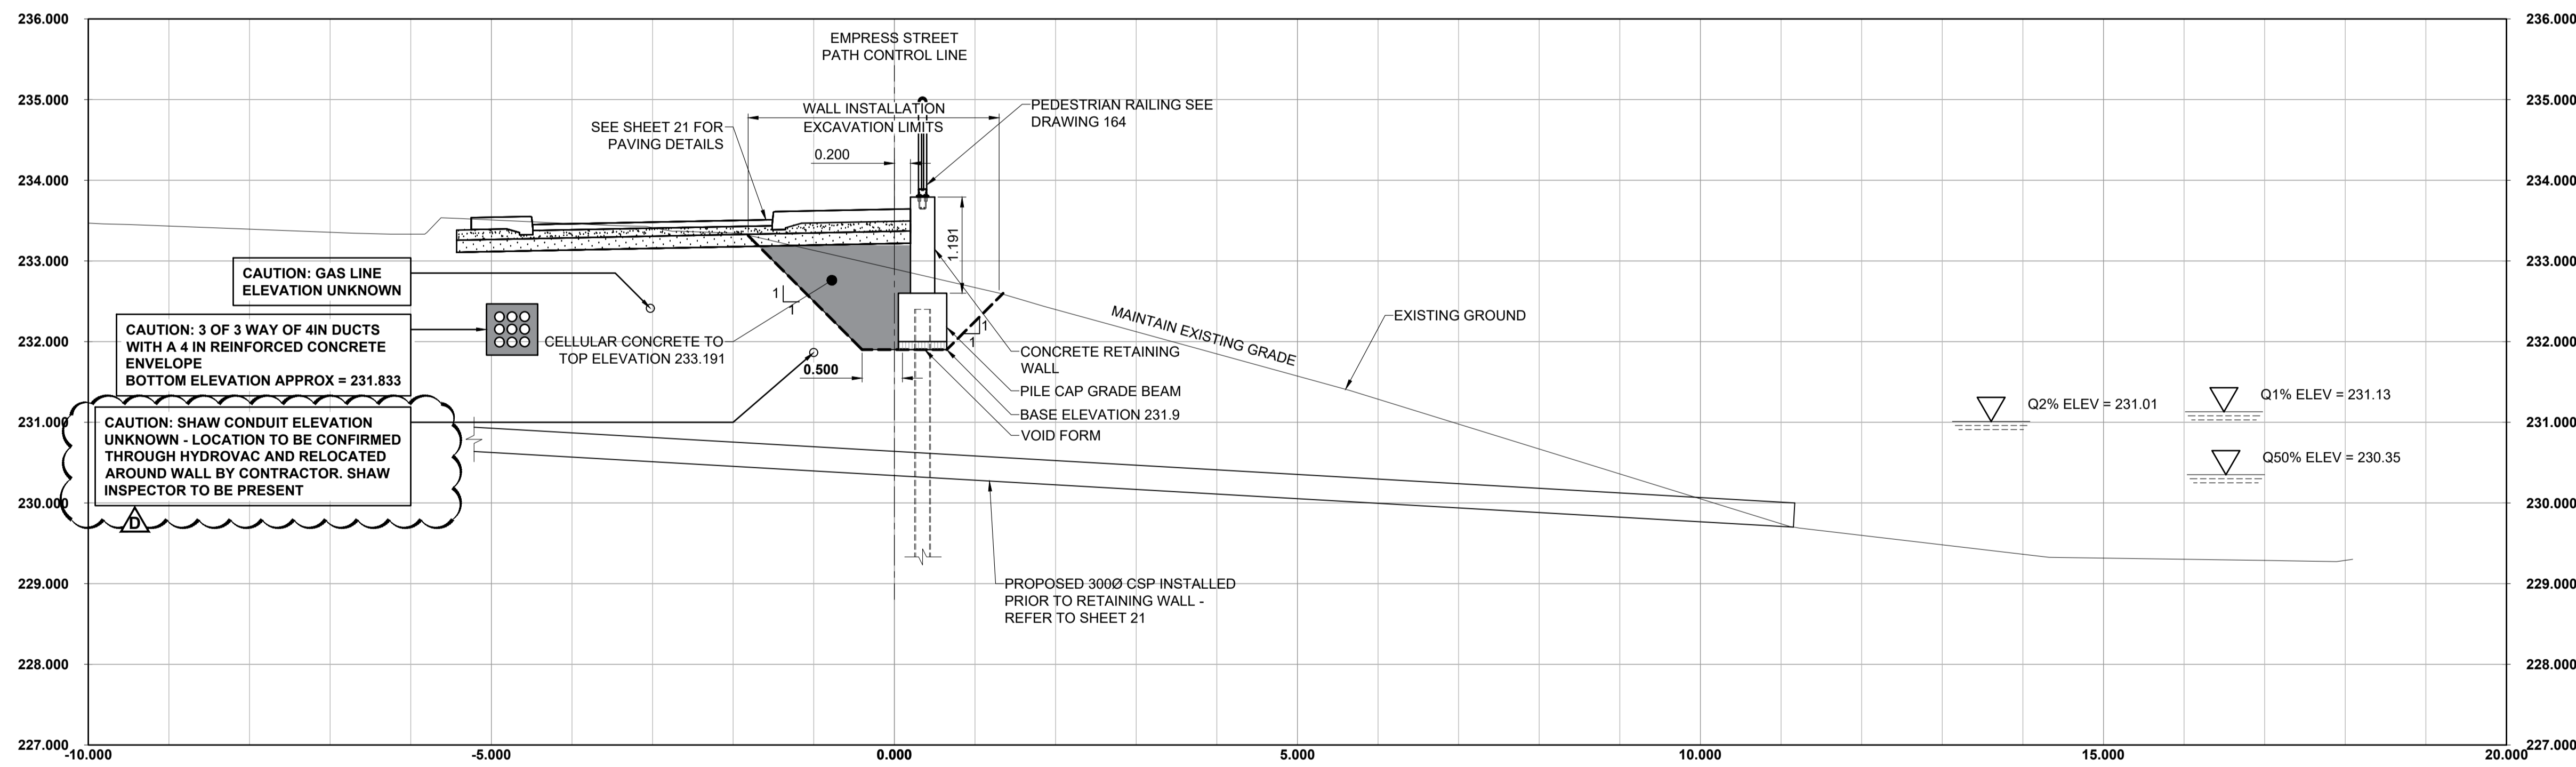

SECTION STA 1+682.15
 SCALE: 1:50 H 5m
 SCALE 1:50 V 5m



METRIC
 WHOLE NUMBERS INDICATE MILLIMETRES
 DECIMALIZED NUMBERS INDICATE METRES

LOCATION APPROVED UNDERGROUND STRUCTURES
 SUPR. U/G STRUCTURES COMMITTEE
 DATE: _____
NOTE:
 LOCATION OF UNDERGROUND STRUCTURES AS SHOWN ARE BASED ON THE BEST INFORMATION AVAILABLE BUT NO GUARANTEE IS GIVEN THAT ALL EXISTING UTILITIES ARE SHOWN OR THAT THE GIVEN LOCATIONS ARE EXACT. CONFIRMATION OF EXISTENCE AND EXACT LOCATION OF ALL SERVICES MUST BE OBTAINED FROM THE INDIVIDUAL UTILITIES BEFORE PROCEEDING WITH CONSTRUCTION.

No.	REVISIONS	DATE	BY
D	ISSUED FOR ADDENDUM 1	18/10/05	BAP
C	ISSUED FOR TENDER	18/09/04	BAP
B	ISSUED FOR 95% DESIGN REVIEW	18/08/07	BAP
A	ISSUED FOR 50% DESIGN REVIEW	18/06/28	BAP

DESIGNED BY	AF	CHECKED BY	BAP
DRAWN BY	TN	APPROVED BY	BAP
RELEASED FOR CONSTRUCTION	N/A		
DATE	DATE		



THE CITY OF WINNIPEG PUBLIC WORKS DEPARTMENT ENGINEERING DIVISION

**EMPERESS STREET PROJECT
 EMPRESS STREET RETAINING WALL
 CROSS SECTIONS 1**

CITY DRAWING NUMBER	P-3494-161
SHEET OF	161 169
DRAWING No.	REV
	161 D