


APPENDIX C – OUTFALL SITE INVESTIGATIONS AND GEOTECHNICAL CONDITIONS

BISHOP GRANDIN OUTFALL – (S-MA70015994)

**800 MILLIMETER DIAMETER LAND DRAINAGE SEWER OUTFALL LOCATED EAST OF ST. ANNES
ROAD AT SEINE RIVER**

S-MA70015994

Job Number:	692-2015	Waterway:	Seine River
Map Number:	65	Asset Location:	133 LAVALEE RD
Flow Type:	LDS	Sewer District:	SOUTHDALE
Inspection Date:	2015-11-12	Surveyed By:	Darren Yarechewski
Physical Details at Time of Inspection			
Size 1 / Height:	mm	Size 2 / Width:	860 mm
Length:	37.71 m	Material:	CMP
Grating Type:	Not Present	Exit Submerged:	Yes
Exit Type:	Straight		
Waterway Shape:	Inland from river		
Sedimentation Level:	25%	Debris in Asset:	
Identified Damage:	Perforated and corroded		
Geotechnical Condition Grades			
Slope Condition Grade:	1	Erosion Condition Grade:	1
Recommended Treatments:	None		
Comments:			

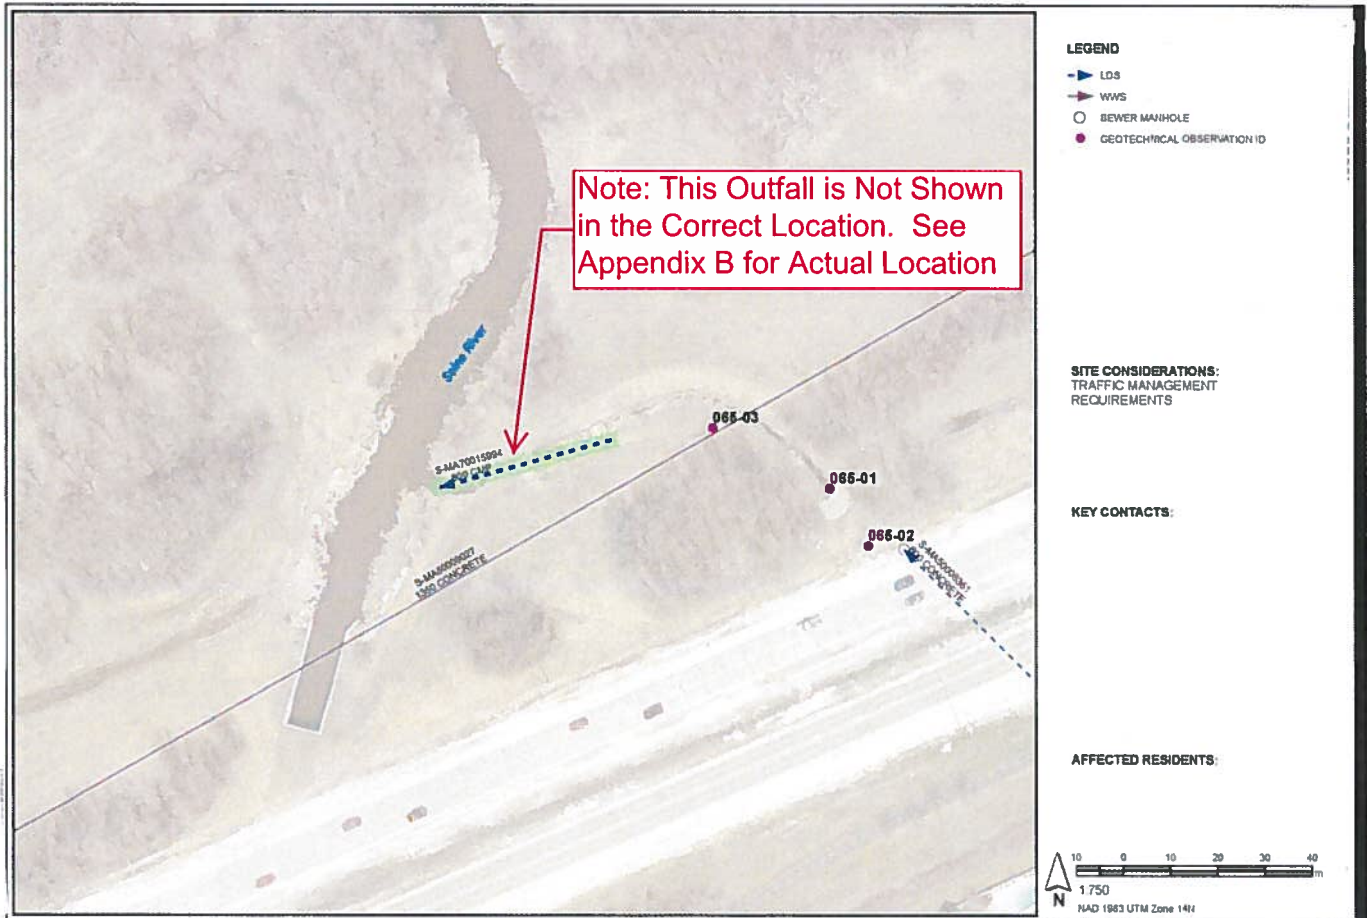

Slope Instability

Instability Type	ID	Location	Angle	Vegetation	Terrain

Existing Rip Rap

ID	Rip Rap Type	Geotextile	Rip Rap Location
065-01	Grouted Rip Rap		Surrounding Outfall Only

Scarps

ID	Height	Location	Angle	Vegetation	Surface Soil

Tension Cracking

ID	Width	Location	Angle	Vegetation	Surface Soil

Gully Erosion

ID	Depth	Width	Location	Angle	Vegetation	Surface Soil

Other Structures Engaged

ID	Structure Type	Crack Width

Miscellaneous

Roadway Location	Upslope of Crest	Wildlife Signs
Bank Debris		

065-01



065-01



065-01



065-02



065-03



065-03




GATEWAY ROAD OUTFALL – (S-MA40003056)

**1825 MILLIMETER DIAMETER LAND DRAINAGE SEWER OUTFALL LOCATED ADJACENT TO 1501
GATEWAY ROAD AT BUNNS CREEK**

S-MA40003056

Job Number:	692-2015	Waterway:	Bunn's Creek
Map Number:	2	Asset Location:	642 GILMORE AV
Flow Type:	LDS	Sewer District:	AREA 1(NE)
Inspection Date:	2015-11-13	Surveyed By:	Darren Yarechewski
Physical Details at Time of Inspection			
Size 1 / Height:	mm	Size 2 / Width:	mm
Length:	91.64 m	Material:	CMP
Grating Type:	Vertical and Horizontal Bars	Exit Submerged:	Yes
Exit Type:	Straight		
Waterway Shape:	Straight		
Sedimentation Level:	%	Debris in Asset:	Garbage
Identified Damage:	Perforated and crushed		
Geotechnical Condition Grades			
Slope Condition Grade:	3	Erosion Condition Grade:	3
Recommended Treatments:	Erosion Protection		
Comments:			

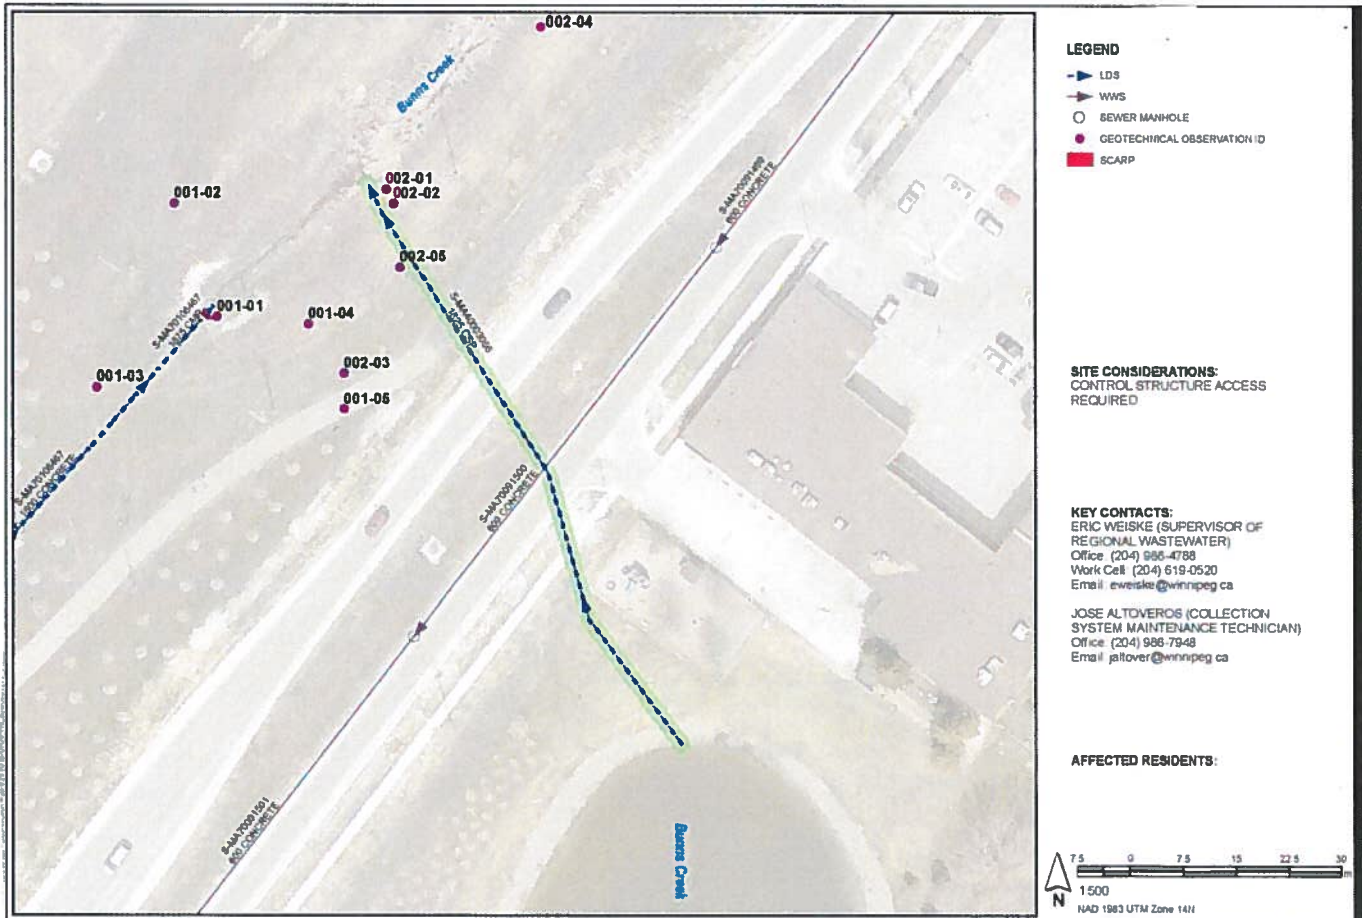

Slope Instability

Instability Type	ID	Location	Angle	Vegetation	Terrain
Slump	002-01	Toe	Moderate	Grass Natural	Graded

Existing Rip Rap

ID	Rip Rap Type	Geotextile	Rip Rap Location

Scarps

ID	Height	Location	Angle	Vegetation	Surface Soil
002-01	1200	Toe	Moderate	Grass Natural	

Tension Cracking

ID	Width	Location	Angle	Vegetation	Surface Soil

Gully Erosion

ID	Depth	Width	Location	Angle	Vegetation	Surface Soil
002-01	1200	1200	Toe	Moderate	Grass Natural	

Other Structures Engaged

ID	Structure Type	Crack Width

Miscellaneous

Roadway Location	Upslope of Crest	Wildlife Signs	
Bank Debris			

Site Condition Summary

ID	Terrain			Geotechnical									Structures	
	Leaning Trees	Bent Trees Creep	Leaning Infrastructure	Toe Bulge	Erosion	Surficial Erosion	Slump Block	Slickenside	Seepage	Softened	Settlement	Standing Water	Instability Coincides with Structure	Instability Coincides with Pipe
Site						Y	Y				Y			
002-01						Y	Y							
002-02														
002-03														
002-04														
002-05											Y			

002-01



002-01



002-01



002-04



002-05



002-05




HENDERSON HIGHWAY OUTFALL – (S-MA40000289)

**1200 MILLIMETER DIAMETER LAND DRAINAGE SEWER OUTFALL LOCATED ADJACENT TO 2033
HENDERSON HIGHWAY AT BUNNS CREEK**

S-MA40000289

Job Number:	692-2015	Waterway:	Bunn's Creek
Map Number:	20	Asset Location:	2065 HENDERSON HWY
Flow Type:	LDS	Sewer District:	AREA 1(NE)
Inspection Date:	2015-10-28	Surveyed By:	Darren Yarechewski
Physical Details at Time of Inspection			
Size 1 / Height:	mm	Size 2 / Width:	1200 mm
Length:	27.52 m	Material:	CMP
Grating Type:	Horizontal Bars	Exit Submerged:	Yes
Exit Type:	Bevelled		
Waterway Shape:	Inside Bend		
Sedimentation Level:	%	Debris in Asset:	
Identified Damage:			
Geotechnical Condition Grades			
Slope Condition Grade:	4	Erosion Condition Grade:	1
Recommended Treatments:			
Comments:			

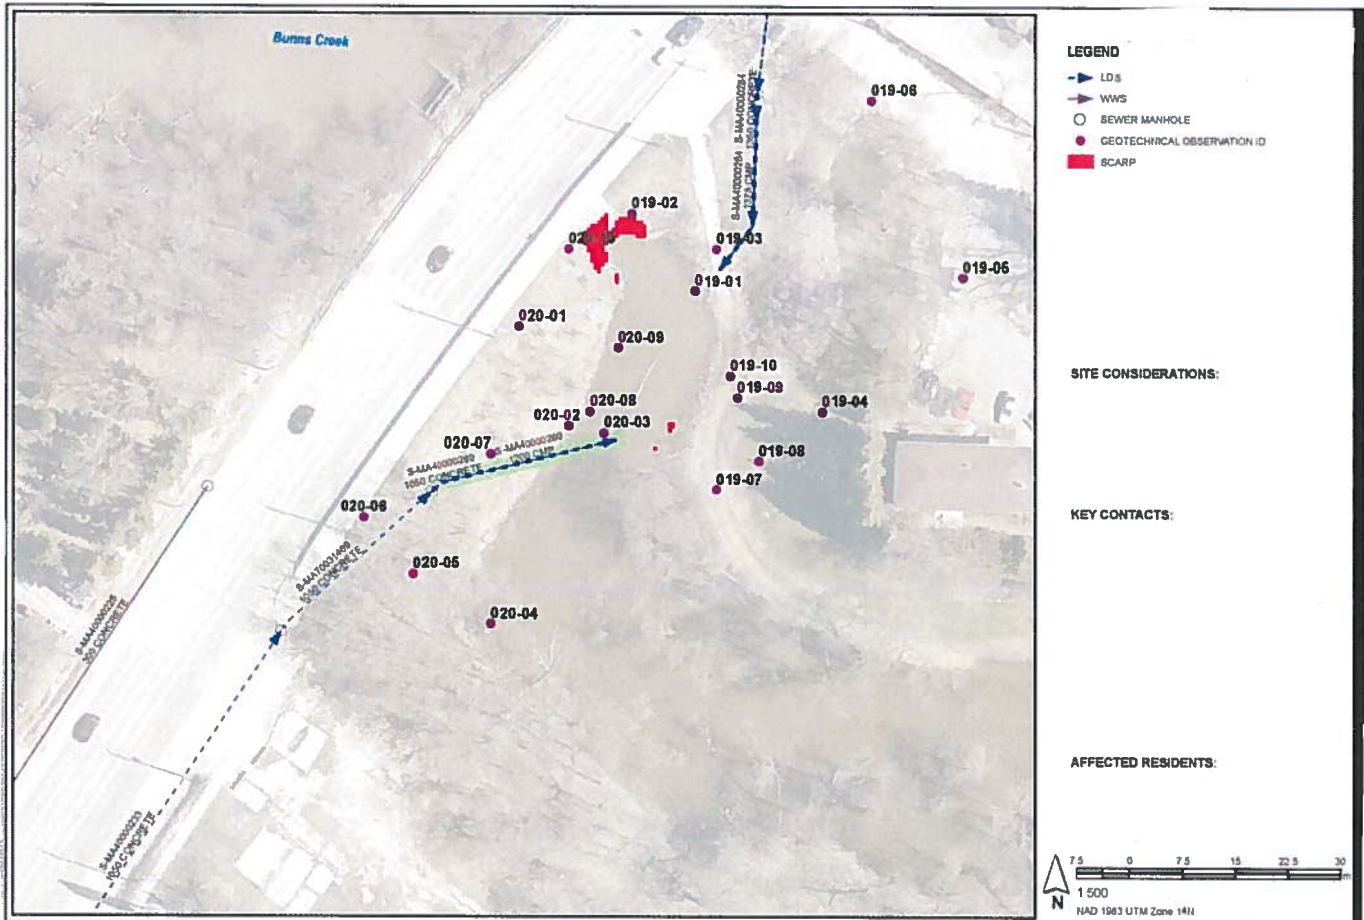

Outfall Asset Number: S-MA40000289 - 27.52m
 Upstream Sewer Asset Number: None - 0m
 Upstream Manhole Coordinates: 638412.6167E, 6636794.7272N
 Location: 2065 HENDERSON HWY

LEGEND
 - LDS
 - WWS
 ○ SEWER MANHOLE
 ● GEOTECHNICAL OBSERVATION ID
 ■ SCARP

SITE CONSIDERATIONS:

KEY CONTACTS:

AFFECTED RESIDENTS:



Slope Instability

Instability Type	ID	Location	Angle	Vegetation	Terrain
Rotation	020-05	Mid Slope	Steep	Small Trees	Graded

Existing Rip Rap

ID	Rip Rap Type	Geotextile	Rip Rap Location
020-02	Loose Rip Rap	Yes	
020-03	Loose Rip Rap	Yes	Surrounding Outfall and Along River Length
020-04	Loose Rip Rap		
020-09	Loose Rip Rap	Yes	

Scarps

ID	Height	Location	Angle	Vegetation	Surface Soil

Tension Cracking

ID	Width	Location	Angle	Vegetation	Surface Soil

Gully Erosion

ID	Depth	Width	Location	Angle	Vegetation	Surface Soil

Other Structures Engaged

ID	Structure Type	Crack Width
020-05	Manhole	
020-07	Gas line test post	

Miscellaneous

Roadway Location	Upslope of Crest	Wildlife Signs	
Bank Debris			

020-03



020-03



020-03



020-04



020-07



020-09




HINDLEY AVENUE OUTFALL – (S-MA50018567)

**525 MILLIMETER DIAMETER LAND DRAINAGE SEWER OUTFALL LOCATED AT THE EAST END
OF HINDLEY AVENUE AT SEINE RIVER**

S-MA50018567

Job Number:	692-2015	Waterway:	Seine River
Map Number:	82	Asset Location:	241 HINDLEY AVE
Flow Type:	LDS	Sewer District:	MAGER
Inspection Date:	2015-11-05	Surveyed By:	Darren Yarechewski
Physical Details at Time of Inspection			
Size 1 / Height:	mm	Size 2 / Width:	540 mm
Length:	32.42 m	Material:	CMP
Grating Type:	Not Present	Exit Submerged:	Yes
Exit Type:	Bevelled		
Waterway Shape:	Outside Bend		
Sedimentation Level:	%	Debris in Asset:	Trees
Identified Damage:	Separation		
Geotechnical Condition Grades			
Slope Condition Grade:	4	Erosion Condition Grade:	5
Recommended Treatments:	Erosion Protection		
Comments:			

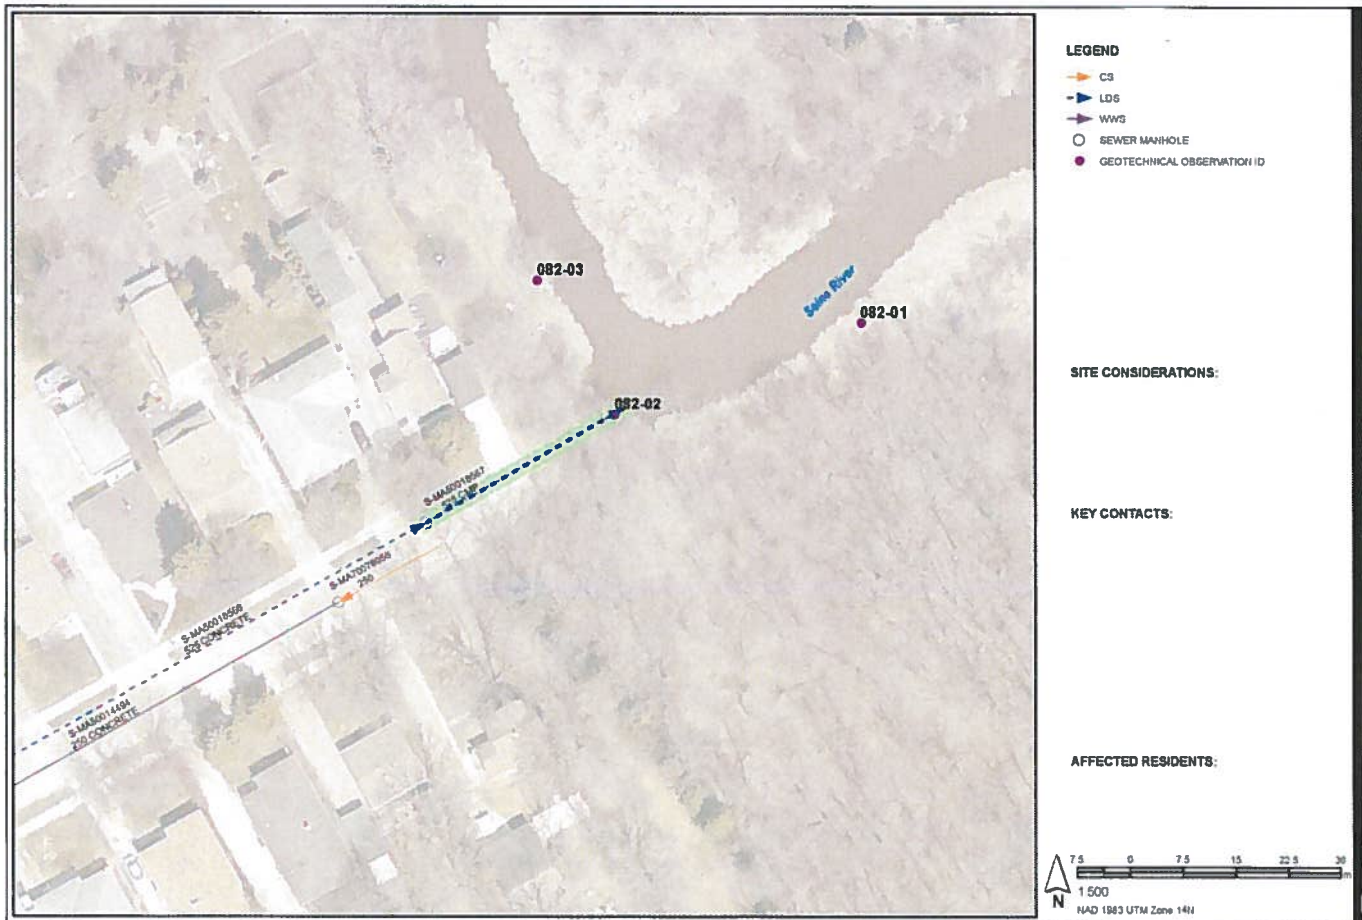

Slope Instability

Instability Type	ID	Location	Angle	Vegetation	Terrain
Rotation	082-03	Toe	Steep	Grass Natural	Hummocky
Slump	082-02	Toe	Steep	Small Trees	Graded

Existing Rip Rap

ID	Rip Rap Type	Geotextile	Rip Rap Location
082-02	Concrete-filled sandbags	No	Surrounding Outfall Only
082-03	Concrete Rubble		

Scarps

	ID	Height	Location	Angle	Vegetation	Surface Soil
	082-02	1000	Toe	Steep	Small Trees	Clay
	082-03	1200	Toe	Steep	Grass Natural	Clay

Tension Cracking

	ID	Width	Location	Angle	Vegetation	Surface Soil

Gully Erosion

	ID	Depth	Width	Location	Angle	Vegetation	Surface Soil

Other Structures Engaged

ID	Structure Type	Crack Width

Miscellaneous

Roadway Location	Upslope of Crest	Wildlife Signs	
Bank Debris			

Site Condition Summary

ID	Terrain			Geotechnical									Structures	
	Leaning Trees	Bent Trees Creep	Leaning Infrastructure	Toe Bulge	Erosion	Surficial Erosion	Slump Block	Slickenside	Seepage	Softened	Settlement	Standing Water	Instability Coincides with Structure	Instability Coincides with Pipe
Site	Y	Y		Y	Y	Y	Y							Y
082-01														
082-02	Y	Y		Y	Y	Y	Y							Y
082-03	Y	Y		Y	Y		Y							

082-01



082-02



082-02



082-02



082-02



082-03




JAE EADIE PARK OUTFALL – (S-MA20008967)

**2340 MILLIMETER DIAMETER COMBINED SEWER OUTFALL LOCATED BEHIND 146 RIVERBEND
CRESCENT AT ASSINIBOINE RIVER**

S-MA20008967

Job Number:	692-2015	Waterway:	Assiniboine River
Map Number:	263	Asset Location:	125 PARKSIDE DR
Flow Type:	CS	Sewer District:	RIVERBEND
Inspection Date:	2015-10-13	Surveyed By:	Darren Yarechewski
Physical Details at Time of Inspection			
Size 1 / Height:	mm	Size 2 / Width:	mm
Length:	41.26 m	Material:	CMP
Grating Type:	Not Present	Exit Submerged:	Yes
Exit Type:	Bevelled		
Waterway Shape:	Outside Bend		
Sedimentation Level:	%	Debris in Asset:	
Identified Damage:	Crushed		
Geotechnical Condition Grades			
Slope Condition Grade:	4	Erosion Condition Grade:	5
Recommended Treatments:	Erosion Protection		
Comments:			

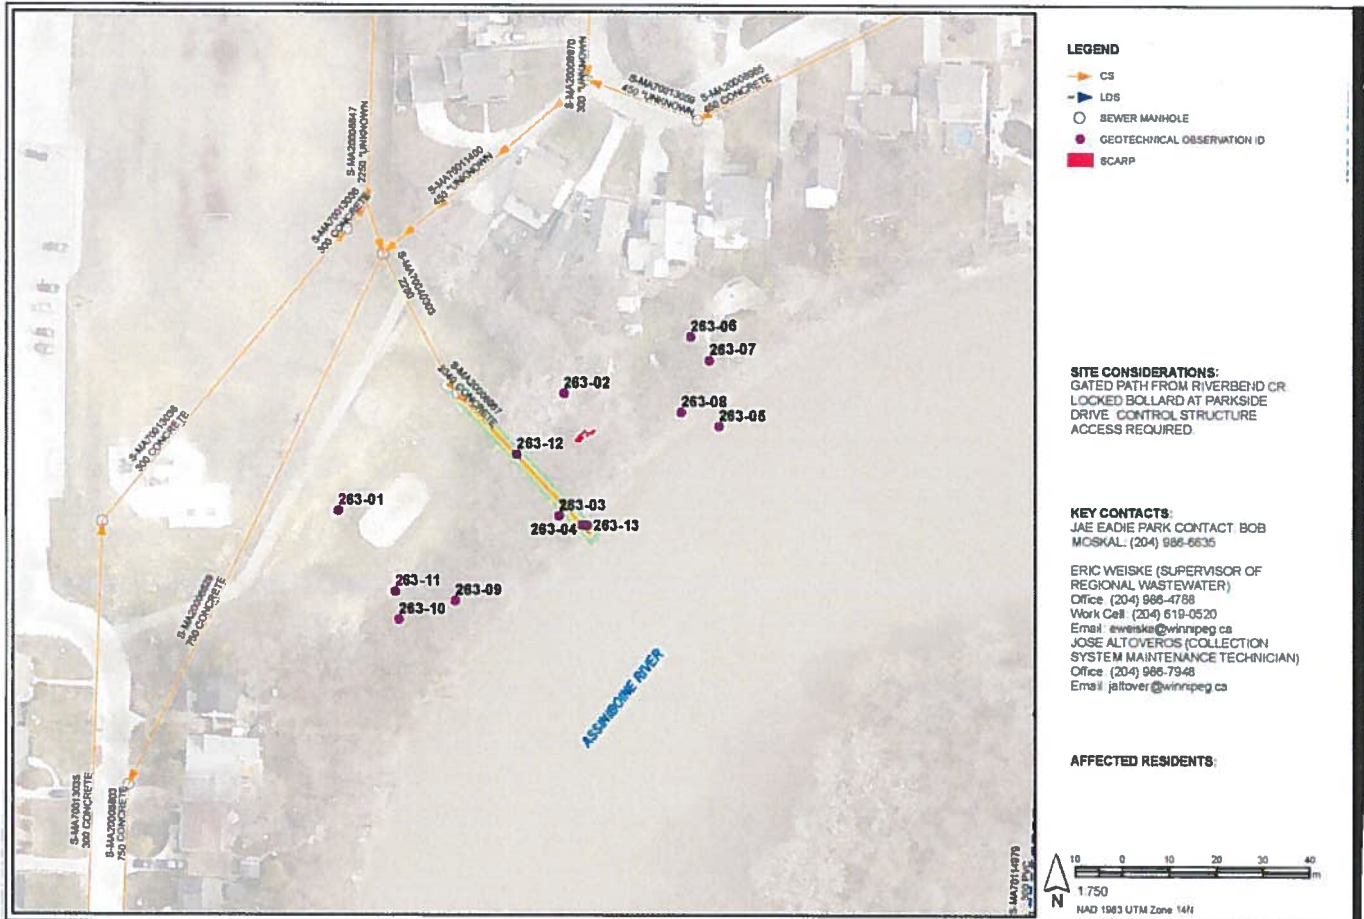

Outfall Asset Number: S-MA20008967 - 41.26m
Upstream Sewer Asset Number: None - 0m
Upstream Manhole Coordinates: 828711.4598E, 6626506.0328N
Location: 125 PARKSIDE DR

Slope Instability

Instability Type	ID	Location	Angle	Vegetation	Terrain
Retrogressive	263-10	Crest	Steep	Small Trees	Natural
Slump	263-04	Toe	Steep	Large Trees	Natural
Slump	263-09	Mid Slope	Steep	Large Trees	Natural

Existing Rip Rap

ID	Rip Rap Type	Geotextile	Rip Rap Location
263-04	Loose Rip Rap	No	Invert and Sides

Scarps

	ID	Height	Location	Angle	Vegetation	Surface Soil
	263-04	3000	Toe	Steep	Large Trees	
	263-05	1800	Toe	Vertical	Small Trees	
	263-07	6000	Crest			
	263-09	3000	Mid Slope	Steep	Large Trees	
	263-10	1000	Crest	Steep	Small Trees	

Tension Cracking

	ID	Width	Location	Angle	Vegetation	Surface Soil

Gully Erosion

	ID	Depth	Width	Location	Angle	Vegetation	Surface Soil
	263-11	150	400	Crest	Steep	Grass Natural	

Other Structures Engaged

ID	Structure Type	Crack Width
263-06	Retaining Wall	
263-07	Fence	

Miscellaneous

Roadway Location	Downslope of Crest	Wildlife Signs	
Bank Debris	Trees Lumber		

263-04



263-04



263-05



263-07



263-09



263-10




NORTH DRIVE OUTFALL – (S-MA60013422)

**1200 MILLIMETER DIAMETER LAND DRAINAGE SEWER OUTFALL LOCATED NORTH OF
WILDWOOD PARK B AT RED RIVER**

S-MA60013422

Job Number:	692-2015	Waterway:	Red River
Map Number:	163	Asset Location:	WILDWOOD B PK & NORTH DR
Flow Type:	LDS	Sewer District:	WILLOW
Inspection Date:	2015-10-22	Surveyed By:	Darren Yarechewski
Physical Details at Time of Inspection			
Size 1 / Height:	mm	Size 2 / Width:	1200 mm
Length:	129.89 m	Material:	CMP
Grating Type:	Not Present	Exit Submerged:	Yes
Exit Type:	Bevelled		
Waterway Shape:	Straight		
Sedimentation Level:	40%	Debris in Asset:	
Identified Damage:	Corroded and perforated.		
Geotechnical Condition Grades			
Slope Condition Grade:	5	Erosion Condition Grade:	3
Recommended Treatments:	Erosion and Stabilization		
Comments:			

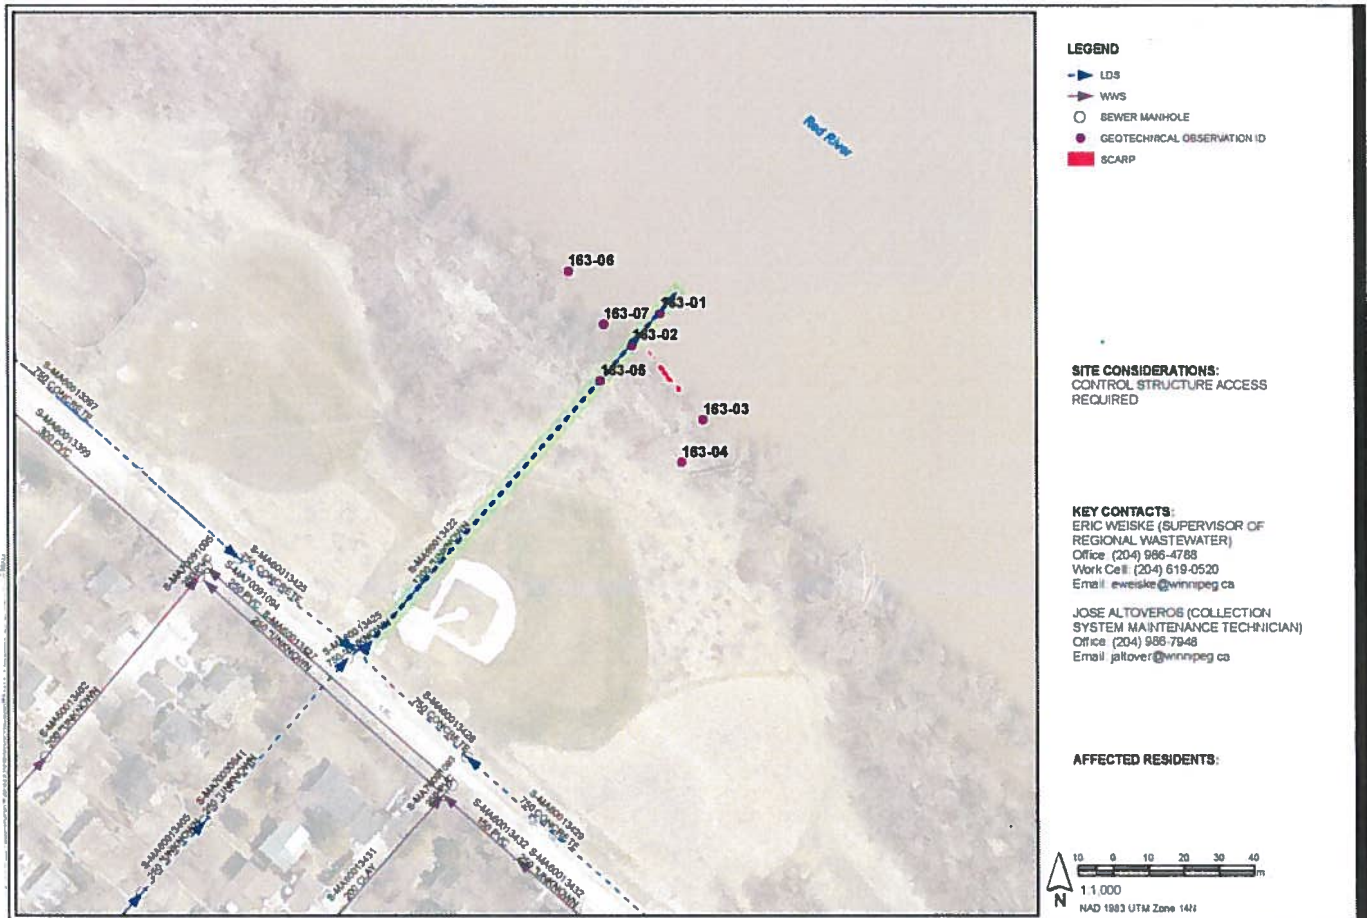

Slope Instability

Instability Type	ID	Location	Angle	Vegetation	Terrain
Planar	163-03	Mid Slope	Moderate	Large Trees	Natural
Retrogressive	163-01	Toe	Vertical	Large Trees	Natural
Retrogressive	163-06	Mid Slope	Steep	Large Trees	Natural
Retrogressive	163-07	Mid Slope	Moderate	Large Trees	Natural
Rotation	163-04	Mid Slope	Moderate	Large Trees	Natural

Existing Rip Rap

ID	Rip Rap Type	Geotextile	Rip Rap Location
163-01	Concrete Rubble	No	Surrounding Outfall Only

Scarps

	ID	Height	Location	Angle	Vegetation	Surface Soil
	163-01	300	Toe	Vertical	Large Trees	Clay
	163-02	1200	Mid Slope	Steep	Large Trees	
	163-03	300	Mid Slope	Moderate	Large Trees	Clay
	163-04	1800	Mid Slope	Moderate	Large Trees	
	163-05	1500	Mid Slope	Moderate	Large Trees	
	163-06	300	Mid Slope	Steep	Large Trees	
	163-07	300	Mid Slope	Moderate	Large Trees	

Tension Cracking

	ID	Width	Location	Angle	Vegetation	Surface Soil
	163-07	50	Mid Slope	Moderate	Large Trees	

Gully Erosion

	ID	Depth	Width	Location	Angle	Vegetation	Surface Soil

Other Structures Engaged

ID	Structure Type	Crack Width

Miscellaneous

Roadway Location		Wildlife Signs	
Bank Debris			

Site Condition Summary

ID	Terrain			Geotechnical									Structures	
	Leaning Trees	Bent Trees Creep	Leaning Infrastructure	Toe Bulge	Erosion	Surficial Erosion	Slump Block	Slickenside	Seepage	Softened	Settlement	Standing Water	Instability Coincides with Structure	Instability Coincides with Pipe
Site	Y	Y		Y	Y		Y							Y
163-01	Y	Y			Y		Y							Y
163-02	Y				Y									
163-03	Y	Y					Y							
163-04	Y						Y							
163-05	Y	Y					Y							
163-06	Y				Y		Y							
163-07				Y	Y		Y							Y

163-01



163-01



163-01



163-01



163-06



163-07




PEMBINA HIGHWAY OUTFALL – (S-MA70028476)

**450 MILLIMETER DIAMETER LAND DRAINAGE SEWER OUTFALL LOCATED SOUTH OF DE
L'EGlise AVENUE AT LA SALLE RIVER**

S-MA70028476

Job Number:	692-2015	Waterway:	La Salle River
Map Number:	142	Asset Location:	3564 PEMBINA HWY
Flow Type:	LDS	Sewer District:	ST NORBERT
Inspection Date:	2015-10-20	Surveyed By:	Darren Yarechewski
Physical Details at Time of Inspection			
Size 1 / Height:	mm	Size 2 / Width:	450 mm
Length:	61.8 m	Material:	CMP
Grating Type:	Not Present	Exit Submerged:	
Exit Type:	Straight		
Waterway Shape:	Outside Bend		
Sedimentation Level:	0%	Debris in Asset:	
Identified Damage:	Corroded and perforated		
Geotechnical Condition Grades			
Slope Condition Grade:	2	Erosion Condition Grade:	1
Recommended Treatments:	None		
Comments:			

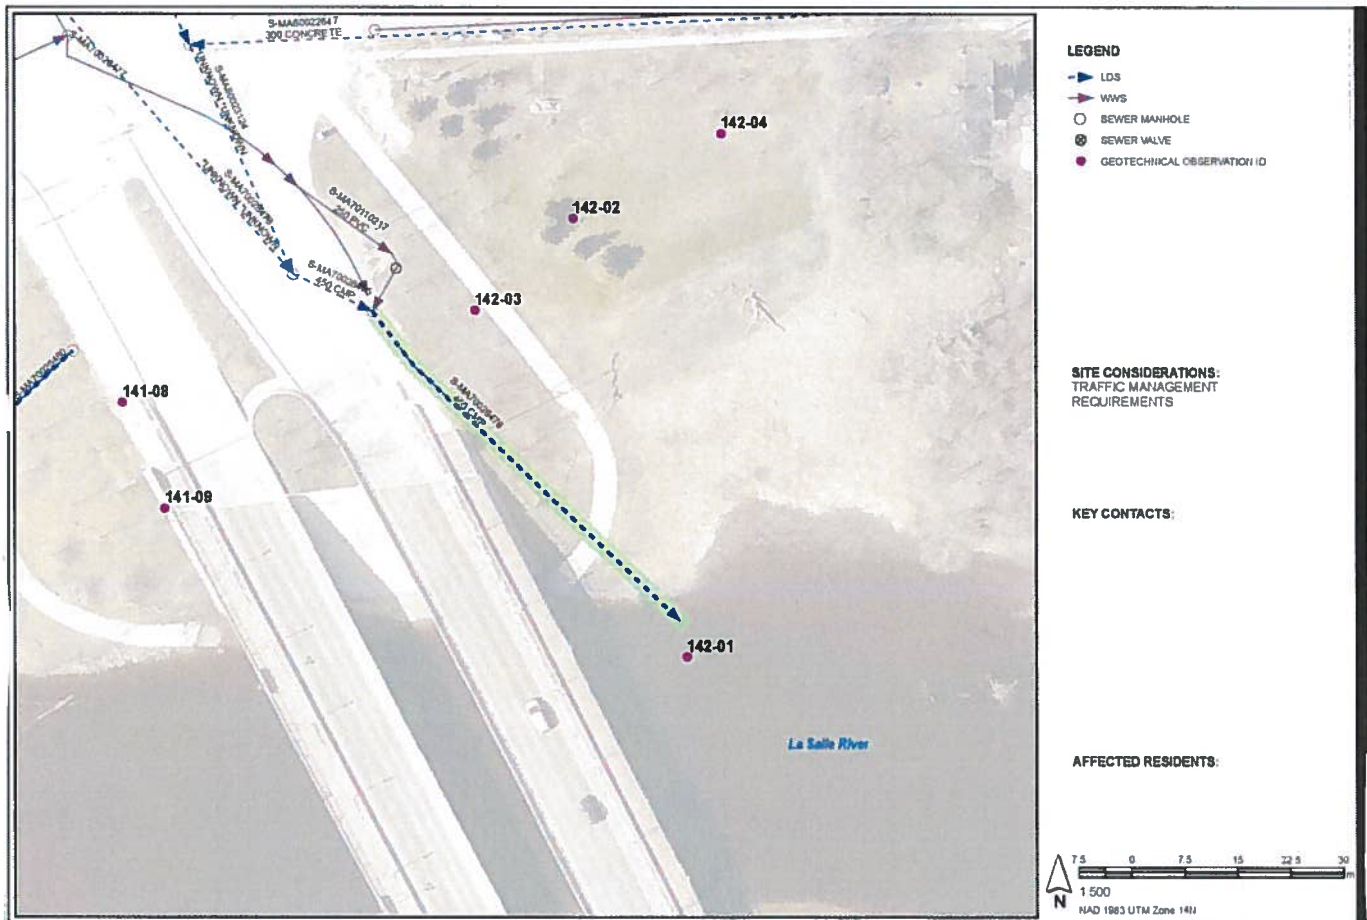

Slope Instability

Instability Type	ID	Location	Angle	Vegetation	Terrain

Existing Rip Rap

ID	Rip Rap Type	Geotextile	Rip Rap Location
142-01	Loose Rip Rap	No	Surrounding Outfall and Along River Length

Scarps

ID	Height	Location	Angle	Vegetation	Surface Soil

Tension Cracking

ID	Width	Location	Angle	Vegetation	Surface Soil

Gully Erosion

ID	Depth	Width	Location	Angle	Vegetation	Surface Soil

Other Structures Engaged

ID	Structure Type	Crack Width

Miscellaneous

Roadway Location	Upslope of Crest	Wildlife Signs
Bank Debris		

142-01



142-01



142-02



142-03



142-03



142-04




RED RIVER BOULEVARD OUTFALL – (S-MA00000073)

**750 MILLIMETER DIAMETER LAND DRAINAGE SEWER OUTFALL LOCATED AT THE EAST END
OF RED RIVER BOULEVARD AT RED RIVER**

S-MA00000073

Job Number:	692-2015	Waterway:	Red River
Map Number:	340	Asset Location:	219 MCBETH GROVE
Flow Type:	LDS	Sewer District:	AREA 9.1
Inspection Date:	2015-10-28	Surveyed By:	Darren Yarechewski
Physical Details at Time of Inspection			
Size 1 / Height:	mm	Size 2 / Width:	750 mm
Length:	81 m	Material:	CMP
Grating Type:	Not Present	Exit Submerged:	Yes
Exit Type:	Bevelled		
Waterway Shape:	Inside Bend		
Sedimentation Level:	40%	Debris in Asset:	
Identified Damage:			
Geotechnical Condition Grades			
Slope Condition Grade:	3	Erosion Condition Grade:	2
Recommended Treatments:	None		
Comments:			

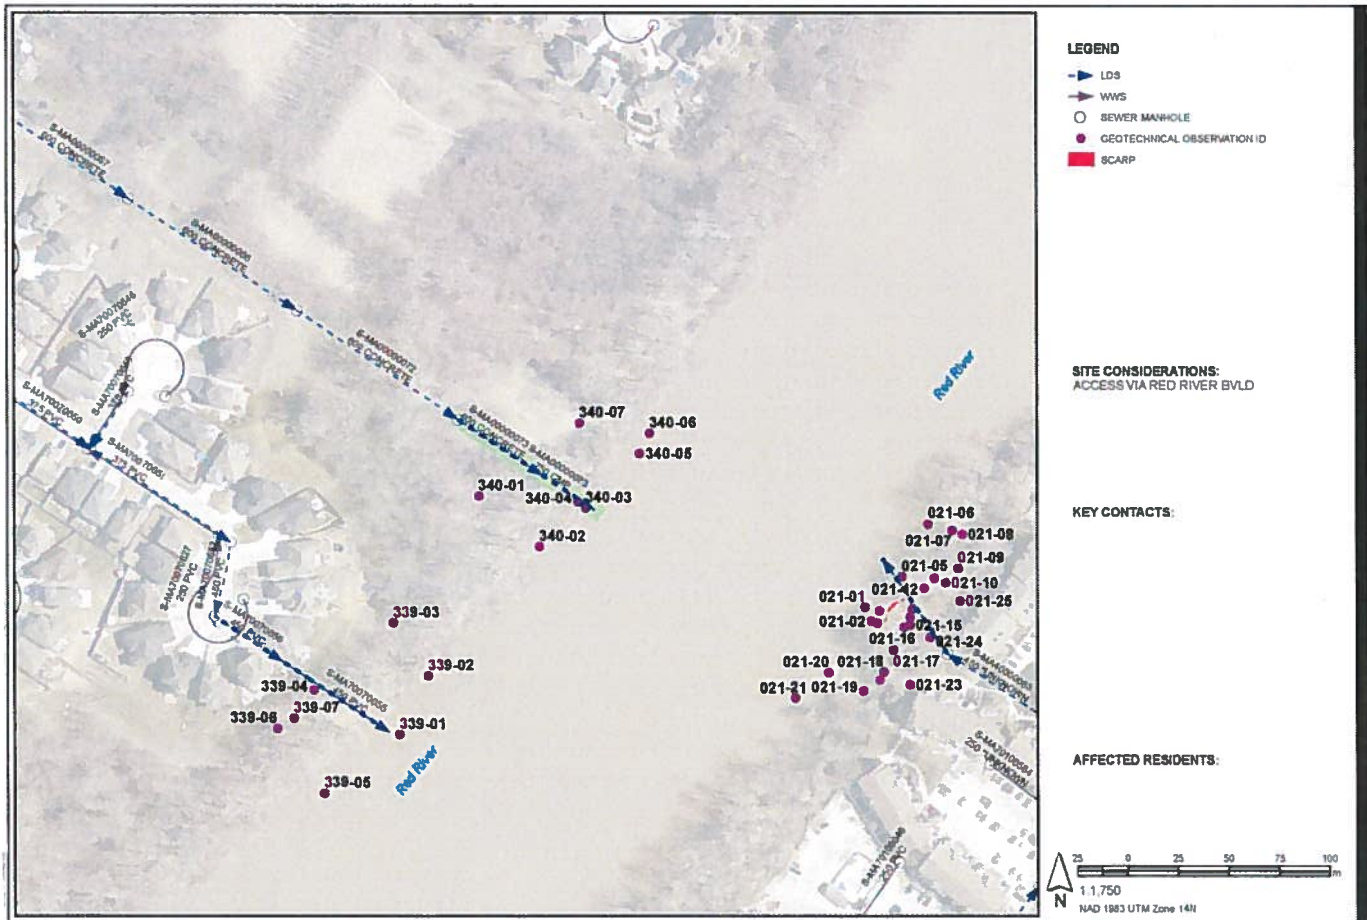

Outfall Asset Number: S-MA00000073 - 81m
 Upstream Sewer Asset Number: None - 0m
 Upstream Manhole Coordinates: 637625.7948E, 6536510.7864N
 Location: 219 MCBETH GROVE

Slope Instability

Instability Type	ID	Location	Angle	Vegetation	Terrain
Creep	340-02	Mid Slope	Moderate	Large Trees	Natural
Planar	340-05	Toe	Moderate	Large Trees	Natural
Planar	340-06	Toe	Moderate	Large Trees	Natural

Existing Rip Rap

ID	Rip Rap Type	Geotextile	Rip Rap Location
340-03	Grouted Rip Rap	Not Observed	Surrounding Outfall Only

Scarps

	ID	Height	Location	Angle	Vegetation	Surface Soil
	340-02	800	Mid Slope	Moderate	Large Trees	Silt
	340-05	1000	Toe	Moderate	Large Trees	Silt
	340-06	800	Toe	Moderate	Large Trees	Silt

Tension Cracking

	ID	Width	Location	Angle	Vegetation	Surface Soil

Gully Erosion

	ID	Depth	Width	Location	Angle	Vegetation	Surface Soil

Other Structures Engaged

ID	Structure Type	Crack Width

Miscellaneous

Roadway Location	Wildlife Signs
Bank Debris	

340-02



340-03



340-03



340-03



340-03



340-05




ST. CHARLES STREET OUTFALL – (S-MA20003569)

**900 MILLIMETER DIAMETER LAND DRAINAGE SEWER OUTFALL LOCATED AT THE SOUTH END
OF ST. CHARLES STREET AT ASSINIBOINE RIVER**

S-MA20003569

Job Number:	692-2015	Waterway:	Assiniboine River
Map Number:	219	Asset Location:	330 ST CHARLES
Flow Type:	LDS	Sewer District:	ST CHARLES
Inspection Date:	2015-10-07	Surveyed By:	Darren Yarechewski
Physical Details at Time of Inspection			
Size 1 / Height:	900 mm	Size 2 / Width:	900 mm
Length:	92.03 m	Material:	CMP
Grating Type:	Not Present	Exit Submerged:	
Exit Type:	Straight		
Waterway Shape:	Outside Bend		
Sedimentation Level:	0%	Debris in Asset:	
Identified Damage:			
Geotechnical Condition Grades			
Slope Condition Grade:	2	Erosion Condition Grade:	3
Recommended Treatments:	Erosion Protection		
Comments:			

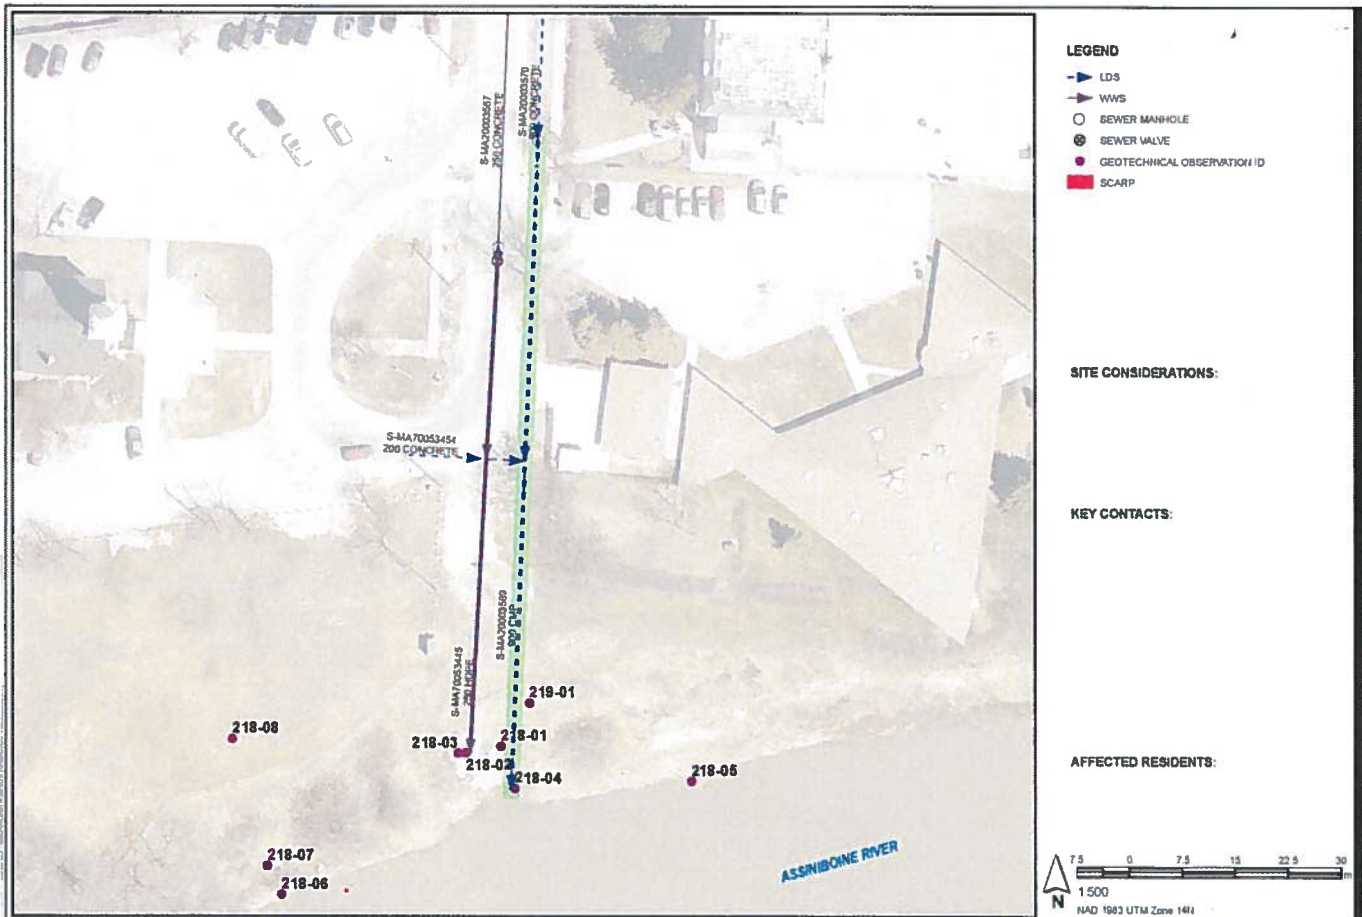

Outfall Asset Number: S-MA20003569 - 92.03m
 Upstream Sewer Asset Number: None - 0m
 Upstream Manhole Coordinates: 820687.3039E, 6626948.6722N
 Location: 330 ST CHARLES

Slope Instability

Instability Type	ID	Location	Angle	Vegetation	Terrain

Existing Rip Rap

ID	Rip Rap Type	Geotextile	Rip Rap Location
218-01	Grouted Rip Rap		Surrounding Outfall Only
218-02	Grouted Rip Rap	Not Observed	Surrounding Outfall Only
218-04	Loose Rip Rap	No	Invert Only

Scarps

	ID	Height	Location	Angle	Vegetation	Surface Soil
	218-05	1100	Toe	Vertical	Grass Natural	Clay
	218-06	1200	Toe	Vertical	Grass Natural	
	218-07	900	Mid Slope	Moderate	Grass Natural	

Tension Cracking

	ID	Width	Location	Angle	Vegetation	Surface Soil

Gully Erosion

	ID	Depth	Width	Location	Angle	Vegetation	Surface Soil
	218-04	700	2100	Toe	Moderate	Grass Natural	Clay

Other Structures Engaged

ID	Structure Type	Crack Width

Miscellaneous

Roadway Location	Wildlife Signs
Bank Debris	

219-01



219-04



219-04



219-04



219-05



219-06




VALLEY VIEW DRIVE OUTFALL – (S-MA20000078)

**400 MILLIMETER DIAMETER LAND DRAINAGE SEWER OUTFALL LOCATED BETWEEN 40 AND 38
VALLEY VIEW DRIVE AT STURGEON CREEK (ABANDONMENT)**

S-MA20000078

Job Number:	692-2015	Waterway:	Sturgeon Creek
Map Number:	240	Asset Location:	38 VALLEY VIEW DR
Flow Type:	LDS	Sewer District:	HERITAGE
Inspection Date:	2015-10-08	Surveyed By:	Darren Yarechewski
Physical Details at Time of Inspection			
Size 1 / Height:	475 mm	Size 2 / Width:	475 mm
Length:	59.1 m	Material:	AC
Grating Type:	Not Present	Exit Submerged:	
Exit Type:	Straight		
Waterway Shape:	Straight		
Sedimentation Level:	0%	Debris in Asset:	
Identified Damage:	Missing End Section		
Geotechnical Condition Grades			
Slope Condition Grade:	1	Erosion Condition Grade:	5
Recommended Treatments:	Erosion Protection		
Comments:	Two pipe lengths undermined, separated, and sank in erosion gully.		

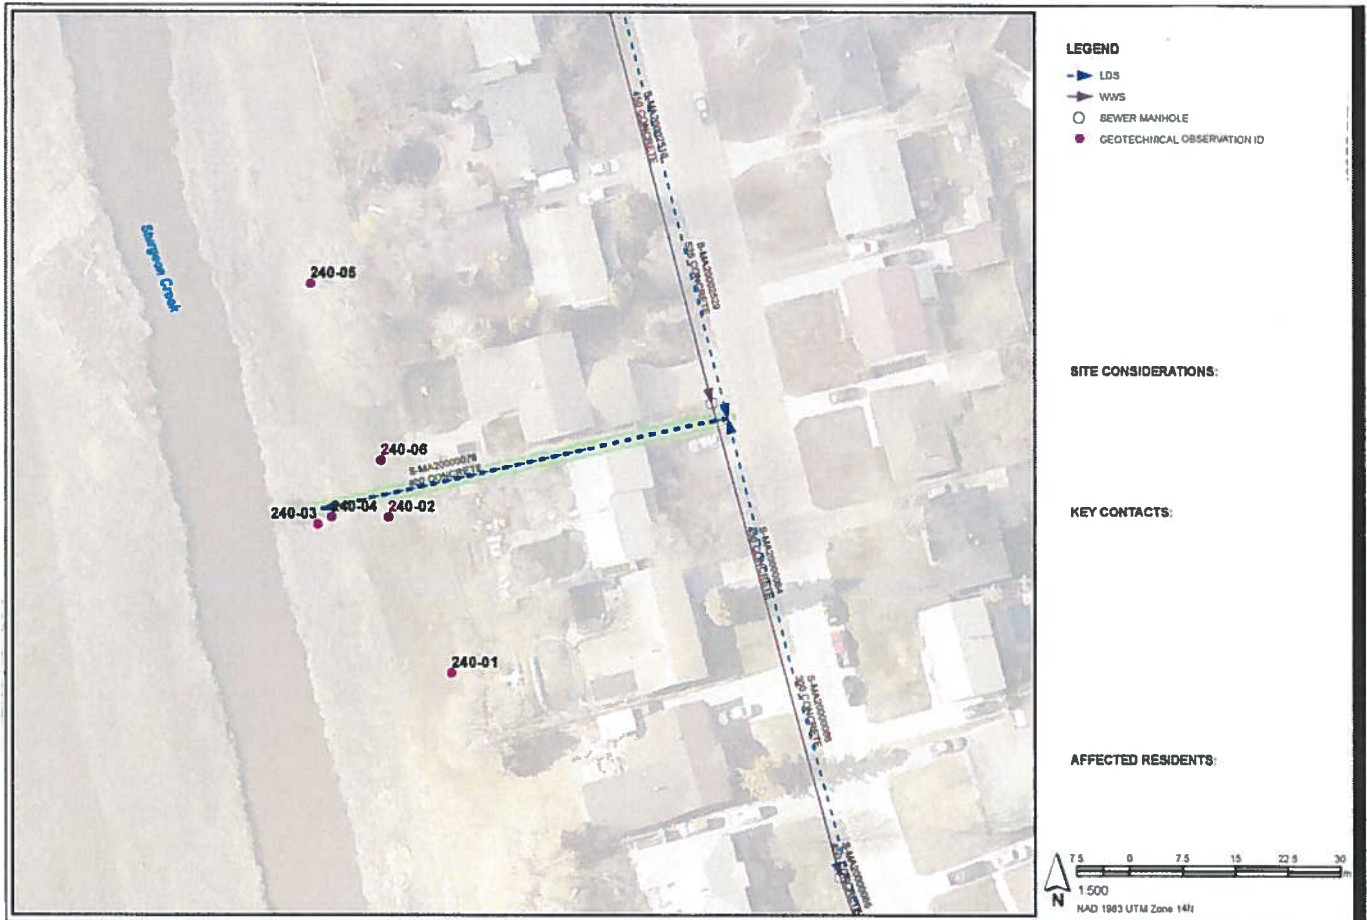

Slope Instability

Instability Type	ID	Location	Angle	Vegetation	Terrain
Slump	240-03	Toe	Small	Grass Natural	Graded

Existing Rip Rap

ID	Rip Rap Type	Geotextile	Rip Rap Location

Scarps

ID	Height	Location	Angle	Vegetation	Surface Soil
240-03	1300	Toe	Small	Grass Natural	Clay

Tension Cracking

ID	Width	Location	Angle	Vegetation	Surface Soil

Gully Erosion

ID	Depth	Width	Location	Angle	Vegetation	Surface Soil
240-03	700	2700	Toe	Small	Grass Natural	Clay

Other Structures Engaged

ID	Structure Type	Crack Width
240-01	Fence	

Miscellaneous

Roadway Location	Wildlife Signs
Bank Debris	

Site Condition Summary

ID	Terrain			Geotechnical									Structures	
	Leaning Trees	Bent Trees Creep	Leaning Infrastructure	Toe Bulge	Erosion	Surficial Erosion	Slump Block	Slickenside	Seepage	Softened	Settlement	Standing Water	Instability Coincides with Structure	Instability Coincides with Pipe
Site	Y	Y			Y		Y							Y
240-01														
240-02														
240-03					Y									Y
240-04														
240-05	Y	Y												
240-06							Y							

240-02



240-03



240-03



240-04



240-04



240-05

