

**Mr. Paul Houle
Wood
440 Dovercourt
Winnipeg, MB R3Y 1N4
Canada**

March 14, 2019

Account# 22469

Login# L473424

Dear Paul Houle:

Enclosed are the analytical results for the samples received by our laboratory on March 13, 2019. All samples on the chain of custody were received in good condition unless otherwise noted. When possible, non-IOM samples will be retained for 14 days following the date of this report (unless an extension is specifically requested). IOM samples are retained for 7 days.

Please contact client services at (888) 432-5227 if you would like any additional information regarding this report. Thank you for using SGS Galson.

Sincerely,

SGS Galson



**Lisa Swab
Laboratory Director**

Enclosure(s)

COMMENT ANNEX

Please note that this revision cancels and supersedes L473424 (report reference:1) dated March 14, 2019 issued by SGS Galson Laboratories. Per your request, the wipe areas were corrected for LW-25FB and LW-26.

Terms and Conditions & General Disclaimers

- This document is issued by the Company under its General Conditions of Service accessible at <http://www.sgs.com/en/Terms-and-Conditions.aspx>. Attention is drawn to the limitation of liability, indemnification and jurisdiction issues defined therein.
- Any holder of this document is advised that information contained herein reflects the Company’s findings at the time of its intervention only and within the limits of Client’s instructions, if any. The Company’s sole responsibility is to its Client and this document does not exonerate parties to a transaction from exercising all their rights and obligations under the transaction documents. Any unauthorized alteration, forgery or falsification of the content or appearance of this document is unlawful and offenders may be prosecuted to the fullest extent of the law.

Analytical Disclaimers

- Unless otherwise noted within the report, all quality control results associated with the samples were within established control limits or did not impact reported results.
- Note: The findings recorded within this report were drawn from analysis of the sample(s) provided to the laboratory by the Client (or a third party acting at the Client’s direction). The laboratory does not have control over the sampling process, including but not limited to the use of field equipment and collection media, as well as the sampling duration, collection volume or any other collection parameter used by the Client. The findings herein constitute no warranty of the sample’s representativeness of any sampled environment, and strictly relate to the samples as they were presented to the laboratory. For recommended sampling collection parameters, please refer to the Sampling and Analysis Guide at www.sgs.com.
- Unrounded results are carried through the calculations that yield the final result and the final result is rounded to the number of significant figures appropriate to the accuracy of the analytical method. Please note that results appearing in the columns preceding the final result column may have been rounded and therefore, if carried through the calculations, may not yield an identical final result to the one reported.
- The stated LOQs for each analyte represent the demonstrated LOQ concentrations prior to correction for desorption efficiency (if applicable).
- Unless otherwise noted within the report, results have not been blank corrected for any field blank or method blank data.

Accreditations SGS Galson holds a variety of accreditations and recognitions. Our quality management system conforms with the requirements of ISO/IEC 17025. Where applicable, samples may also be analyzed in accordance with the requirements of ELAP, NELAC, or LELAP under one of the state accrediting bodies listed below. Current Scopes of Accreditation can be viewed at <http://www.sgs.com> in the accreditations section of the "About" page. To determine if the analyte tested falls under our scope of accreditation, please visit our website or call Client Services at (888) 432-5227.

National/International	Accreditation/Recognition	Lab ID#	Program/Sector
AIHA-LAP, LLC - IHLAP, ELLAP, EMLAP	ISO/IEC 17025 and USEPA NLLAP	Lab ID 100324	Industrial Hygiene, Environmental Lead, Environmental Microbiology

State	Accreditation/Recognition	Lab ID#	Program/Sector
New York (NYSDOH)	ELAP and NELAC (TNI)	Lab ID: 11626	Air Analysis, Solid and Hazardous Waste
New Jersey (NJDEP)	NELAC (TNI)	Lab ID: NY024	Air Analysis
Louisiana (LDEQ)	LELAP	Lab ID: 04083	Air Analysis, Solid Chemical Materials
Texas	Texas Dept. of Licensing and Regulation	Lab ID: 1042	Mold Analysis Laboratory license

Legend

< - Less than	mg - Milligrams	MDL - Method Detection Limit	ppb - Parts per Billion
> - Greater than	ug - Micrograms	NA - Not Applicable	ppm - Parts per Million
l - Liters	m3 - Cubic Meters	NS - Not Specified	ppbv - ppb Volume
LOQ - Limit of Quantitation	kg - Kilograms	ND - Not Detected	ppmv - ppm Volume
ft2 - Square Feet	cm2 - Square Centimeters	in2 - Square Inches	ng - Nanograms



GALSON

LABORATORY ANALYSIS REPORT

6601 Kirkville Road
 East Syracuse, NY 13057
 (315) 432-5227
 FAX: (315) 437-0571
 www.sgsgalson.com

Client : AMEC Foster Wheeler
 Site : 151 Princess
 Project No. : PSB Range
 Date Sampled : 11-MAR-19
 Date Received : 13-MAR-19

Account No.: 22469
 Login No. : L473424
 Date Analyzed : 13-MAR-19
 Report ID : 1122610

Lead

<u>Sample ID</u>	<u>Lab ID</u>	<u>Area</u> ft2	<u>Total</u> ug	<u>Conc</u> ug/ft2
LW-1	L473424-1	0.107639	18	160
LW-2	L473424-2	0.107639	31	290
LW-3	L473424-3	0.107639	52	480
LW-4	L473424-4	0.107639	1300	12000
LW-5	L473424-5	0.107639	250	2300
LW-6	L473424-6	0.107639	1300	12000
LW-7	L473424-7	0.107639	5900	55000
LW-8	L473424-8	0.107639	1700	16000
LW-9	L473424-9	0.107639	2300	22000
LW-10	L473424-10	0.107639	310	2900
LW-11	L473424-11	0.107639	8200	76000
LW-12	L473424-12	0.107639	9100	84000
LW-13	L473424-13	0.107639	1800	17000
LW-14	L473424-14	0.107639	3500	33000
LW-15	L473424-15	0.107639	43000	400000
LW-16	L473424-16	0.107639	6400	59000

COMMENTS: Please see attached lab footnote report for any applicable footnotes.

Level of Quantitation: 1.3 ug

Analytical Method : mod SW846 3050B/6010C/NIOSH9102 ICP LD

Collection Media : Lead Wipe

Submitted by: JMR/KEG

Date : 14-MAR-19

Supervisor : KEG

Approved by: JJL

QC by : JJL



GALSON

LABORATORY ANALYSIS REPORT

6601 Kirkville Road
 East Syracuse, NY 13057
 (315) 432-5227
 FAX: (315) 437-0571
 www.sgsgalson.com

Client : AMEC Foster Wheeler
 Site : 151 Princess
 Project No. : PSB Range
 Date Sampled : 11-MAR-19
 Date Received : 13-MAR-19

Account No.: 22469
 Login No. : L473424
 Date Analyzed : 13-MAR-19
 Report ID : 1122610

Lead

Sample ID	Lab ID	Area ft2	Total ug	Conc ug/ft2
LW-17	L473424-17	0.107639	2900	27000
LW-18	L473424-18	0.107639	2200	21000
LW-19	L473424-19	0.107639	1300	12000
LW-20	L473424-20	0.107639	37000	350000
LW-22	L473424-21	0.107639	7.2	67
LW-23	L473424-22	0.107639	7500	69000
LW-24	L473424-23	0.107639	26000	250000
LW-25FB	L473424-24	NA	<1.3	NA
LW-26	L473424-25	0.107639	22000	200000

COMMENTS: Please see attached lab footnote report for any applicable footnotes.

Level of Quantitation: 1.3 ug	Submitted by: JMR/KEG	Approved by: JJL
Analytical Method : mod SW846 3050B/6010C/NIOSH9102 ICP LD	Date : 14-MAR-19	
Collection Media : Lead Wipe	Supervisor : KEG	QC by : JJL



GALSON

LABORATORY FOOTNOTE REPORT

6601 Kirkville Road
East Syracuse, NY 13057
(315) 432-5227
FAX: (315) 437-0571
www.sgsгалсон.com

Client Name : AMEC Foster Wheeler
Site : 151 Princess
Project No. : PSB Range

Date Sampled : 11-MAR-19
Date Received: 13-MAR-19
Date Analyzed: 13-MAR-19

Account No.: 22469
Login No. : L473424

L473424 (Report ID: 1122610):


Reported results reflect elemental analysis of the requested metals. Certain compounds may not be solubilized during digestion, resulting in data that is biased low.

SOPs: MT-SOP-27(4), im-mwvleadwp(24)

L473424 (Report ID: 1122610):

Accuracy and mean recovery data presented below is based on a 95% confidence interval (k=2). The estimated accuracy applies to the media, technology, and SOP referenced in this report and does not account for the uncertainty associated with the sampling process. The accuracy is based solely on spike recovery data from internal quality control samples. Where N/A appears below, insufficient data is available to provide statistical accuracy and mean recovery values for the associated analyte.

Parameter	Accuracy	Mean Recovery
Lead	+/-15.2%	97.4%

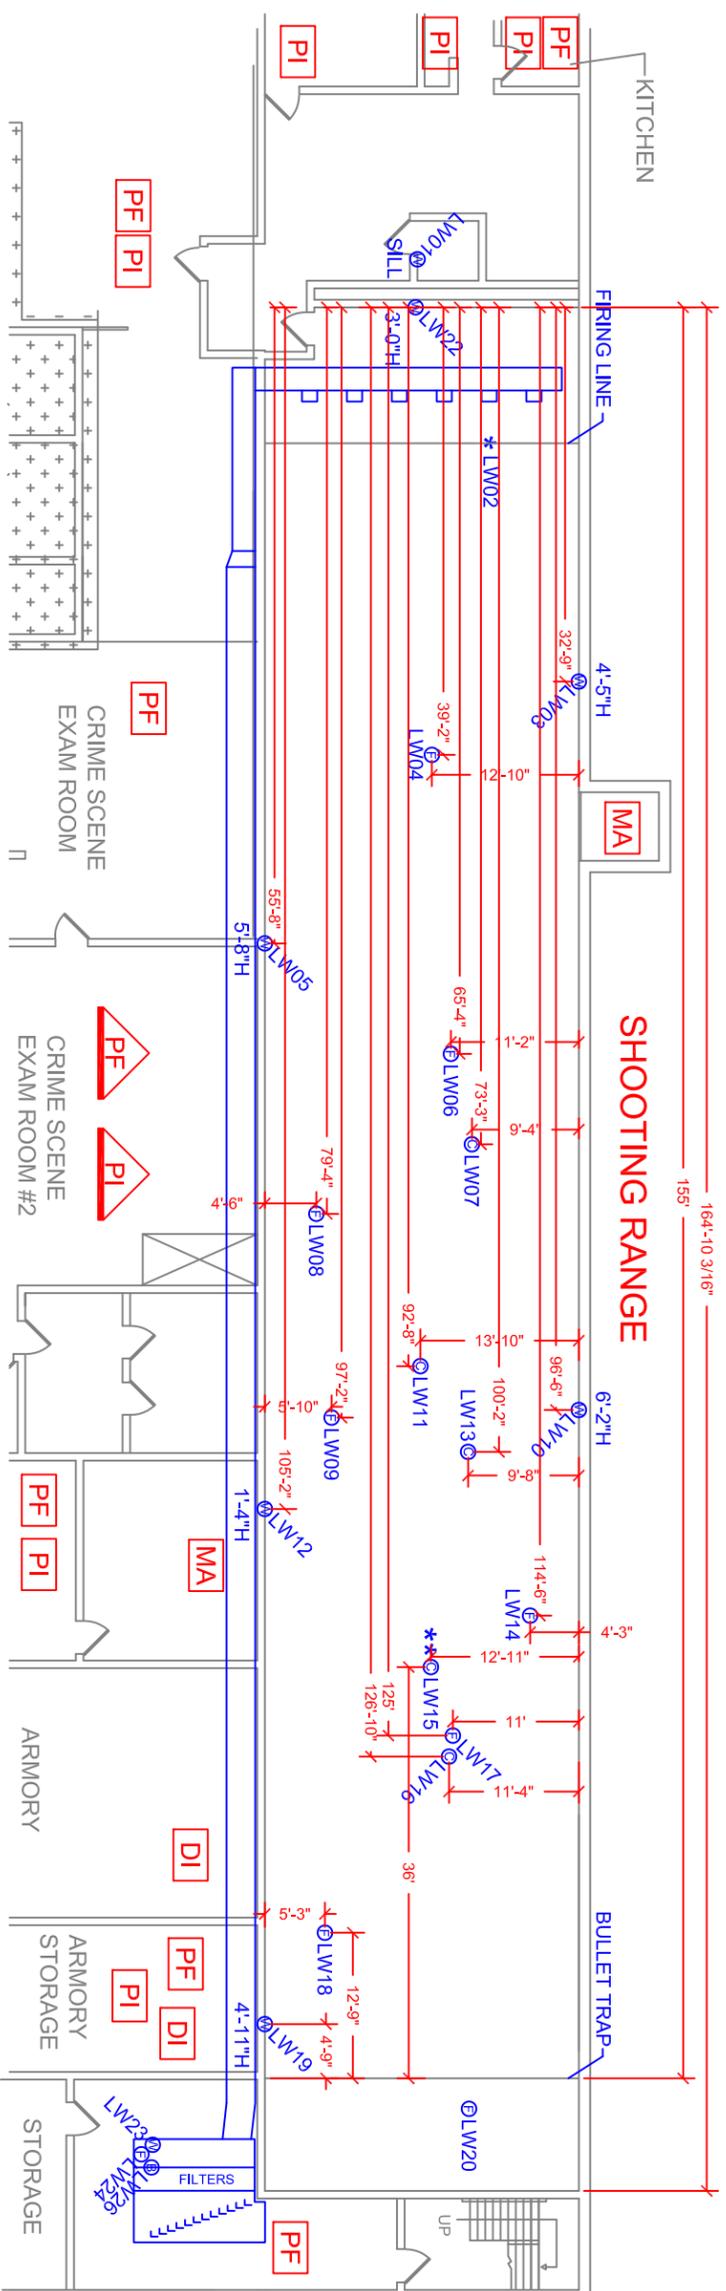


SHOOTING RANGE LEAD SAMPLING

NOTES

- * LW02 is from surface of controller in lane 2.
- ** LW15 is from top of cross bracing.
- LW21 does not exist.
- LW25 is Field Blank.
- LW26 is a bulk sample of HEPA filter.

- Ⓜ WALL
- ⓕ FLOOR
- Ⓢ CEILING
- Ⓟ BULK

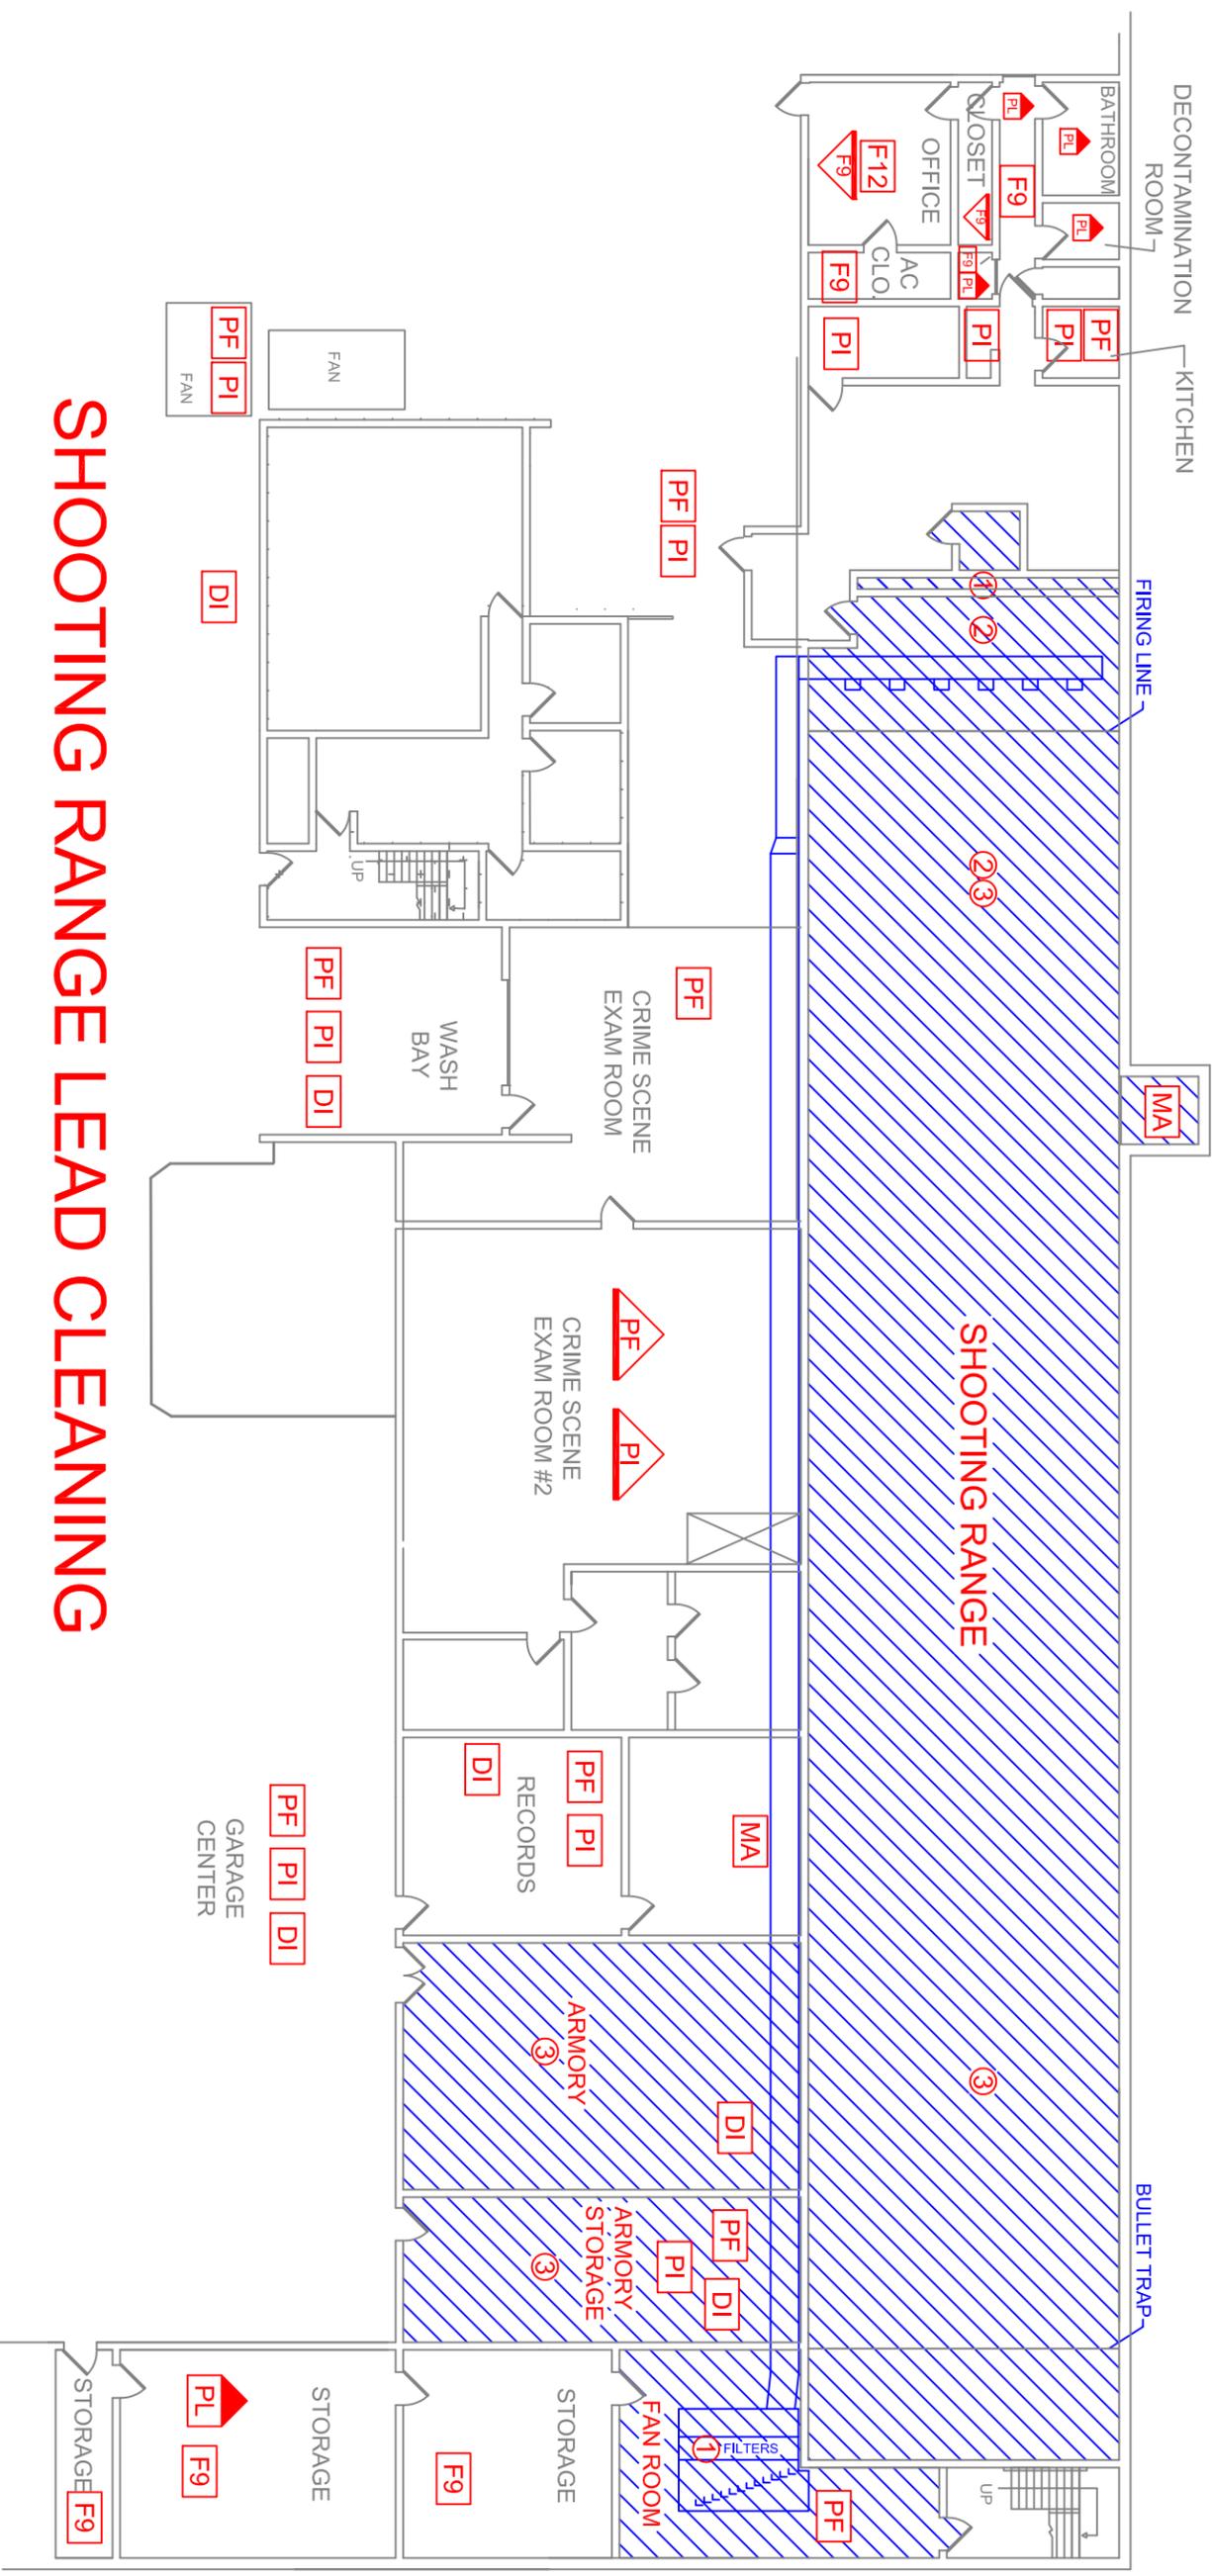

NOTES

- ①- AIR FILTERS TO BE REMOVED IN THIS AREA.
 - ②- ALL POROUS MATERIALS THAT CANNOT BE WET WIPED ARE TO BE REMOVED IN THIS AREA.
 - ③- ALL LOOSE MISCELLANEOUS MATERIALS IN THIS AREA TO BE DISPOSED OF AS CONTAMINATED.
-  HATCHING INDICATES AREAS TO BE CLEANED.

SHOOTING RANGE LEAD CLEANING