


APPENDIX A- SIDE B

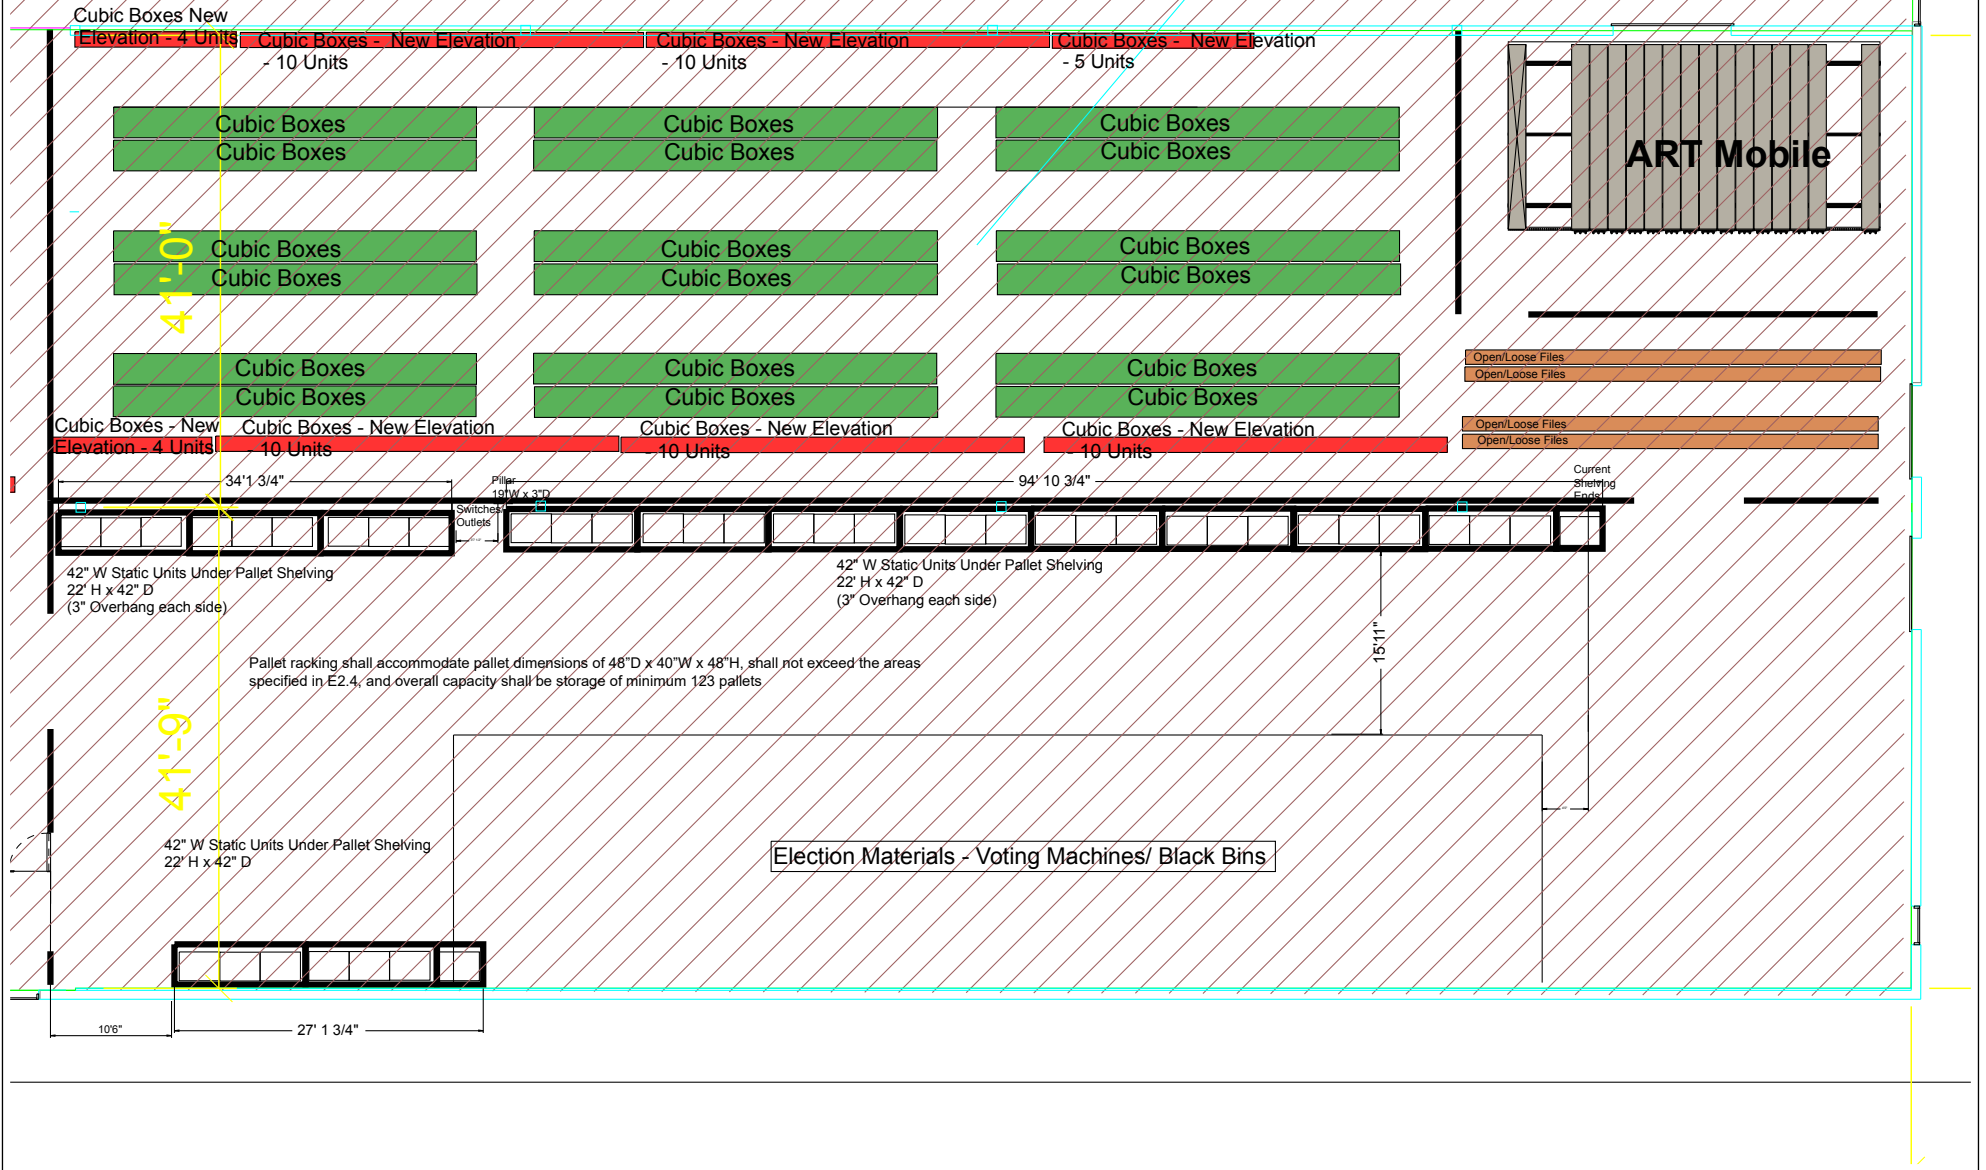

TITLE	Records and Election Shelving	DWG NO	
	City of Winnipeg Elections - 1450 Mountain	SCALE	1:200
OFFICE	TAB Winnipeg	DATE	June 17, 2019
REP	Tanis Sinclair	REVISED	July 18, 2019

ALL DESIGNS REPRESENTED BY DRAWING ARE CONFIDENTIAL AND SHOULD NOT BE DISCLOSED WITHOUT WRITTEN PERMISSION FROM TAB.