

MOTOR SCHEDULE

MOTOR/EQUIP ID	NAME	LOCATION	H.P. (kW)	VOLTS	STARTER & ACC.			SOURCE	STARTER LOCATION	FEEDER	REMARKS
					MAN	MAG	PL / HDA				
HRU-9	Heat Recovery Unit	Roof	58.8 FLA	600V/3ø				CDP-RS	PACKAGED UNIT	3#1	PACKAGED UNIT
HRU-10	Heat Recovery Unit	Roof	11 FLA	600V/3ø				CDP-RS	PACKAGED UNIT	3#10	PACKAGED UNIT
HRU-11	Heat Recovery Unit	Roof	58.8 FLA	600V/3ø				CDP-RS	PACKAGED UNIT	3#1	PACKAGED UNIT



GENERAL NOTES

- A. ALL WIRING INDOORS TO BE RW90 COPPER IN EMT CONDUIT UNLESS OTHERWISE NOTED.
- B. PROVIDE BOND CONDUCTOR IN ALL CONDUIT RUNS.
- C. REMOVE ALL ABANDONED EQUIPMENT AND SERVICES WITHIN AREA OF WORK.
- D. THIS BUILDING MAY CONTAIN ASBESTOS, REFER TO FRONT END SPECIFICATIONS FOR FURTHER INFORMATION.

KEY NOTES


- 1. EXISTING EQUIPMENT TO BE REMOVED, REMOVE WIRING, CONDUIT, ETC. BACK TO SOURCE, TURN OVER EQUIPMENT TO CITY.
- 2. EXISTING MCC TO BE REMOVED UPON DEMOLITION OF CONNECTED LOADS, REMOVE WIRING, CONDUIT, ETC. BACK TO SOURCE, TURN OVER, EXISTING MCC TO CITY. LABEL EXISTING 125-3P BREAKER IN MAIN DISTRIBUTION AS SPARE (LAMACOD MATCH EXISTING).

1	ISSUED FOR ADDENDUM 1	VEK	03/02/20
0	ISSUED FOR CONSTRUCTION	VEK	16/01/20
NO.	Description	BY	DDMMYY

**ENGINEERS
GEO-SCIENTISTS
MANITOBA**
Certificate of Authorization
SMS Engineering Ltd.
No. 166

ORIGINAL
CONTRACT DRAWING
SIGNED AND SEALED BY
V.E. KANE, P. ENG
JANUARY 16, 2020

770 Bradford Street
Winnipeg, Canada
T 204 775 0291
SMSeng.com

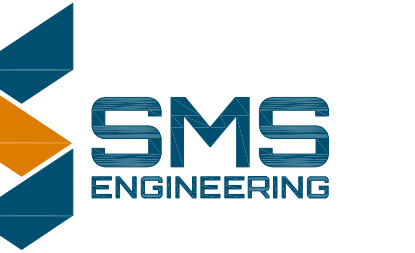

Project Title
**CITY OF WINNIPEG FORT ROUGE
TRANSIT BASE - STORAGE
TRACK 25-36 - MECHANICAL
UPGRADE**
WINNIPEG MANITOBA

Drawing Title
**PARTIAL SINGLE LINE DIAGRAM
AND MOTOR SCHEDULE**

Drawn By WPD	Checked By RD	Approved By VEK
Scale AS NOTED	Date JANUARY, 2020	Project No. 19-332-02
Revision Number 1	Drawing Number E3.1R1	Sheet Order 6 OF 6

FILE NAME AND PATH: G:\PROJECTS\2019\19-332 Transit Track 25-36 Mechanical Upgrade\3-D\Coord_Rev\2_4_Electrical\CDR_E3-1R1_02.dwg
LAYOUT: E3-1R1 DATE PLOTTED: Monday, October 7, 2019 12:22:57 PM