



1 KITCHEN CABINETS - TYP. SECTION DETAIL
A1.2R1 SCALE: 3/4" = 1'-0"

2 KITCHEN CABINETS - SECTION DETAIL
A1.2R1 SCALE: 3/4" = 1'-0"

3 KITCHEN CABINETS - SECTION DETAIL
A1.2R1 SCALE: 3/4" = 1'-0"

4 STORAGE CABINETS - SECTION DETAIL
A1.2R1 SCALE: 3/4" = 1'-0"


5 INTERIOR ELEVATION - STORAGE CABINETS
A1.2R1 SCALE: 1/2" = 1'-0"

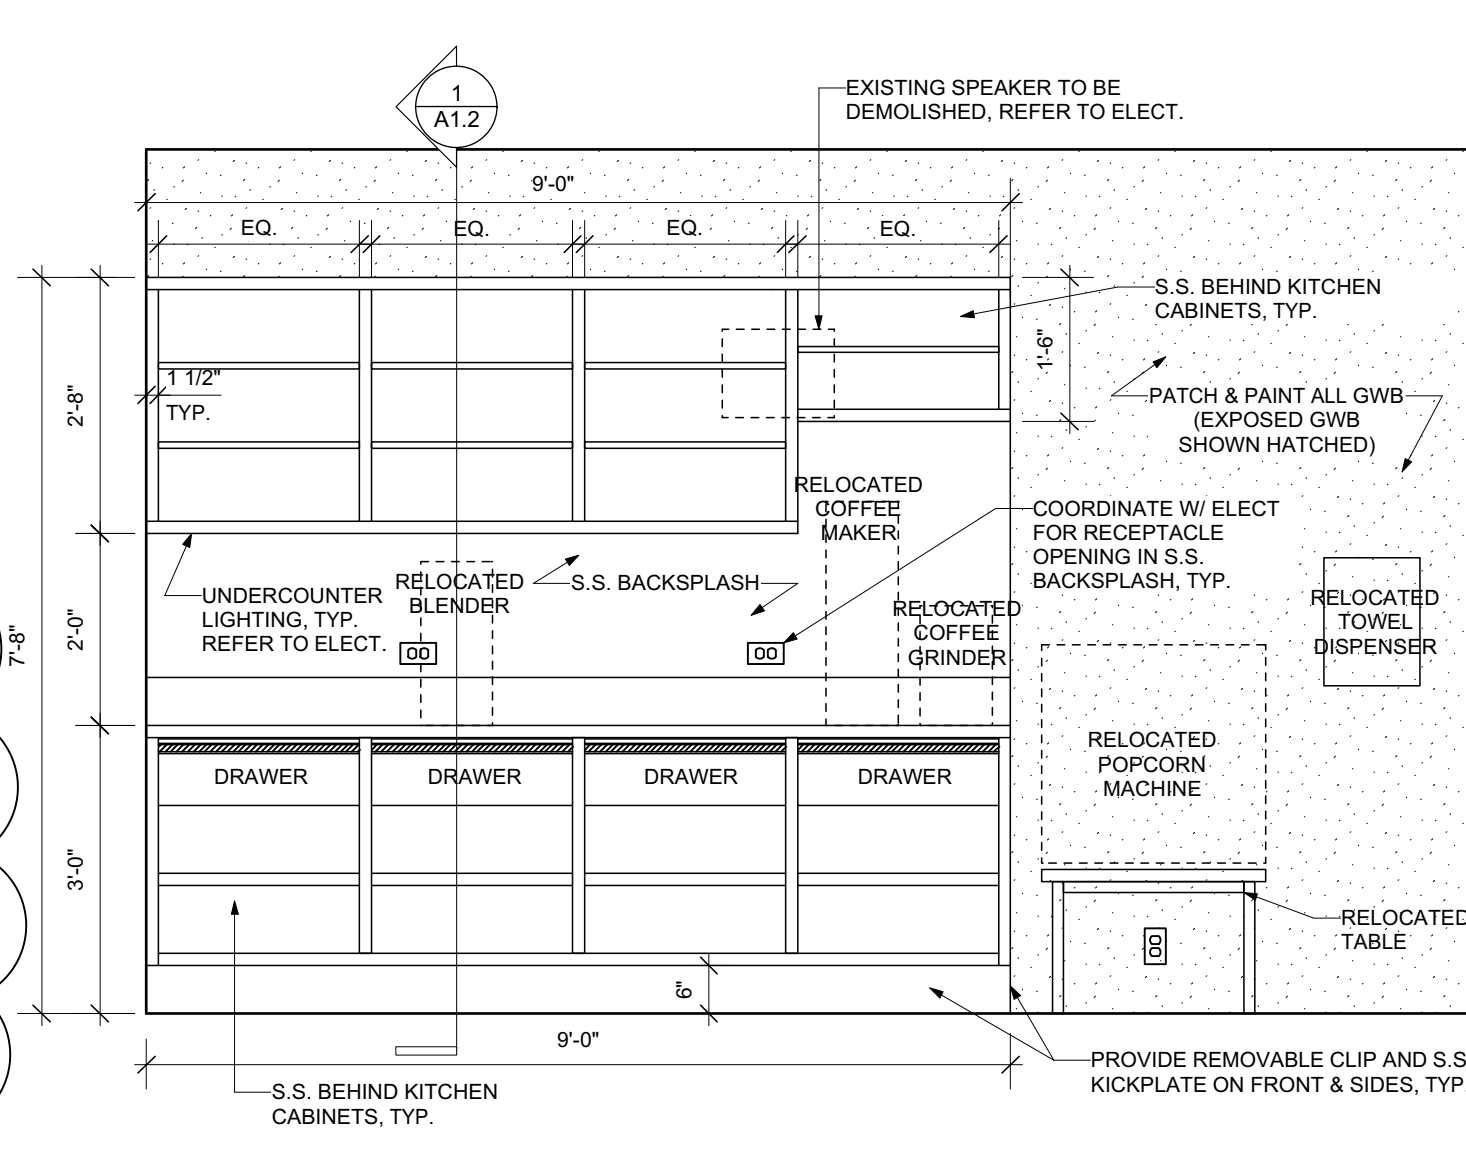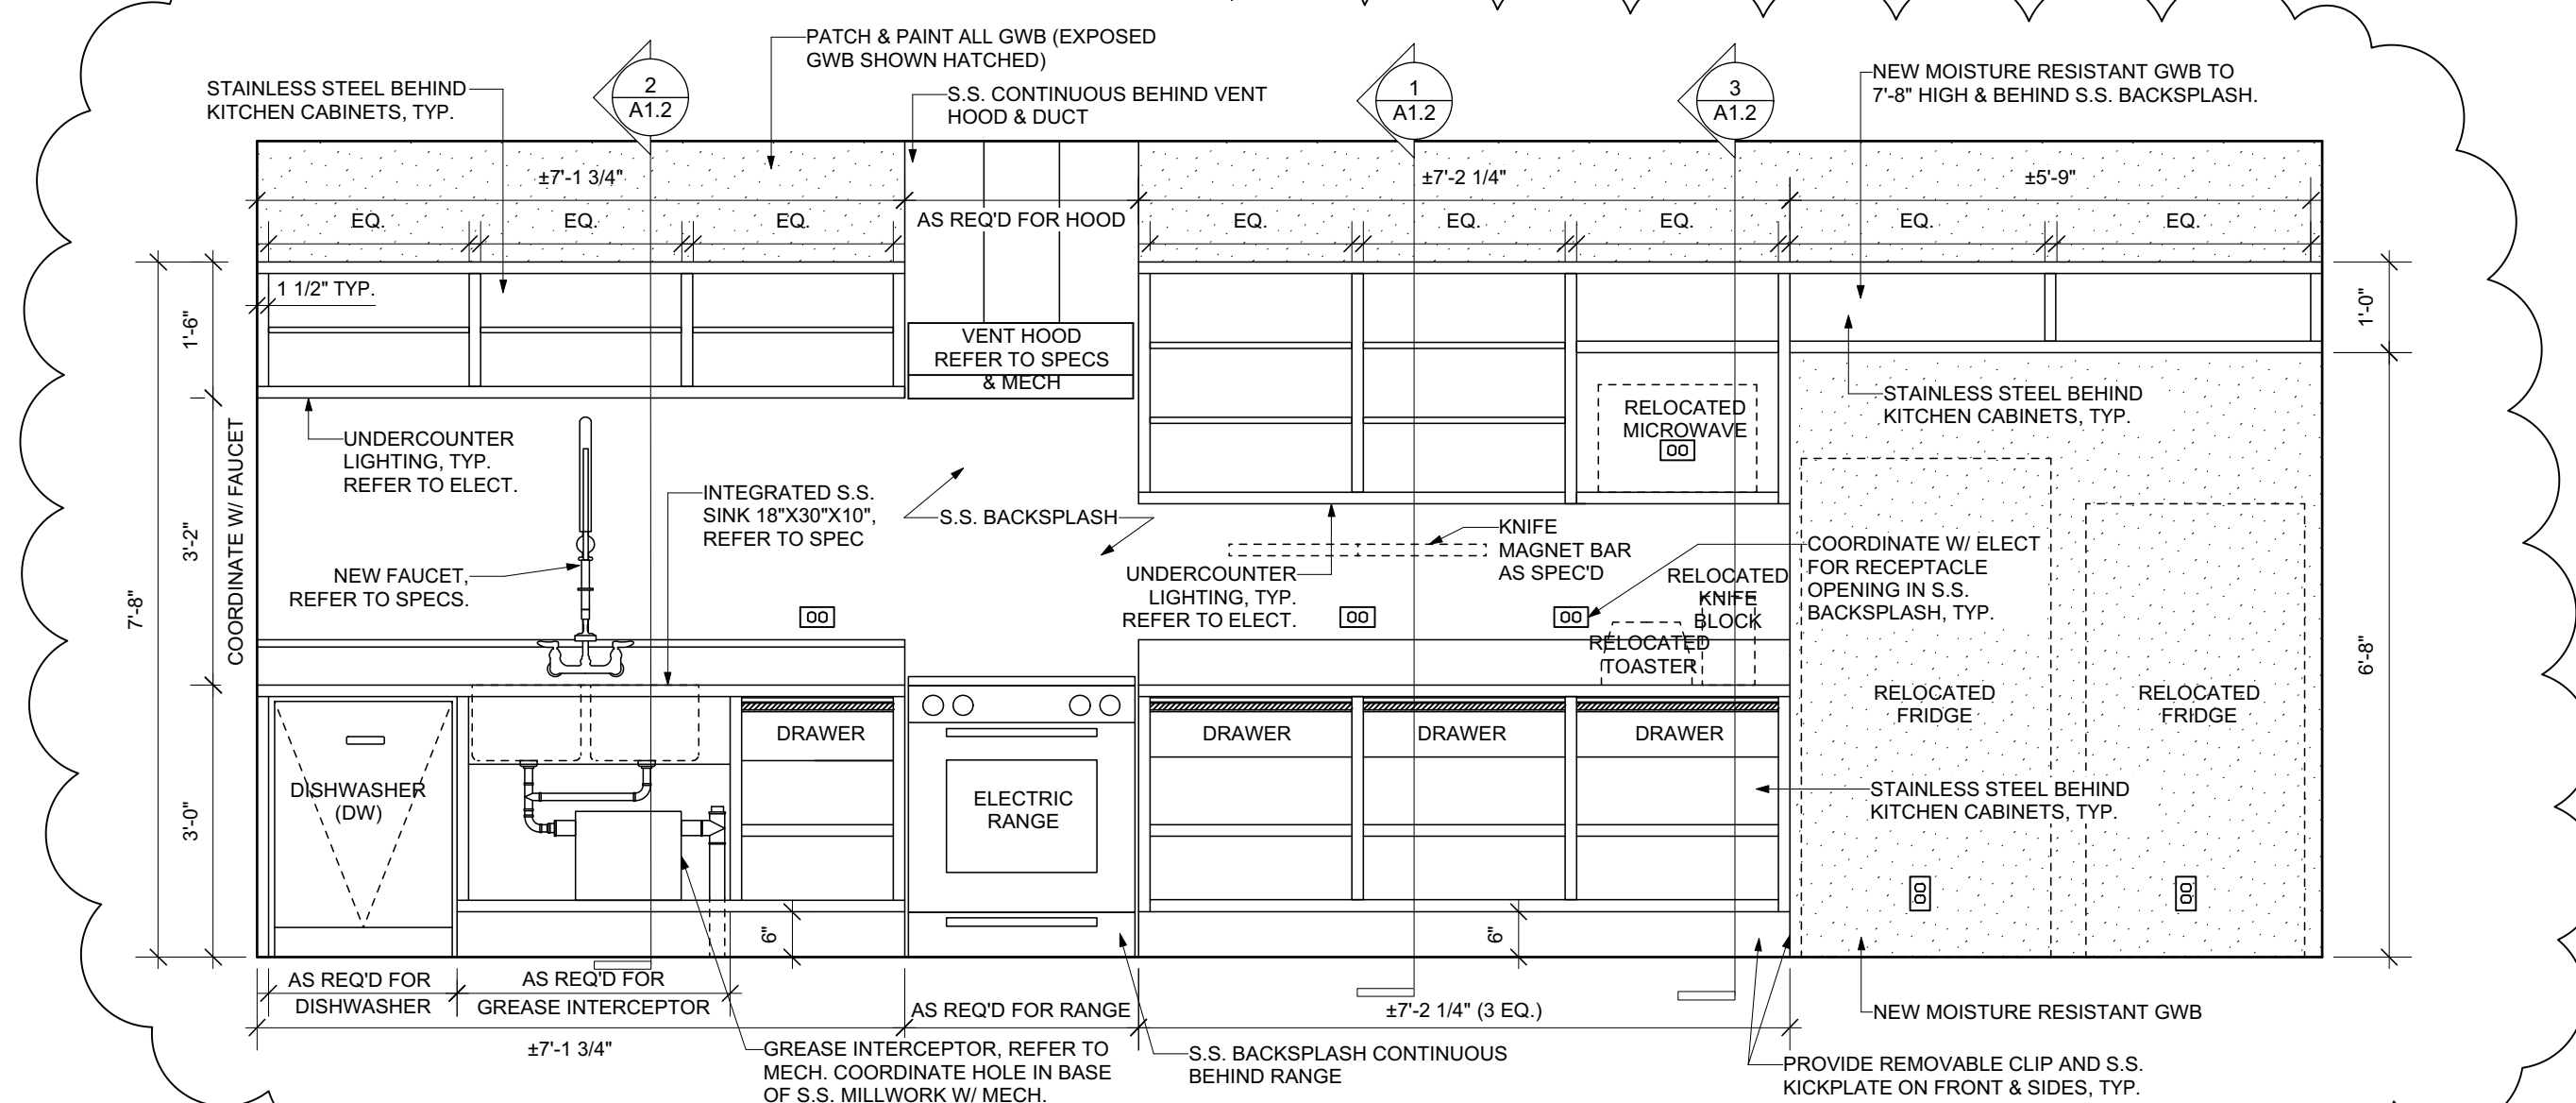


6 INTERIOR ELEVATION - G-08 KITCHEN
A1.2R1 SCALE: 1/2" = 1'-0"

7 INTERIOR ELEVATION - G-08 COFFEE STATION
A1.2R1 SCALE: 1/2" = 1'-0"

ADDENDUM NO. 1

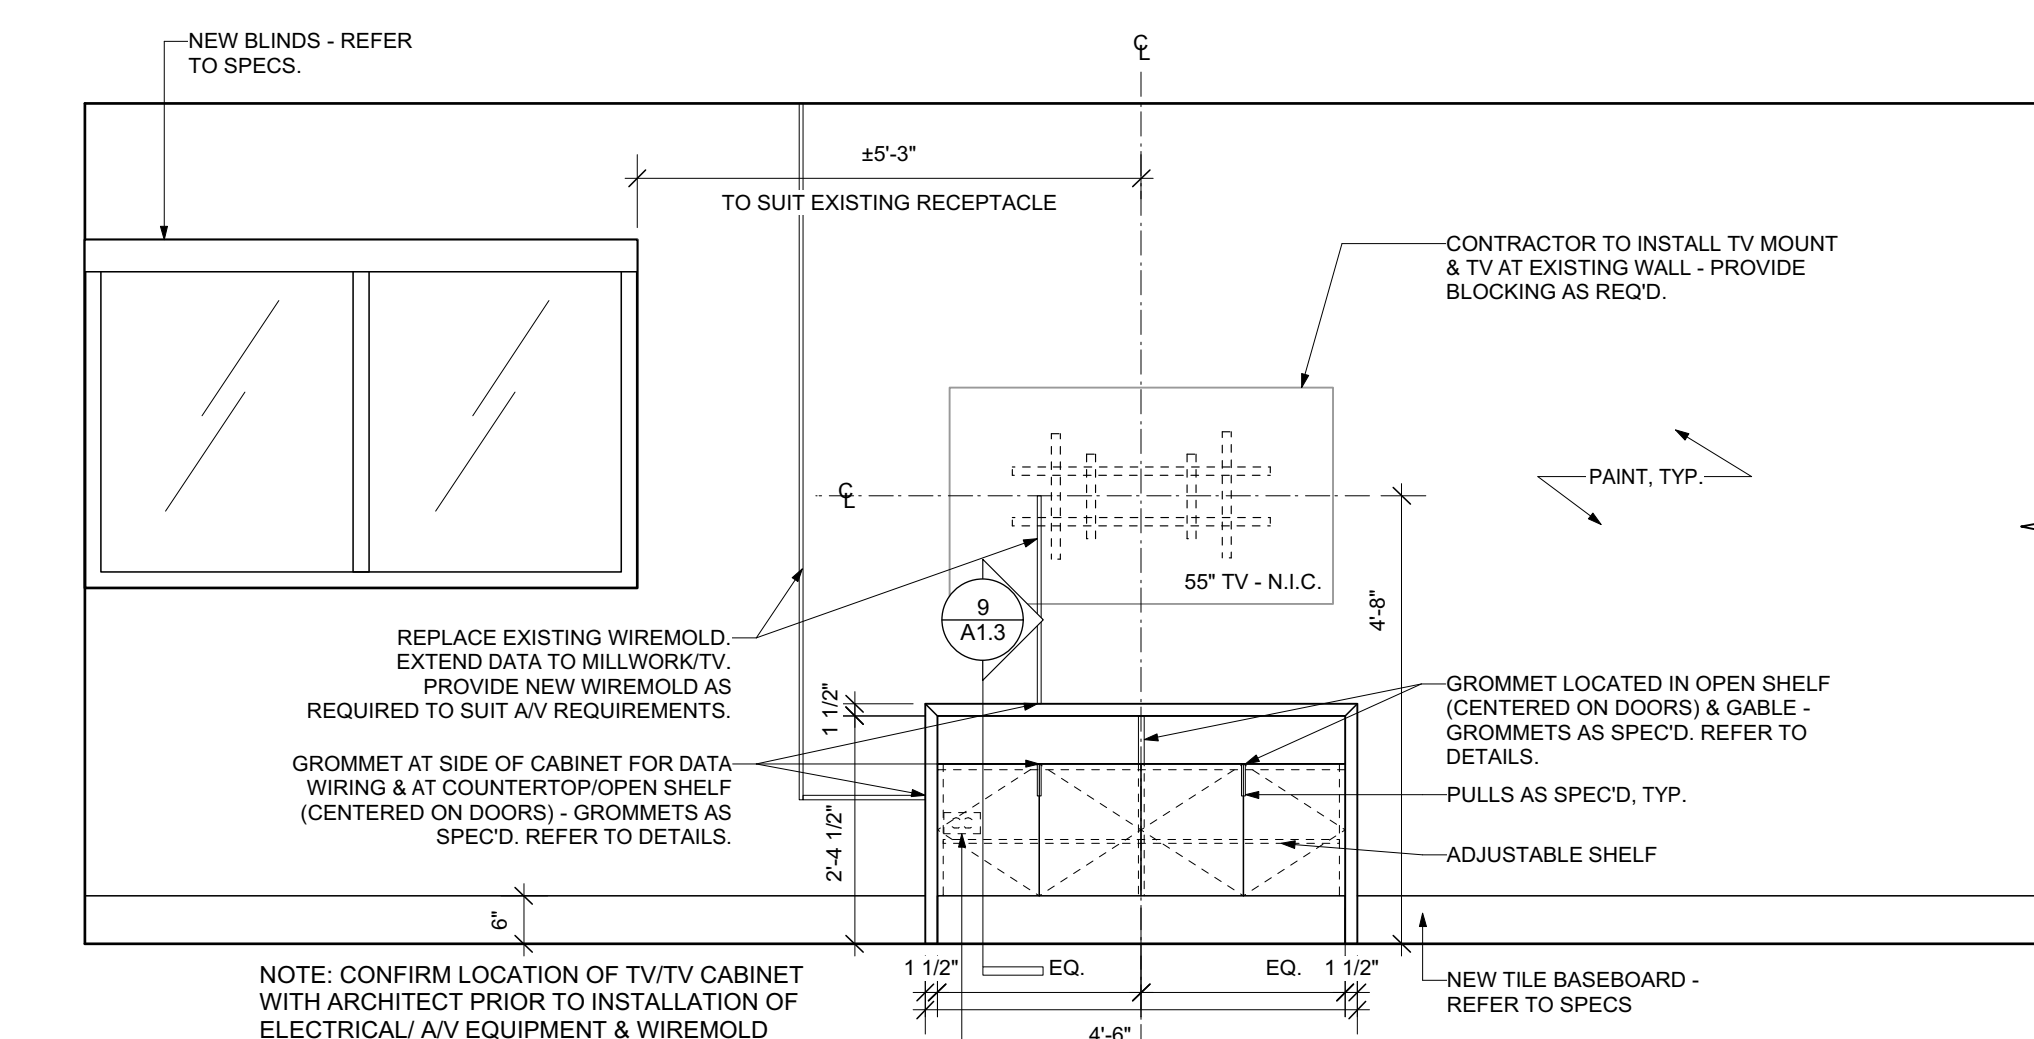

8 INTERIOR ELEVATION - G-08 LIVING AREA
A1.2R1 SCALE: 1/2" = 1'-0"

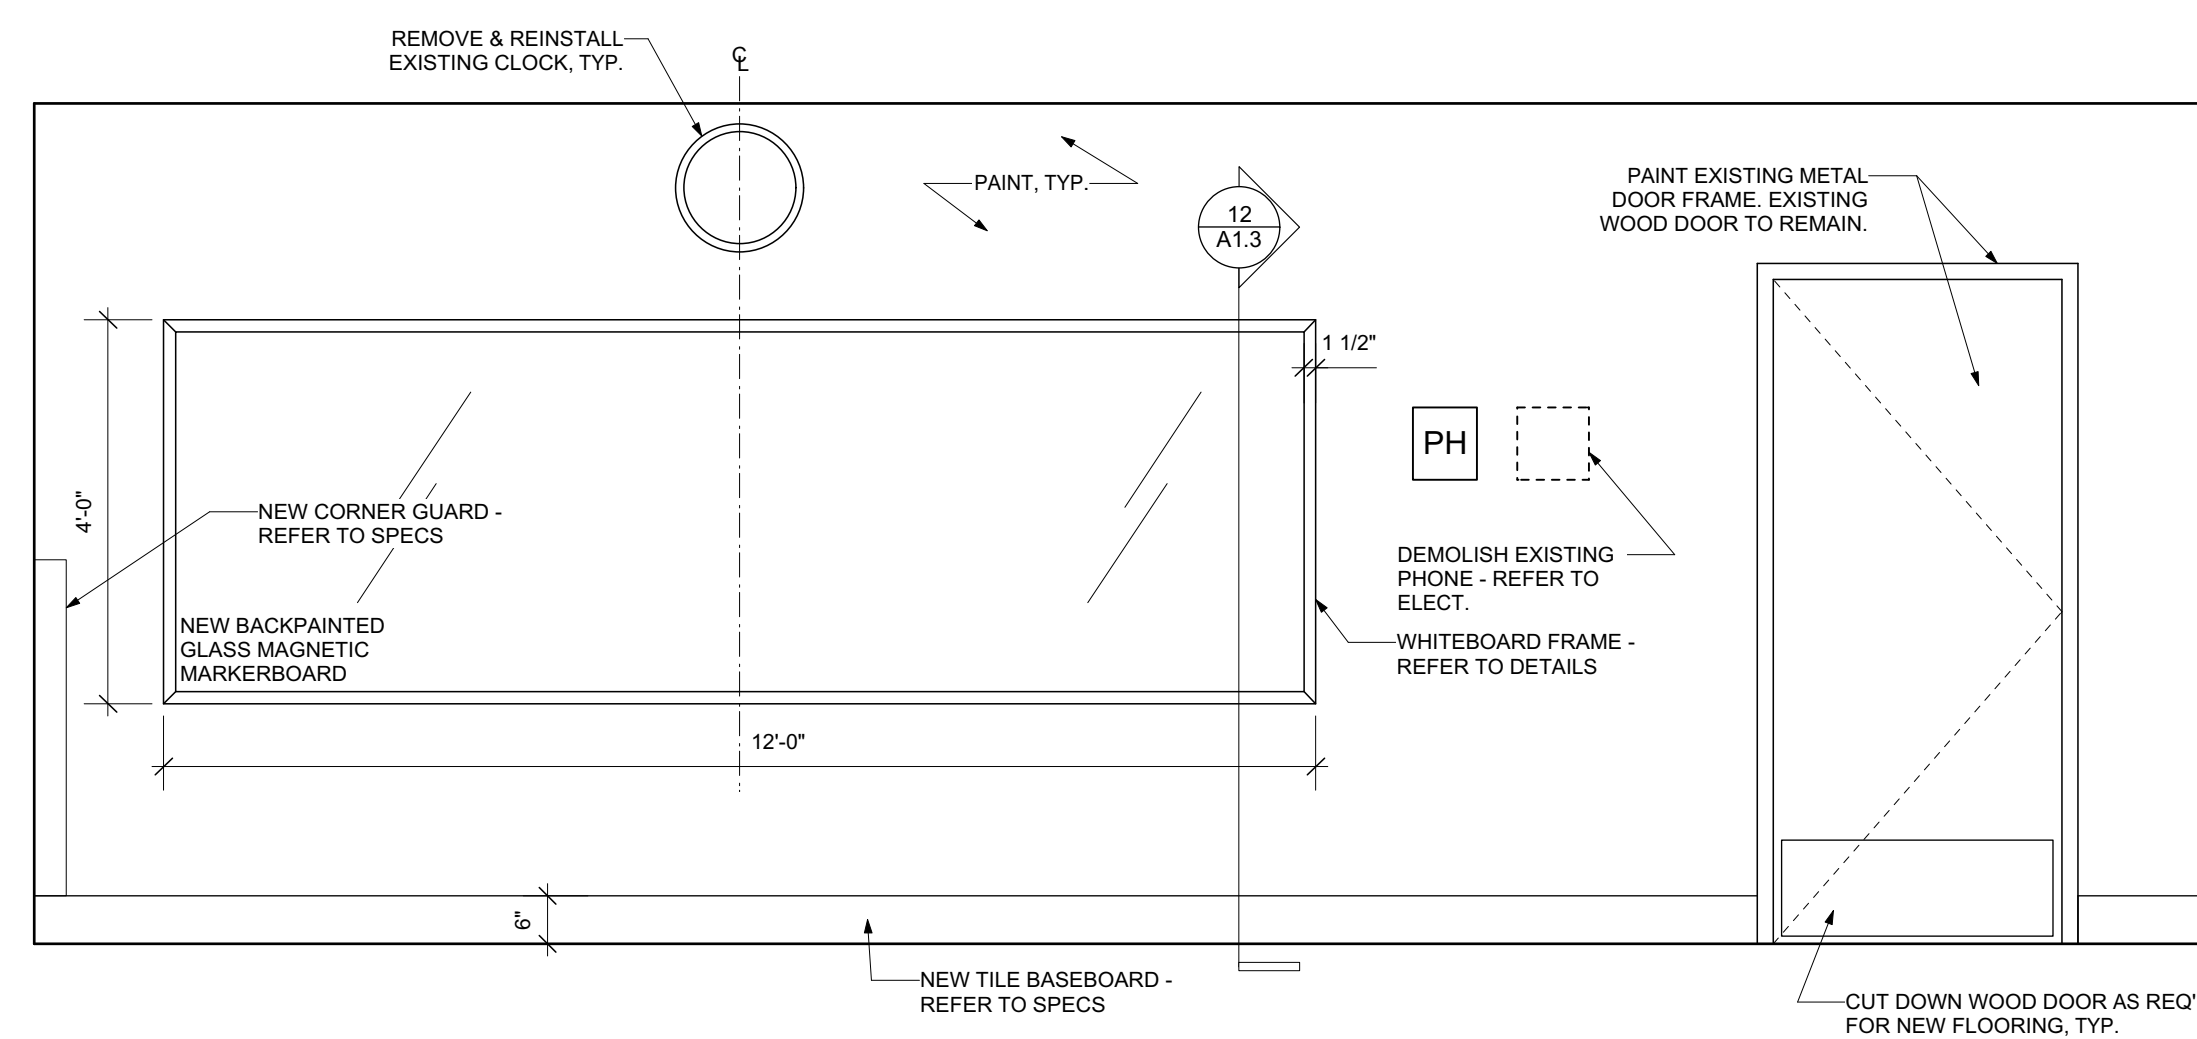

9 INTERIOR ELEVATION - G-08 NEW MARKERBOARD
A1.2R1 SCALE: 1/2" = 1'-0"

GENERAL NOTES:
THESE DRAWINGS SHALL NOT BE SCALED.
THE CONTRACTOR SHALL VISIT THE SITE AND SATISFY ONESELF ALL DIMENSIONS, DATUM, AND DETAILED INFORMATION SHOWN ARE CORRECT.
THE CONTRACTOR IS TO REVIEW AND COORDINATE ALL ARCHITECTURAL, MECHANICAL, AND ELECTRICAL DRAWINGS FOR ADDITIONAL OPENINGS THROUGH FLOORS, WALLS, AND CEILINGS FOR DUCT, PIPE & ELECTRICAL RISERS AND ALL OPENINGS NOT SHOWN ON DRAWINGS.
ALL OPENINGS THROUGH FIRE ASSEMBLIES ARE TO BE FIRE STOPPED AND SEALED WITH ULC APPROVED FIRE STOPPING TO MAINTAIN THE INTEGRITY OF THE FIRE SEPARATION, AND PROVIDE A SMOKE TIGHT BARRIER.
ALL PRODUCTS AND MATERIALS TO BE USED AND INSTALLED SHALL CONFORM WITH MANUFACTURER'S SPECIFICATIONS & APPLICABLE CODES.
THE CONTRACTOR SHALL BE RESPONSIBLE TO PATCH AND MAKE GOOD ALL EXISTING CONSTRUCTION AFFECTED BY DEMOLITION AND THE REMOVAL OF ALL ITEMS FORMING PART OF THE RENOVATION WORK.
WHERE NEW FLOORING AND BASE IS TO BE INSTALLED IN EXISTING AREAS (REFER TO FLOOR PLAN AND ROOM SCHEDULE) THE EXISTING FLOORING SURFACE AND BASE MUST BE REMOVED, UNLESS OTHERWISE NOTED. ALL FLOOR SURFACES SHALL BE PREPARED IN ACCORDANCE TO MANUFACTURER'S RECOMMENDATIONS FOR INSTALLATION OF NEW FLOOR.
WHERE PAINTING OF EXISTING WALLS & CEILING IS INDICATED ON THE ROOM SCHEDULE, THESE WALLS MUST BE CLEANED OF ANY EXISTING WALL COVERING, PATCHED & PREPARED TO ACCEPT NEW PAINT, UNLESS OTHERWISE NOTED.
ALL EXISTING FURNITURE, EQUIPMENT (INCLUDING GYM EQUIPMENT), AND WALL MOUNTED ITEMS (ARTWORK, MAPS/EXIT PLANS) ARE TO BE REMOVED AND REINSTALLED BY THE CITY OF WINNIPEG'S MOVERS (TO BE STORED IN THE APPARATUS ROOM OR A STORAGE CONTAINER AS REQ'D).
EMERGENCY LIGHTING TO BE REPLACED, REFER TO ELECTRICAL FOR SCOPE OF WORK.
ALL MISCELLANEOUS FLOOR MOUNTED ELECTRICAL TO BE REMOVED & REINSTALLED FOR FLOORING INSTALLATION.
ALL MECHANICAL WALL VENTS/GRILLES TO BE REMOVED & REINSTALLED FOR PAINTING.
ALL EXISTING DOORS ARE TO BE CUT DOWN OR ADJUSTED AS REQUIRED TO ACCOMMODATE NEW FLOORING THICKNESS, PATCH & MAKE GOOD ALL DOORS.
ALL FIRE EXTINGUISHERS TO BE REMOVED AND REINSTALLED FOR PAINTING.
WARNING:
ASBESTOS MAY BE PRESENT BEHIND WALLS CEILING SPACE & FLOORS. IF ASBESTOS OR ANY HAZARDOUS MATERIAL IS FOUND STOP WORK IMMEDIATELY & CONTACT CITY OF WINNIPEG, CENTRAL CONTROLS PH: 204-986-2351.

NO.	DATE	REVISION / ISSUANCE
4	DD.MM.YYYY	-
3	DD.MM.YYYY	-
2	DD.MM.YYYY	-
1	29.07.2020	- ISSUED FOR ADDENDUM NO. 1
0	25.06.2020	- ISSUED FOR CONSTRUCTION

architecture inc.
130 Fort Street, Suite 103 Winnipeg, Manitoba R3C 1C7 204 318 2010

Project: BID OPPORTUNITY 280-2020
WINNIPEG FPS FIRE STATION #13
INTERIOR RENOVATIONS
799 LILAC STREET

Interior Elevations & Millwork Details

Project No: 19089A
Date: 25.06.2020
Sheet: A1.2R1