




1 MAIN FLOOR PLAN - POWER DEMOLITION
EP2.1-R1 SCALE: 1/8" = 1'-0"

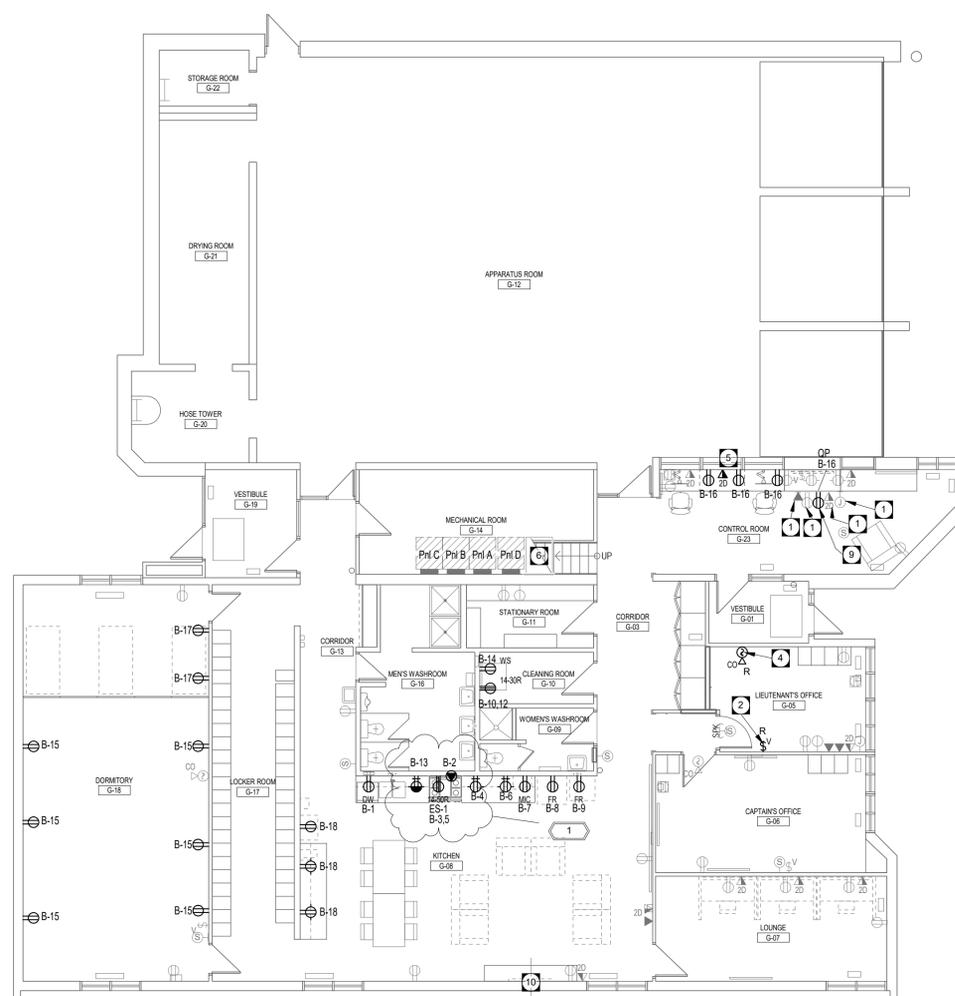

2 MAIN FLOOR PLAN - POWER & SYSTEMS
EP2.1-R1 SCALE: 1/8" = 1'-0"

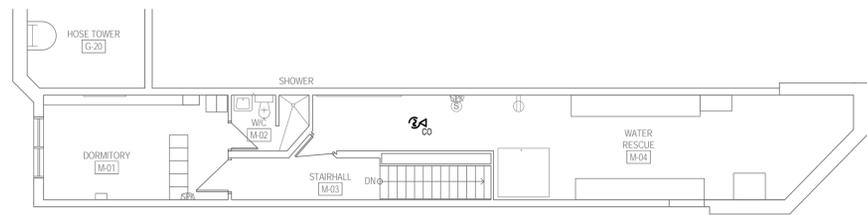

3 MEZZANINE FLOOR PLAN - POWER DEMOLITION
EP2.1-R1 SCALE: 1/8" = 1'-0"

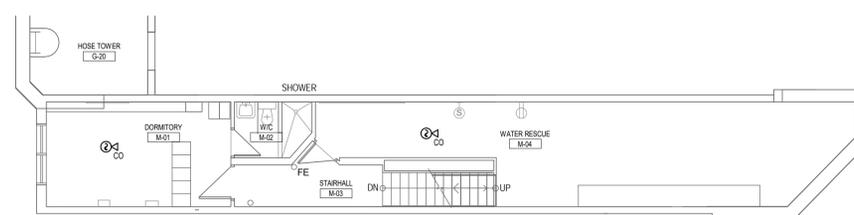


4 MEZZANINE FLOOR PLAN - POWER & SYSTEMS
EP2.1-R1 SCALE: 1/8" = 1'-0"

GENERAL NOTES

- A. PROVIDE NEW TYPEWRITTEN PANEL DIRECTORIES TO ACCOMMODATE UPDATED CIRCUITING. NEW BREAKERS IN DISTRIBUTION PANELS SHALL BE LABELLED USING LAMACODS.
- B. WHERE BRANCH CIRCUIT BREAKERS ARE REMOVED, PROVIDE FILLER PLATES FOR BREAKER SPACES.
- C. CIRCUIT BREAKERS SHALL MATCH EXISTING. CONFIRM SHORT CIRCUIT RATING AND TYPE ON SITE, PRIOR TO FINALIZING PRICING.
- D. UTILIZE SPARE/FREED UP CIRCUITS FROM DEMOLITION AS REQUIRED TO ACCOMMODATE THE ADDITIONAL CIRCUITING REQUIREMENTS IN THE RENOVATION.
- E. FOR ALL STRUCTURED WIRING OUTLETS, PROVIDE NUMBER OF JACKS AS INDICATED AND THE CORRESPONDING NUMBER OF CABLES IN CONDUIT STUB INTO CEILING SPACE. THEN HOME RUN TO THE DATA RACK. TERMINATE CABLES IN PATCH PANELS AND IN JACKS AT OUTLET LOCATIONS.

KEY NOTES

1. EXISTING DEVICE LOCATED BELOW DESK.
2. RELOCATE EXISTING VOLUME CONTROL FROM DEMOLISHED WALL TO THIS POSITION.
3. EXISTING RECEPTACLES AND JUNCTION BOXES AT 16" AFFL IN THIS SPACE TO BE DEMOLISHED. NEW RECEPTACLES TO BE PROVIDED AT 18" AFFL.
4. RELOCATE EXISTING CO ALARM FROM DEMOLISHED WALL TO THIS POSITION.
5. HOME RUN DATA CABLES TO EXISTING DATA RACK LOCATED IN MECHANICAL ROOM G-14.
6. EXISTING DATA CABINET.
7. EXISTING WALL TELEPHONE TO BE DEMOLISHED.
8. REMOVE AND REINSTALL FLOOR OUTLETS AS REQUIRED TO ACCOMMODATE RENOVATION WORKS.
9. PROVIDE NEW QUAD RECEPTACLE LOCATED BELOW DESK.
10. PROVIDE WIREMOLD FOR HDMI CABLES FROM TV CABLE BOX TO WALL MOUNTED TV. COORDINATE LENGTH WITH ARCHITECTURAL ELEVATIONS.

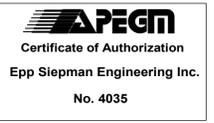

NO.	DATE	REVISION / ISSUANCE
1	20-07-28	Issued for Addendum 1
0	20-06-25	Issued for Construction

Architect



Project: BID OPPORTUNITY 240-2020
WINNIPEG FPS FIRE STATION #13
INTERIOR RENOVATIONS
799 LILAC STREET

Sheet Title
MAIN FLOOR - POWER PLAN

Project No. 19089A
Date 20-06-09
Sheet
EP2.1-R1