



1 Galvanized Steel Railing
Scale: 1:40


*NOTE: Railings to be Constructed and Installed as per Manufacturer's Stamped Engineering Drawings

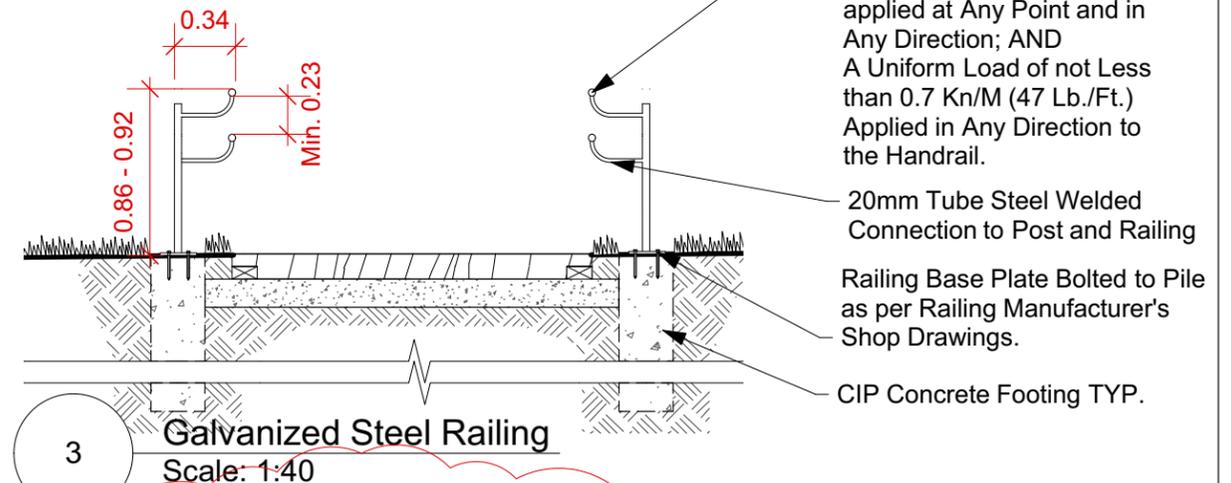

3 Galvanized Steel Railing
Scale: 1:40

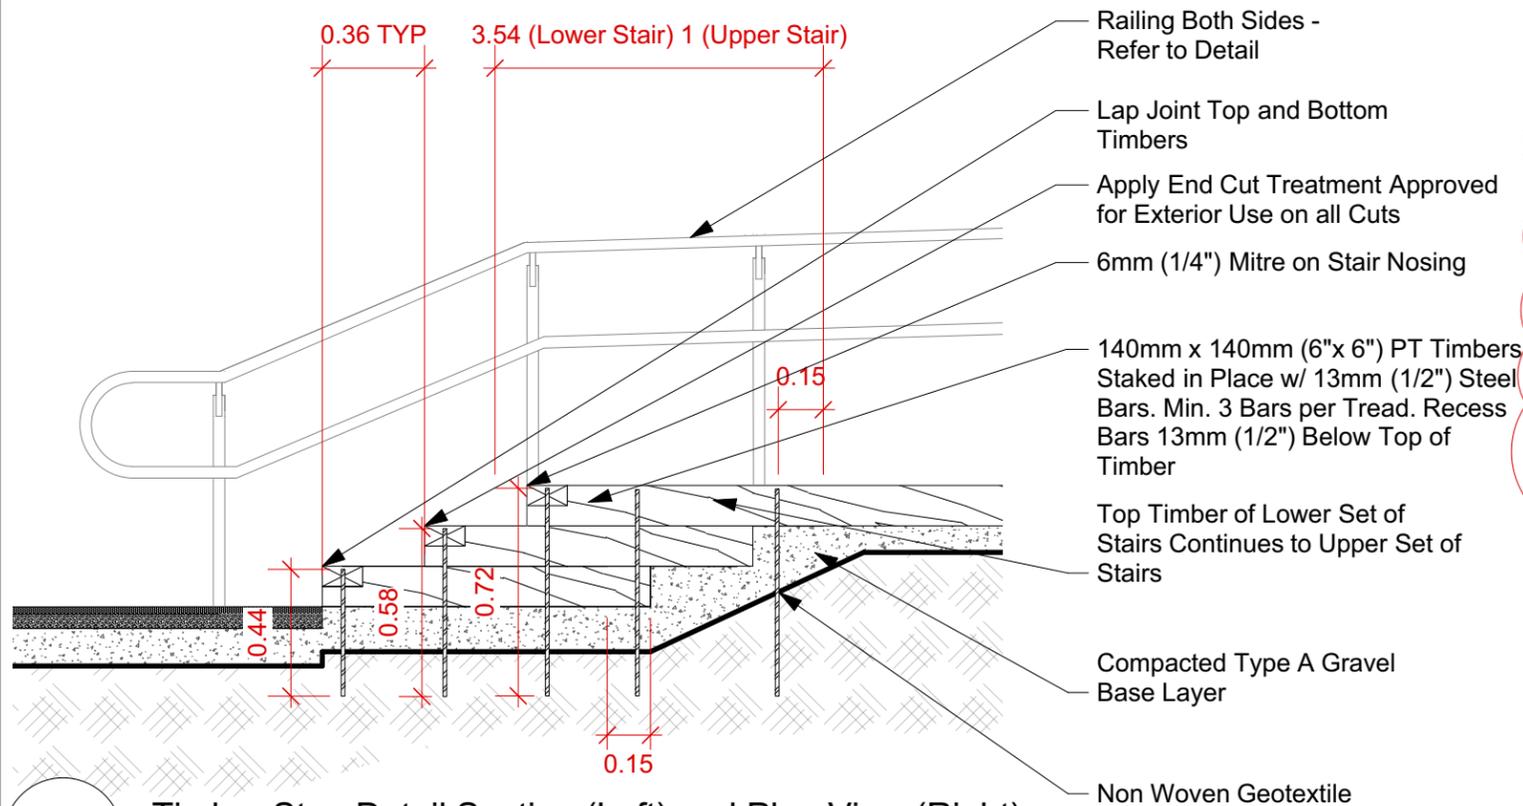

2 Timber Step Detail Section (Left) and Plan View (Right)
Scale: 1:25

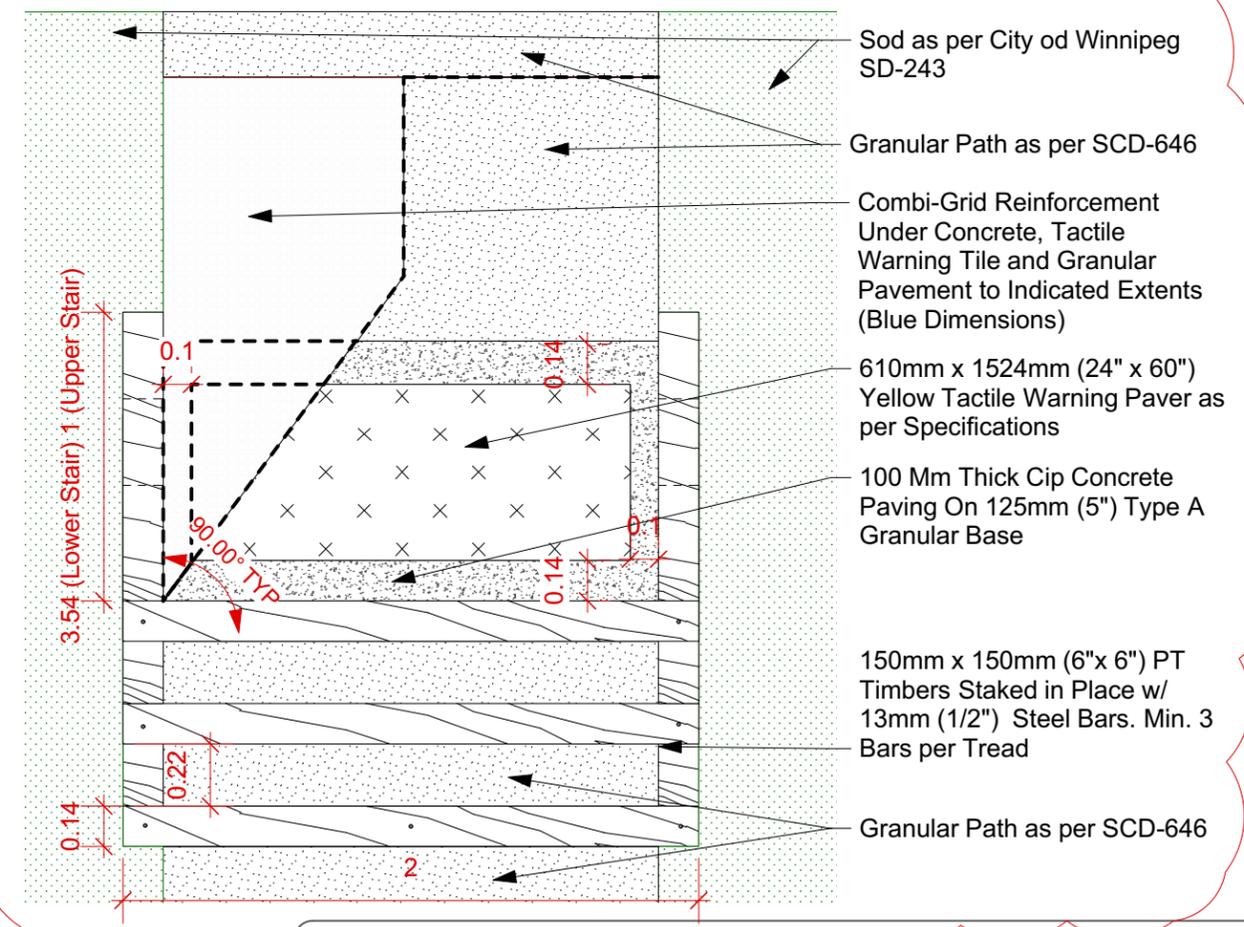

CONTRACTOR TO CONFIRM ALL DIMENSIONS AND REPORT ANY DISCREPANCIES TO CONTRACT ADMINISTRATOR PRIOR TO CONSTRUCTION. LOCATION OF UNDERGROUND STRUCTURES AS SHOWN ARE BASED ON THE BEST INFORMATION AVAILABLE BUT NO GUARANTEE IS GIVEN THAT ALL EXISTING UTILITIES ARE SHOWN OR THAT THE GIVEN LOCATIONS ARE EXACT. CONFIRMATION OF EXISTENCE AND EXACT LOCATION OF ALL SERVICES MUST BE OBTAINED FROM THE INDIVIDUAL UTILITIES BEFORE PROCEEDING WITH CONSTRUCTION.



THE CITY OF WINNIPEG
Planning, Property and Development Department
Planning and Land Use Division
Unit 15 - 30 Fort Street, Winnipeg, MB, (R3C 4X5)

DESIGNED BY	IM	CHECKED BY	
DRAWN BY	IM	APPROVED BY	
HORIZ. SCALE	Varies		
VERT. SCALE			
DATE	July 2020		

MANAGER,
PARK AND OPEN SPACES
DATE

MANAGER,
PLANNING AND LAND USE DIVISION
DATE

DRAWING TITLE
**VAN WALLEGHEM PARK
PATHWAY IMPROVEMENTS
Details**

SITE ADDRESS **37 Lindenwood Drive West**

DRAWING NO.
**V.7-L-R1
ADDENDUM 1**

BID OPPORTUNITY NO.
476 -2020