




**1 SECTION**  
S2.1 | S2.2 | 1:20

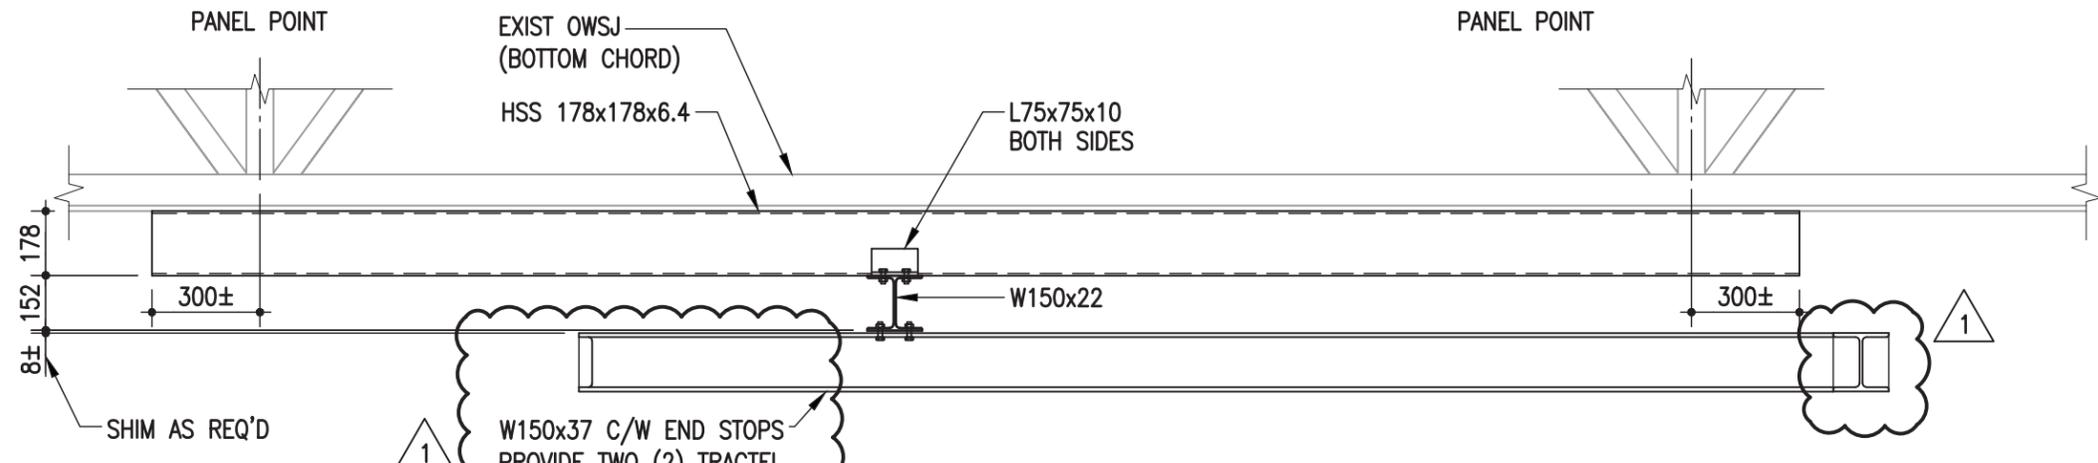

**2 SECTION**  
S2.1 | S2.2 | 1:20

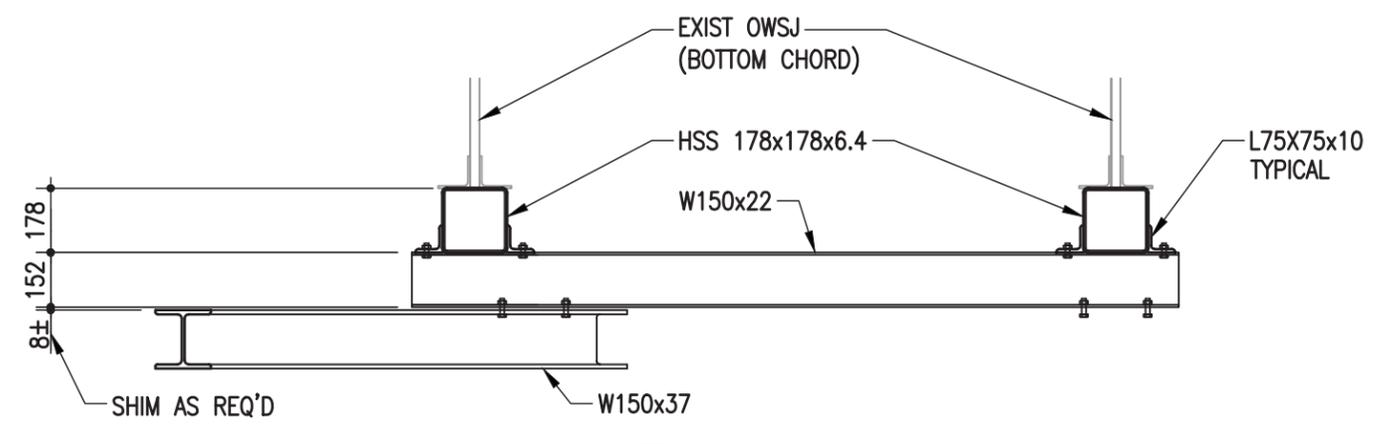

**3 SECTION**  
S2.1 | S2.2 | 1:20

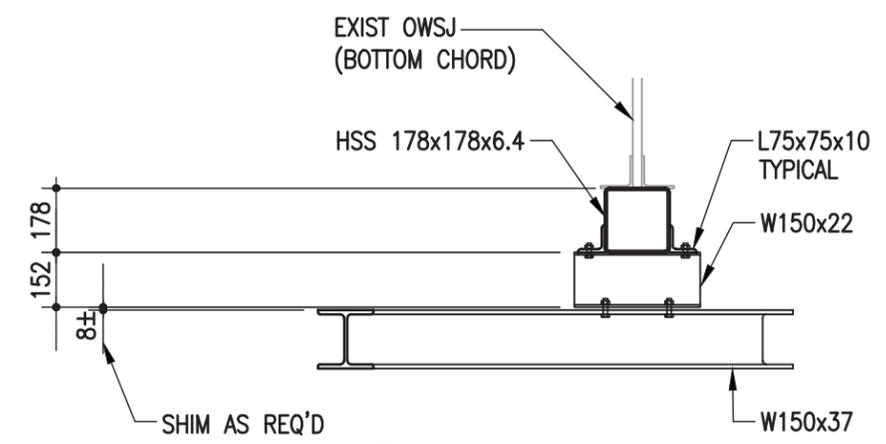

**4 SECTION**  
S2.1 | S2.2 | 1:20

**ENGINEERS  
GEOSCIENTISTS  
MANITOBA**  
Certificate of Authorization  
Crosier Kilgour & Partners Ltd.  
No. 235



2021-06-17

No.	Date	Issue/Revision	By
1	2021-06-16	ADDENDUM 01	HJL
0	2021-06-04	ISSUED FOR CONSTRUCTION	NK

300-275 Carlton Street  
Winnipeg, Manitoba R3C 5R6  
T 204. 943. 7501  
F 204. 943. 7507



**Crosier Kilgour  
& Partners Ltd.**  
CONSULTING STRUCTURAL ENGINEERS

Project  
**WINNIPEG TRANSIT**  
ROOF FALL ARREST  
FORT ROUGE GARAGE - BUILDING 'A'  
421 OSBORNE STREET  
WINNIPEG, MANITOBA

Sheet Title  
**SECTIONS**

File 2021-0352	Date 2021-06-16
Design NK	Drawn CJM
Revision <b>1</b>	Sheet No. <b>S2.2</b>