


**SITE KEY PLAN**  
N.T.S.

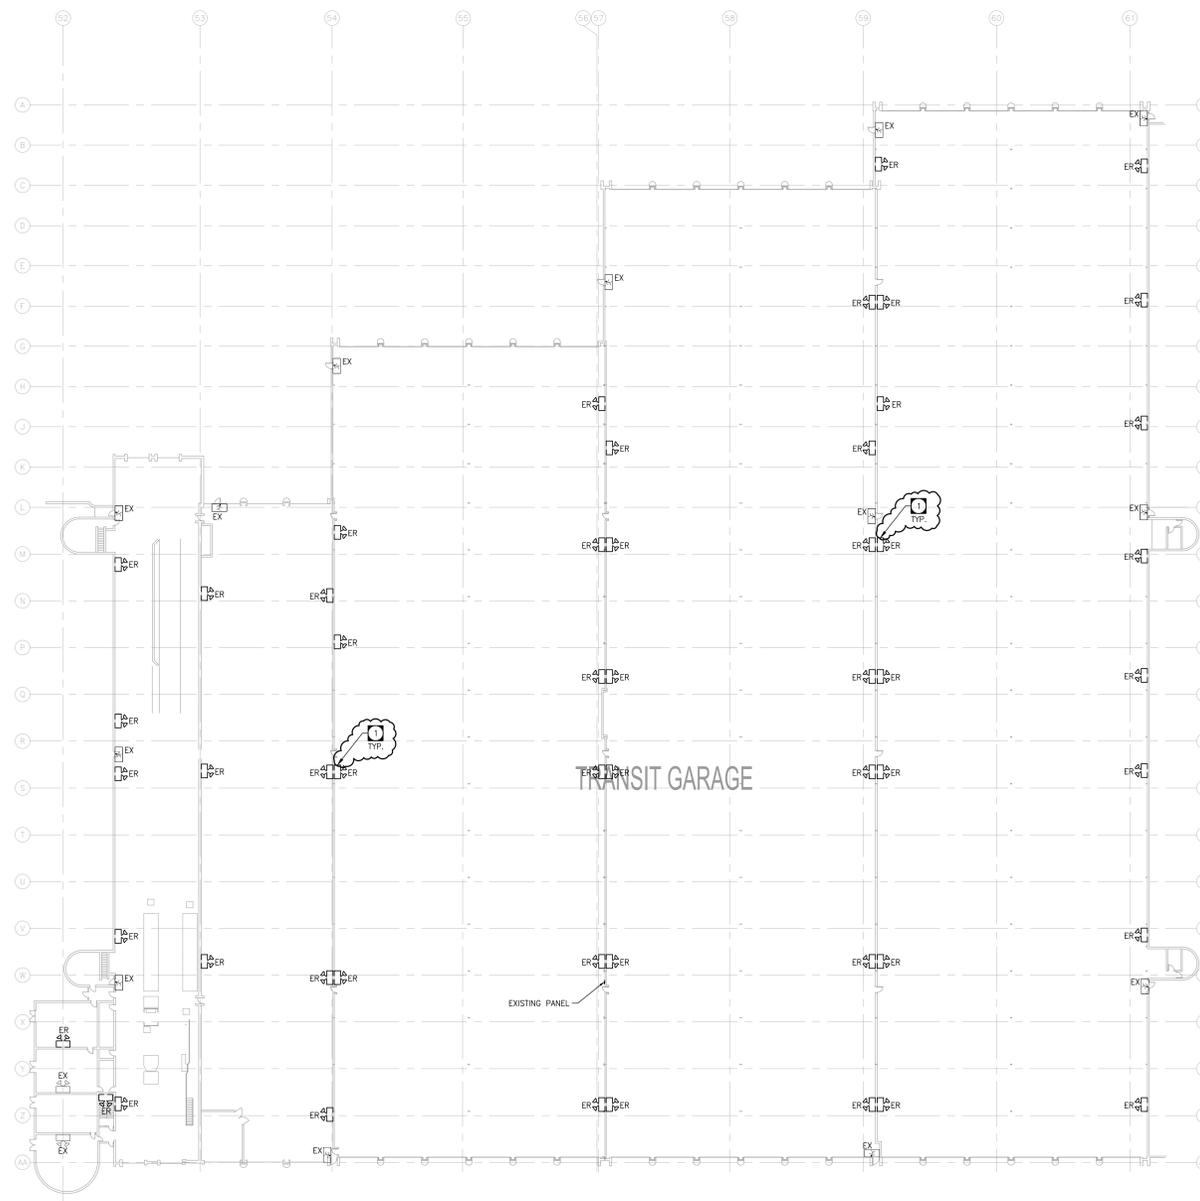

**BUILDING B**  
SCALE: 1/32"=1'-0"

**DRAWING NOTES:**  
 DEMOLISH EXISTING RECEPTACLES AND CONDUIT BACK TO SOURCE.

NO.	REVISIONS	DATE	BY
1	ADDENDUM E02	2021-11-08	JRF
0	ISSUED FOR CONSTRUCTION	2021-09-15	JRF

**TOWER ENGINEERING** towereng.ca  
Project: 191529

Calgary: 403-235-2655  
Winnipeg: 204-925-1150

These design documents are prepared solely for the use by the party with whom the design professional has entered into a contract and there are no representations of any kind made by the design professional to any party with whom the design professional has not entered into a contract. Any use of the drawing, disk or electronic data without the expressed written permission of Tower Engineering Group is strictly prohibited. The contractor is responsible to verify all dimensions with conditions on the site and report discrepancies to Tower Engineering for adjustment. All prints to be returned.

SEAL

**APEGM**  
Certificate of Authorization  
Tower Engineering Group  
No. 4156

PROJECT

**TRANSIT  
EMERGENCY LIGHTING**  
421 OSBORNE  
WINNIPEG, MANITOBA

DRAWING

**BUILDING B  
DEMOLITION PLAN**

DESIGNED: JRF	DRAWING NO.
DRAWN: VRR	505-2021_DRAWING_E1.3
CHECKED: SMM	REVISION
SCALE: AS NOTED	R1
PLOT DATE: 2021-11-08	
PROJECT NO.: 191529	