




1 SECTION
S2.1 | S4.1 | 1:20

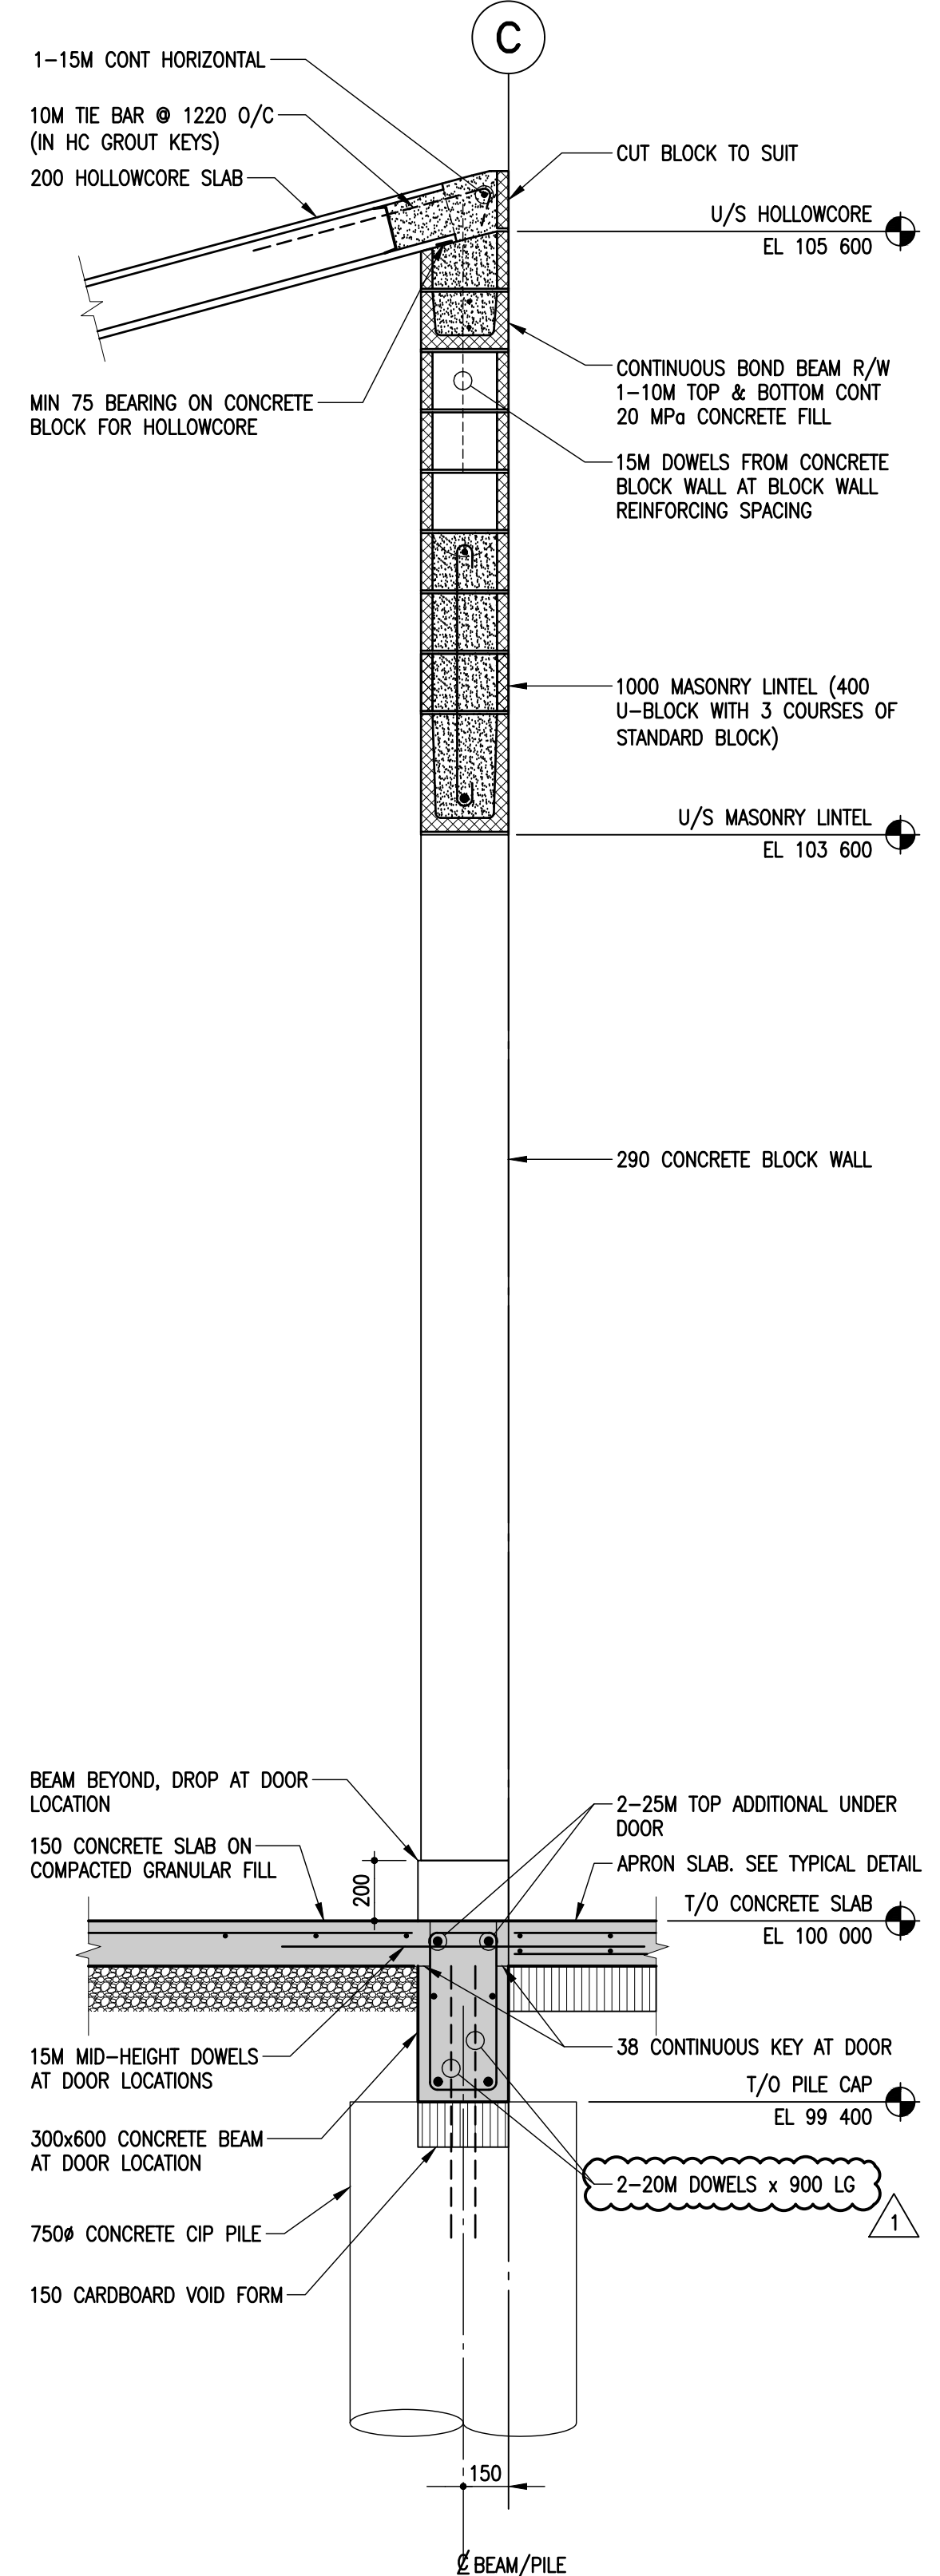

2 SECTION
S2.1 | S4.1 | 1:20

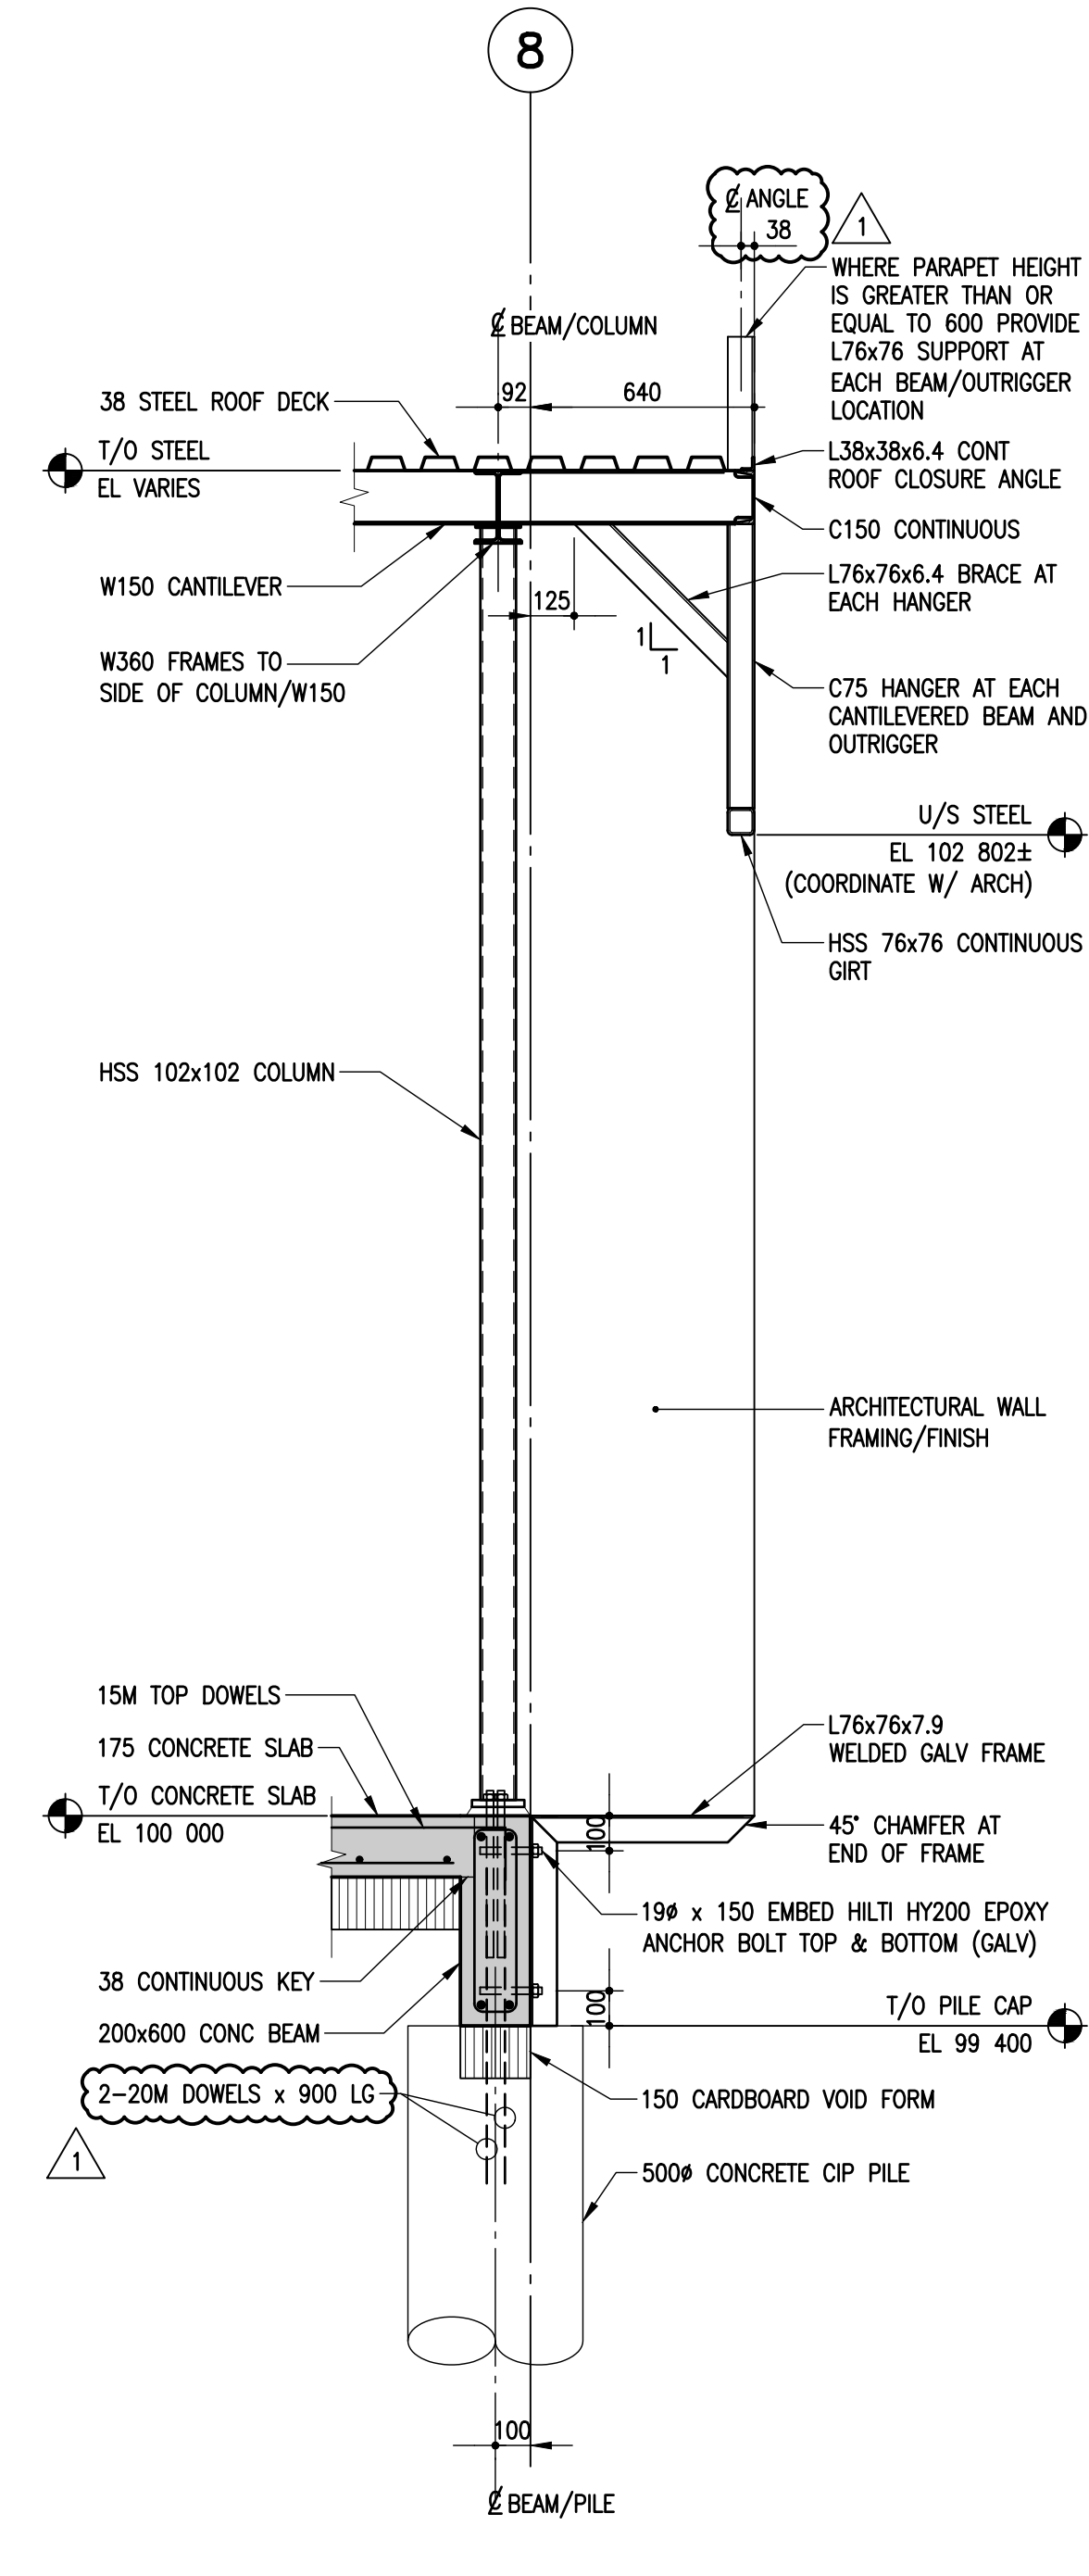

3 SECTION
S2.1 | S4.1 | 1:20

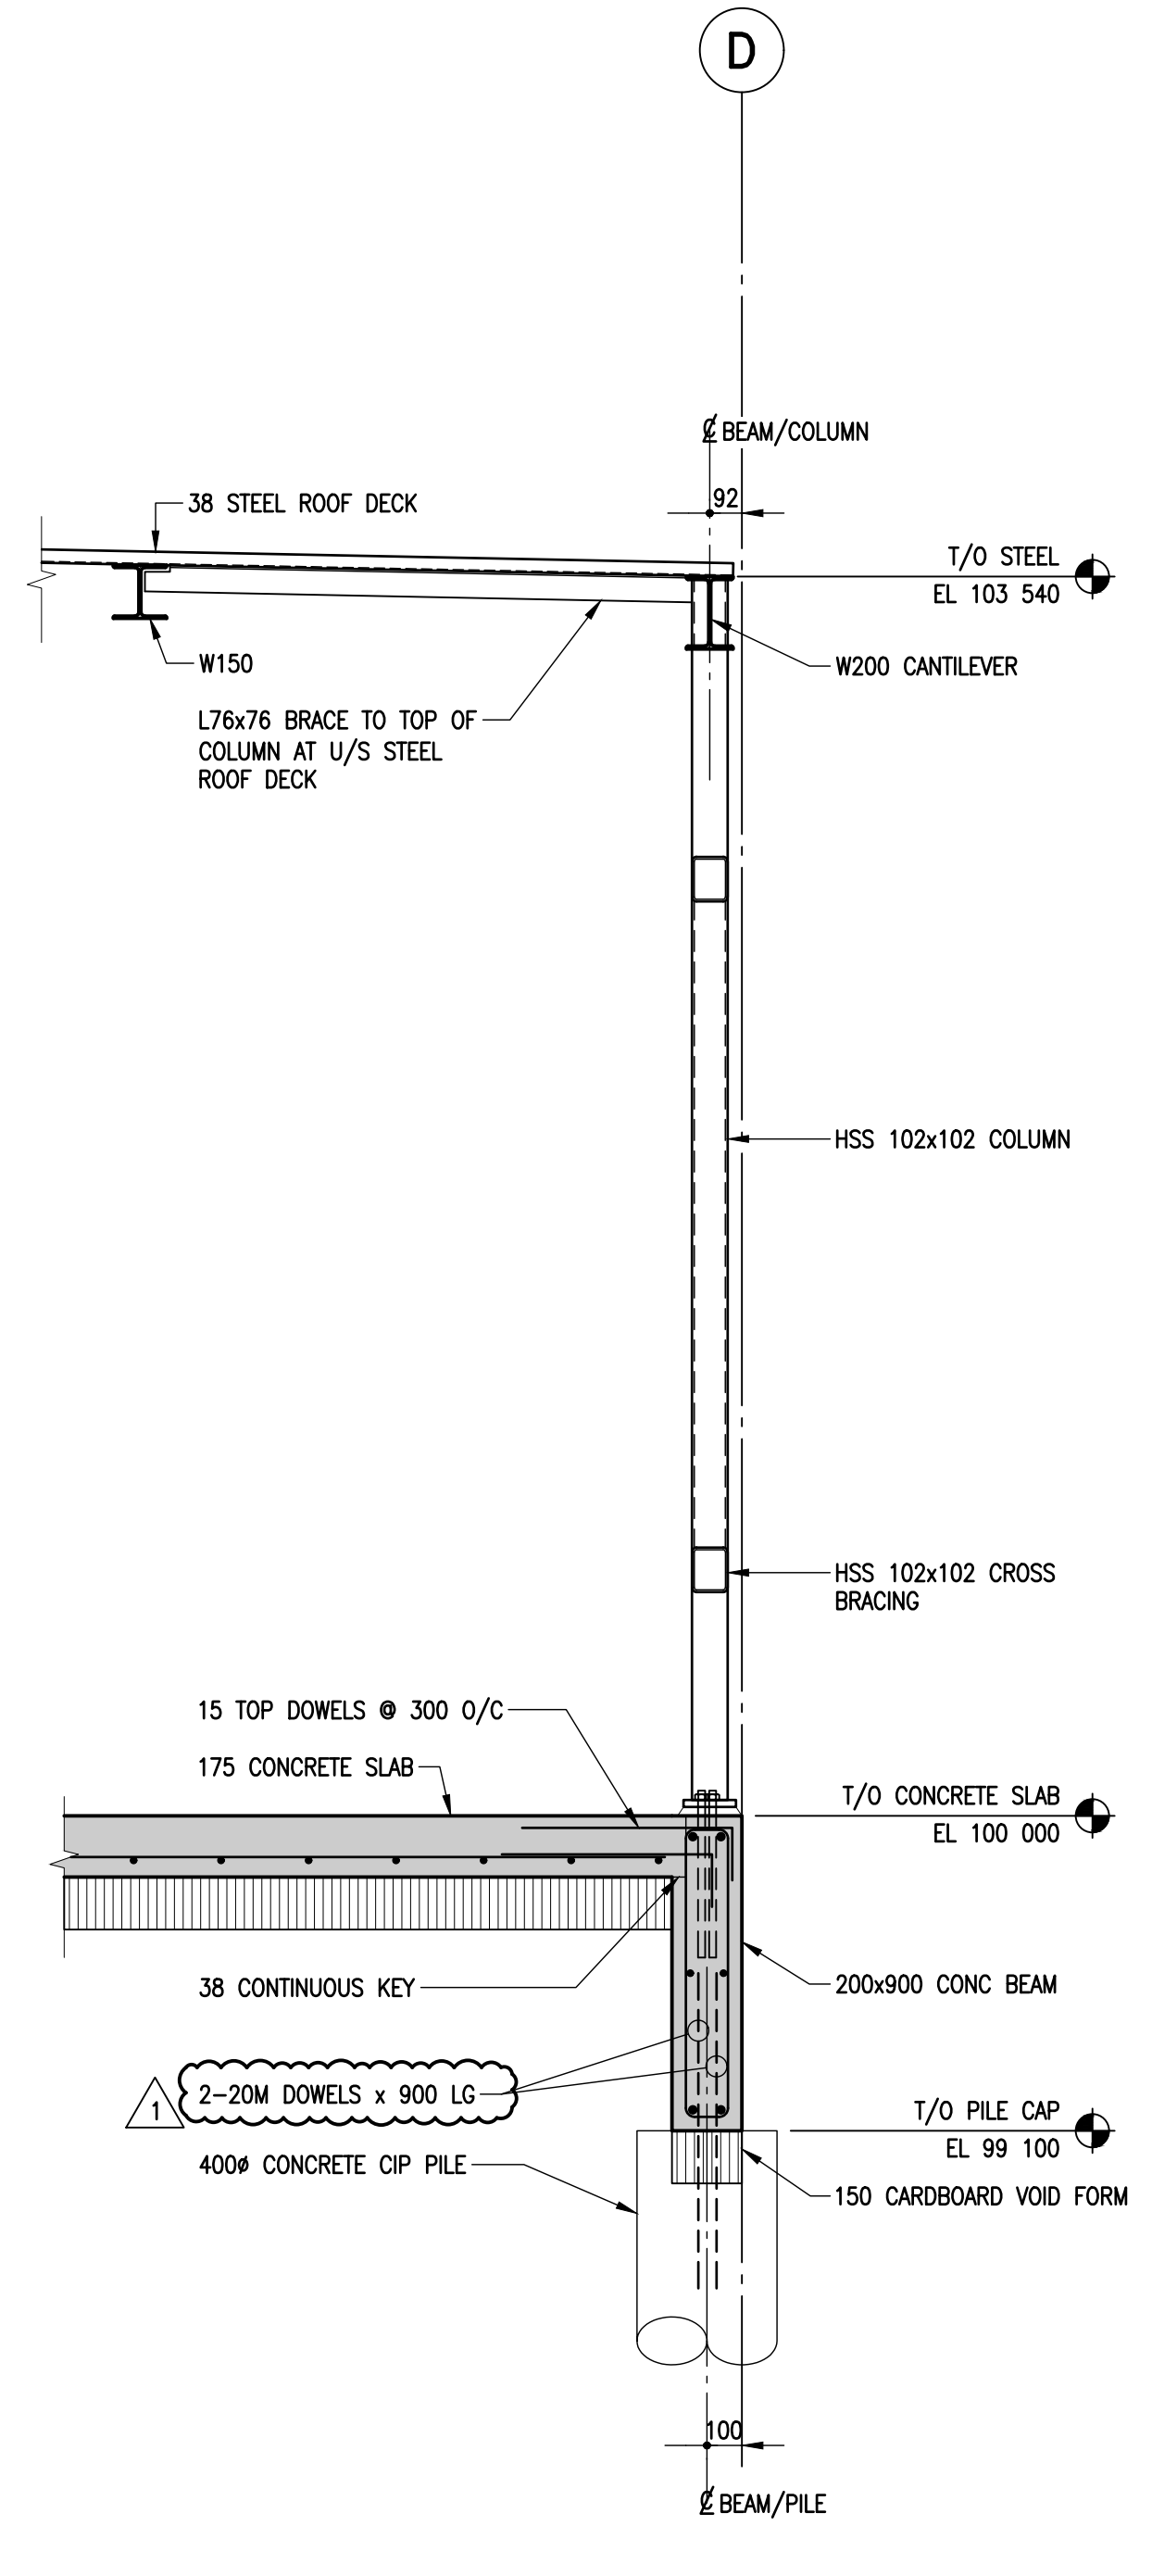

4 SECTION
S2.1 | S4.1 | 1:20

NO.	DATE	REVISION / ISSUANCE
3	-	-
2	-	-
1	21.12.13	ISSUED FOR ADDENDUM #2
0	21.10.29	ISSUED FOR CONSTRUCTION

architecture inc.
100 Fort Street, Suite 109 Winnipeg, Manitoba R3C 1C7 204 318 2010

300-275 Carlton Street
Winnipeg, Manitoba R3C 5R6
T 204. 943. 7501
F 204. 943. 7507
2021-0367

**Crosier Kilgour
& Partners Ltd.**
CONSULTING STRUCTURAL ENGINEERS

Project
**ST. VITAL PARK
GARAGE & STAFF HOUSE
190 RIVER ROAD**

Sheet Title
SECTIONS

Project No.	20105
Date	21.12.13

S4.1
R1