




SEWER JUNCTION INFORMATION FROM SEWER VIDEO INSPECTION		
SEWER ID S-MA60010601		
DISTANCE FROM MH60008886		
DISTANCE	DIAMETER	CLOCK
17.3	150	10:00
17.3	150	2:00
31.3	150	10:00
31.3	150	2:00
31.8	150	10:00
33.6	150	12:00
45.3	150	10:00
45.3	150	2:00
56.5	200	10:00
56.5	200	2:00
60.1	150	10:00
30.1	150	2:00
73.6	200	10:00
74.2	150	10:00
74.2	150	2:00
88.0	150	10:00
88.0	150	2:00

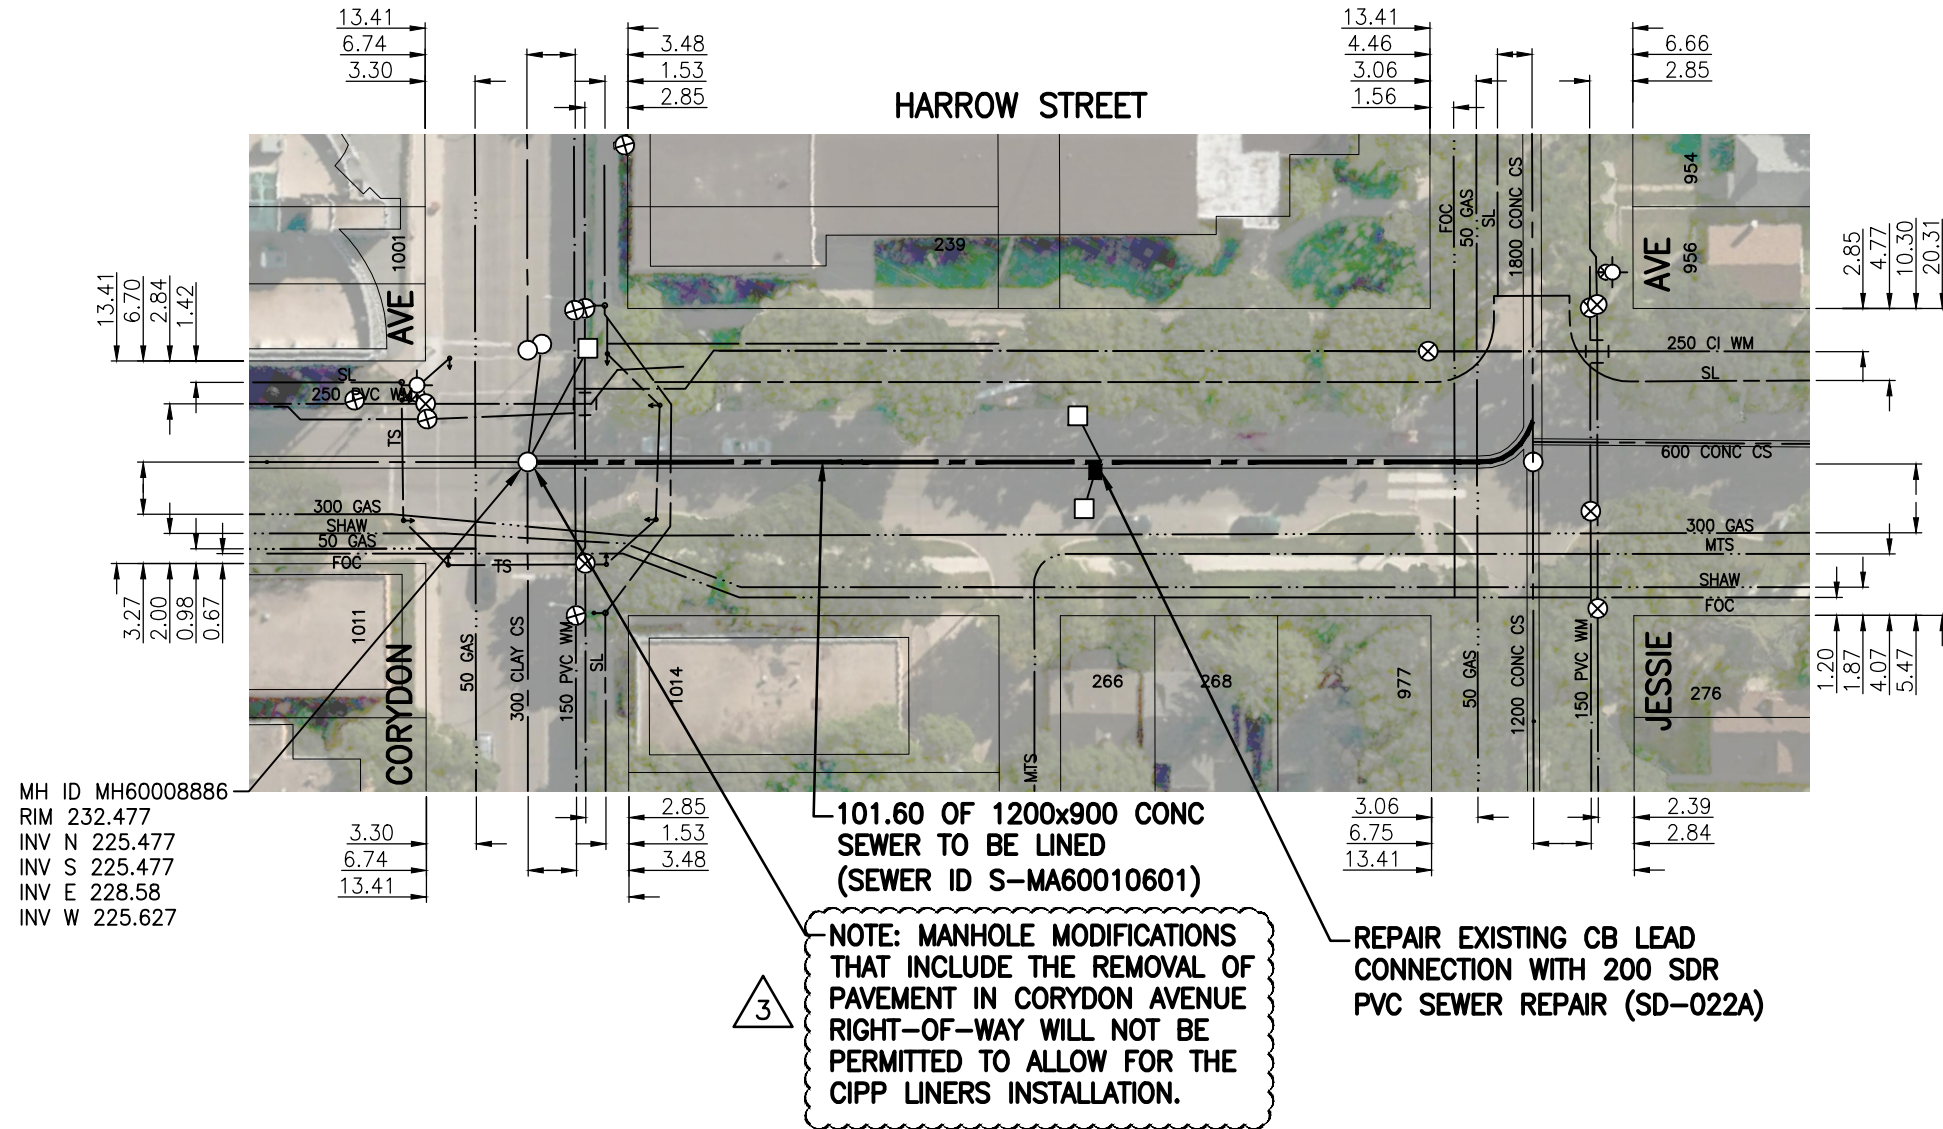

MH ID MH60008886
 RIM 232.477
 INV N 225.477
 INV S 225.477
 INV E 228.58
 INV W 225.627

WARNING

IF POWER EQUIPMENT OR EXPLOSIVES ARE TO BE USED FOR EXCAVATION ON THIS PROJECT THE CONTRACTOR MUST:

- 1) NOTIFY THE GAS COMPANY OF THE PROPOSED LOCATION OF EXCAVATION.
- 2) TAKE PRECAUTION TO AVOID DAMAGE TO GAS COMPANY INSTALLATIONS.

SEE PROVINCIAL REGULATION 140/92 FOR DETAILS

**ENGINEERS
 GEOSCIENTISTS
 MANITOBA**
 Certificate of Authorization
 Stantec Consulting Ltd.
 No. 1301

METRIC
 WHOLE NUMBERS INDICATE MILLIMETRES
 DECIMALIZED NUMBERS INDICATE METRES

1:750

TENDER NO. 90-2021

FOR INDEX SEE
12808

V:\112\active\11220080\0300_drawing\0302_sheet_files\02_civil\20080c-101.dwg

LOCATION APPROVED UNDERGROUND STRUCTURES SUPV. U/G STRUCTURES _____ DATE _____ COMMITTEE _____ NOTE: LOCATION OF UNDERGROUND STRUCTURES AS SHOWN ARE BASED ON THE BEST INFORMATION AVAILABLE BUT NO GUARANTEE IS GIVEN THAT ALL EXISTING UTILITIES ARE SHOWN OR THAT THE GIVEN LOCATIONS ARE EXACT. CONFIRMATION OF EXISTENCE AND EXACT LOCATION OF ALL SERVICES MUST BE OBTAINED FROM THE INDIVIDUAL UTILITIES BEFORE PROCEEDING WITH CONSTRUCTION.	B.M. ELEV. <table border="1"> <tr><td> </td><td> </td><td> </td><td> </td></tr> <tr><td> </td><td> </td><td> </td><td> </td></tr> <tr><td> </td><td> </td><td> </td><td> </td></tr> <tr><td> </td><td> </td><td> </td><td> </td></tr> </table>																	 311 Portage Avenue, Winnipeg, Manitoba Tel 204-489-5900 Fax 204-453-9012	ENGINEER'S SEAL ORIGINAL SEALED BY R. SHERLOCK P. ENG. 2021-03-22 CONSULTANT DRAWING NO. C-103	 THE CITY OF WINNIPEG WATER AND WASTE DEPARTMENT 2021 SEWER RENEWALS BY CIPP LINING (LARGE DIAMETER) CONTRACT 4 HARROW STREET MH AT CORYDON AVENUE TO MH AT JESSIE AVENUE	SHEET OF 05 09													
<table border="1"> <tr> <th>NO.</th> <th>REVISIONS</th> <th>DATE</th> <th>BY</th> </tr> <tr> <td>3</td> <td>ISSUED FOR ADDENDUM #1</td> <td>21.03.29</td> <td>RS</td> </tr> <tr> <td>2</td> <td>ISSUED FOR TENDER</td> <td>21.03.22</td> <td>RS</td> </tr> <tr> <td>1</td> <td>ISSUED FOR REVIEW</td> <td>21.03.12</td> <td>RS</td> </tr> </table>	NO.	REVISIONS	DATE	BY	3	ISSUED FOR ADDENDUM #1	21.03.29	RS	2	ISSUED FOR TENDER	21.03.22	RS	1	ISSUED FOR REVIEW	21.03.12	RS	<table border="1"> <tr> <td>DESIGNED BY</td> <td>RS</td> <td>CHECKED BY</td> <td>RS</td> </tr> <tr> <td>DRAWN BY</td> <td>SC</td> <td>APPROVED BY</td> <td>RS</td> </tr> <tr> <td>HOR. SCALE:</td> <td>1:750</td> <td>RELEASED FOR CONSTRUCTION:</td> <td> </td> </tr> <tr> <td>VERTICAL:</td> <td> </td> <td>DATE</td> <td> </td> </tr> </table>	DESIGNED BY	RS	CHECKED BY	RS	DRAWN BY	SC	APPROVED BY	RS	HOR. SCALE:	1:750	RELEASED FOR CONSTRUCTION:		VERTICAL:		DATE		CAD FILE DRAWING NUMBER 20080c-101.dwg CITY DRAWING NUMBER 12811
NO.	REVISIONS	DATE	BY																															
3	ISSUED FOR ADDENDUM #1	21.03.29	RS																															
2	ISSUED FOR TENDER	21.03.22	RS																															
1	ISSUED FOR REVIEW	21.03.12	RS																															
DESIGNED BY	RS	CHECKED BY	RS																															
DRAWN BY	SC	APPROVED BY	RS																															
HOR. SCALE:	1:750	RELEASED FOR CONSTRUCTION:																																
VERTICAL:		DATE																																