


GENERAL NOTES:  
1. LOCATIONS OF INSTRUMENTS ARE APPROXIMATE.

KEYNOTES:  
1 EMERGENCY SHUTDOWN BUTTON INSTALLED ON SECOND LEVEL PLATFORM.

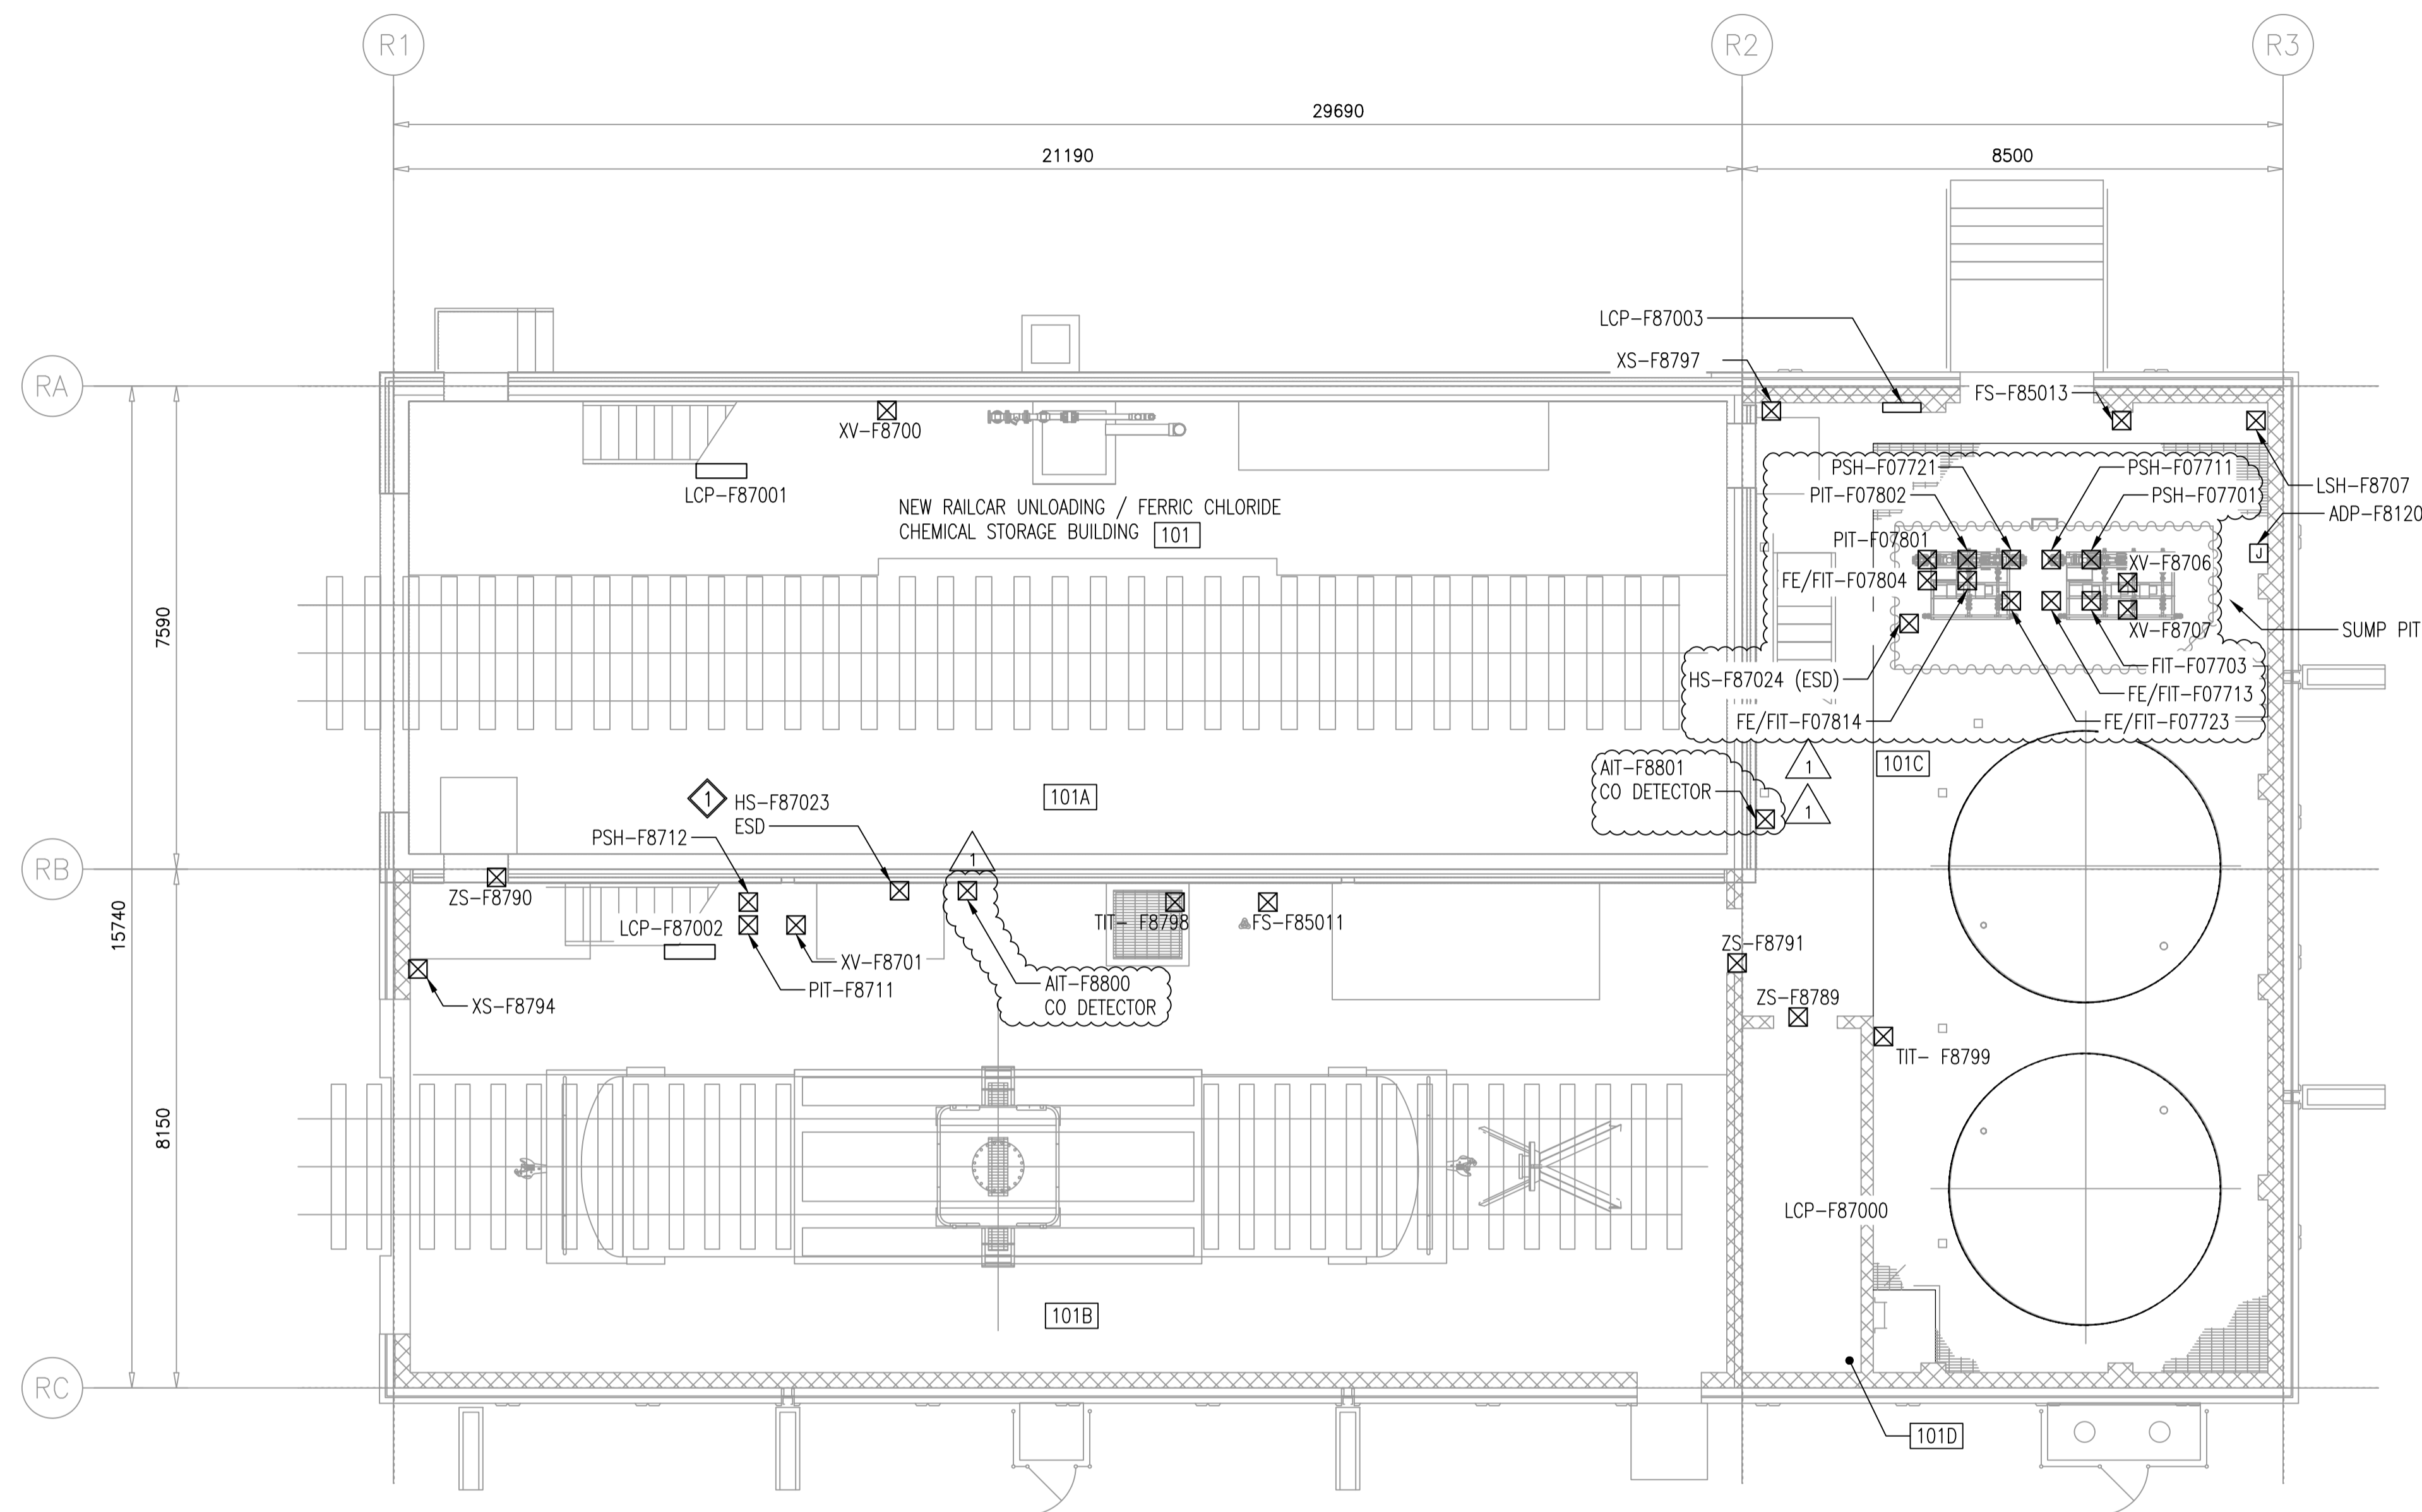

**A**  
PLAN - MAIN FLOOR  
2000 0 2000 4000 6000  
SCALE: 1:75mm

NO.	DRAWING NUMBER	REFERENCE DRAWING TITLE



NO.	REVISIONS	DATE	BY

<b>KGS GROUP</b>			
DESIGNED BY	DG	CHECKED BY	JAB
DRAWN BY	RG	APPROVED BY	JAB
SCALE: AS SHOWN		RELEASED FOR CONSTRUCTION	
DATE	2022 03 09	DATE	

 <b>THE CITY OF WINNIPEG</b> WATER AND WASTE DEPARTMENT ENGINEERING DIVISION	
NORTH END SEWAGE TREATMENT PLANT (NEWPCC) INTERIM PHOSPHOROUS REMOVAL AUTOMATION BUILDING 101 MAIN FLOOR INSTRUMENT LOCATION PLAN	
CONSULTANT DRAWING NUMBER	21-0107-015_A2.111
CITY DRAWING NUMBER	1-0101-AGAD-F202-001
SHEET	1 OF 1