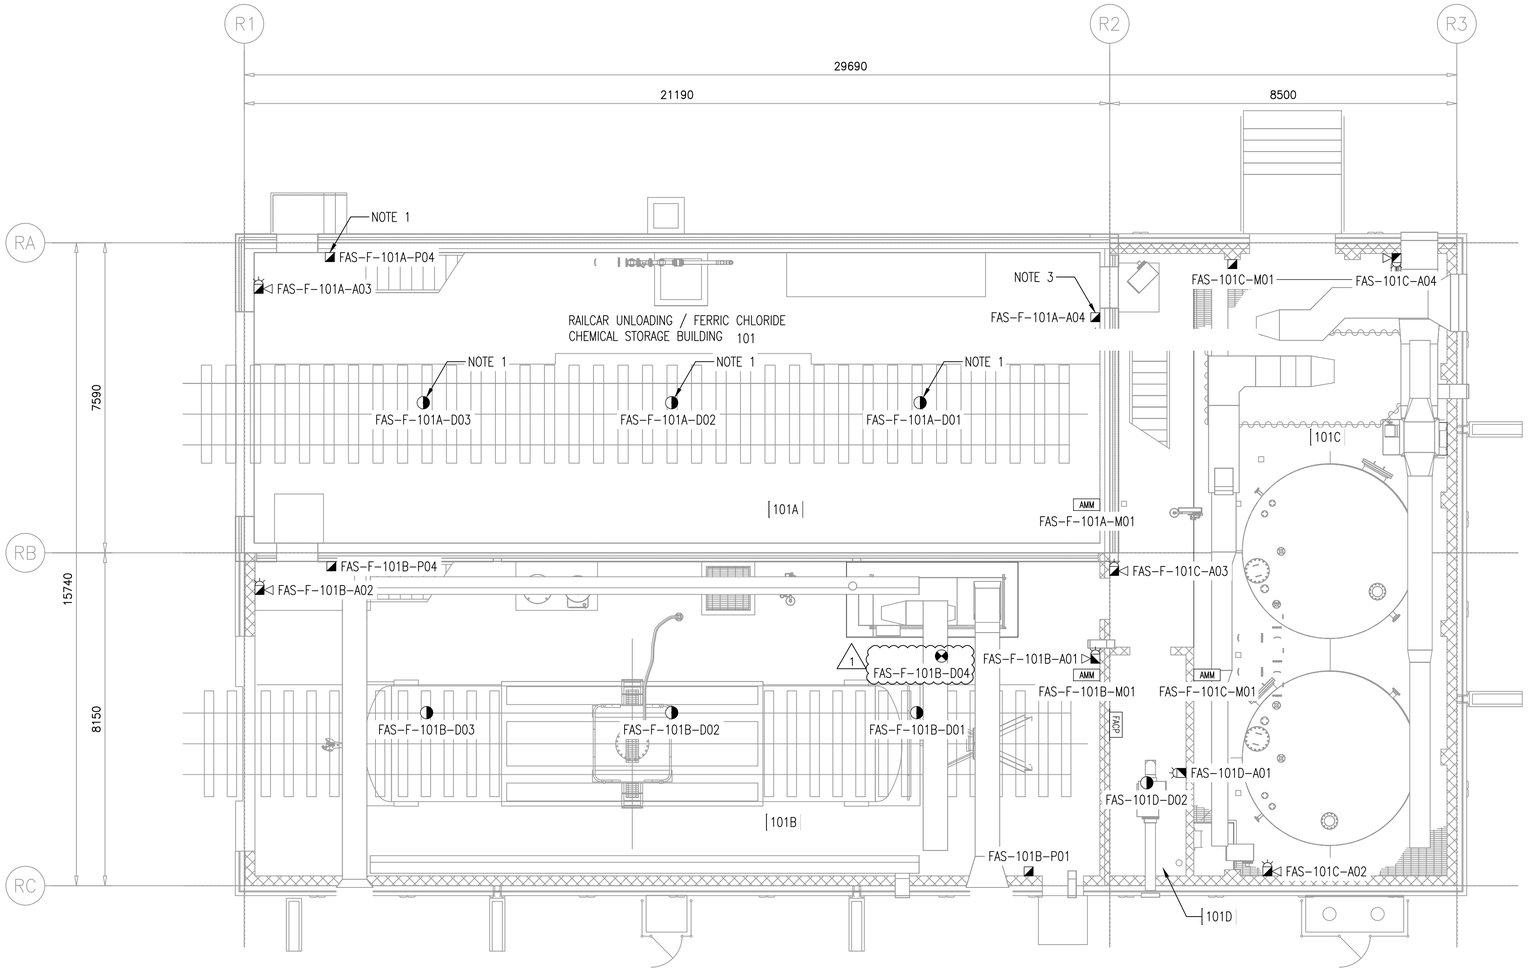

A
–

BUILDING 101 FIRE ALARM PLAN

2000 0 2000 4000 6000

SCALE: 1:75mm

GENERAL NOTES:

1. EXISTING FIRE ALARM DETECTION DEVICES TO REMAIN AND TO BE DISCONNECTED FROM THE EXISTING FIRE ALARM SYSTEM. WIRE AND CONNECT TO THE NEW FIRE ALARM PANEL. PROVIDE ADDRESSABLE MONITORING MODULE. MODIFY EXISTING WIRING AS REQRUIRED. CONFIRM POINT OF CONNECTION ON SITE.
2. EXISTING FIRE ALARM BELL AND NAC CIRCUIT TO BE DISCONNECTED AND REMOVED.
3. DISCONNECT AND REMOVE EXISTING PULL STATION AND ALL ASSOCIATED ACCESSORIES.

BUILDING/ROOM LEGEND:

101 – RAILCAR UNLOADING / FERRIC CHLORIDE CHEMICAL STORAGE BUILDING (NEW)

101A – RAILCAR SHELTER 1 (EXISTING)

101B – RAILCAR SHELTER 2 (NEW)

101D – NEW ELECTRICAL ROOM

NO.	DRAWING NUMBER	REFERENCE DRAWING TITLE

REFERENCE DRAWINGS

ENGINEERS GEOSCIENTISTS MANITOBA
Certificate of Authorization
KGS Group
No. 245

B.M.
ELEV.

CONSTRUCTION COMPLETION DATE: YYYY MM DD

NO.	REVISIONS	DATE	BY
1	RE-ISSUED FOR CONSTRUCTION	2022 07 05	JAB
0	ISSUED FOR CONSTRUCTION	2022 05 18	JAB

KGS GROUP

DESIGNED BY	DG	CHECKED BY	JAB
DRAWN BY	RG	APPROVED BY	JAB
SCALE:	AS SHOWN	RELEASED FOR CONSTRUCTION	
DATE	2022 02 25	DATE	

PLOT DATE: 2022 07 12

ENGINEER'S SEAL
PROVINCE OF MANITOBA
JAMES A. BOUCHARD
Member
20560
2022-07-14
REGISTERED PROFESSIONAL ENGINEER

CONSULTANT DRAWING NUMBER
21-0107-015_E2.131

Winnipeg

THE CITY OF WINNIPEG
WATER AND WASTE DEPARTMENT
ENGINEERING DIVISION

NORTH END SEWAGE TREATMENT PLANT (NEWPCC)
INTERIM PHOSPHOROUS REMOVAL
ELECTRICAL

BUILDING 101
FIRE ALARM LAYOUT

CITY DRAWING NUMBER 1-0101-EFAS-F201-001 SHEET 1 OF 1

BID OPPORTUNITY: 197-2022
CONTRACT NUMBER:

FILE PATH: \\192.168.0.226\y-data\Projects\2021\21-0107-015\Dwg\Elec\ADDENDUM\
FILE NAME: 1-0101-EFAS-F201-001.dwg