SHEET: COW-A1 (05/2005)

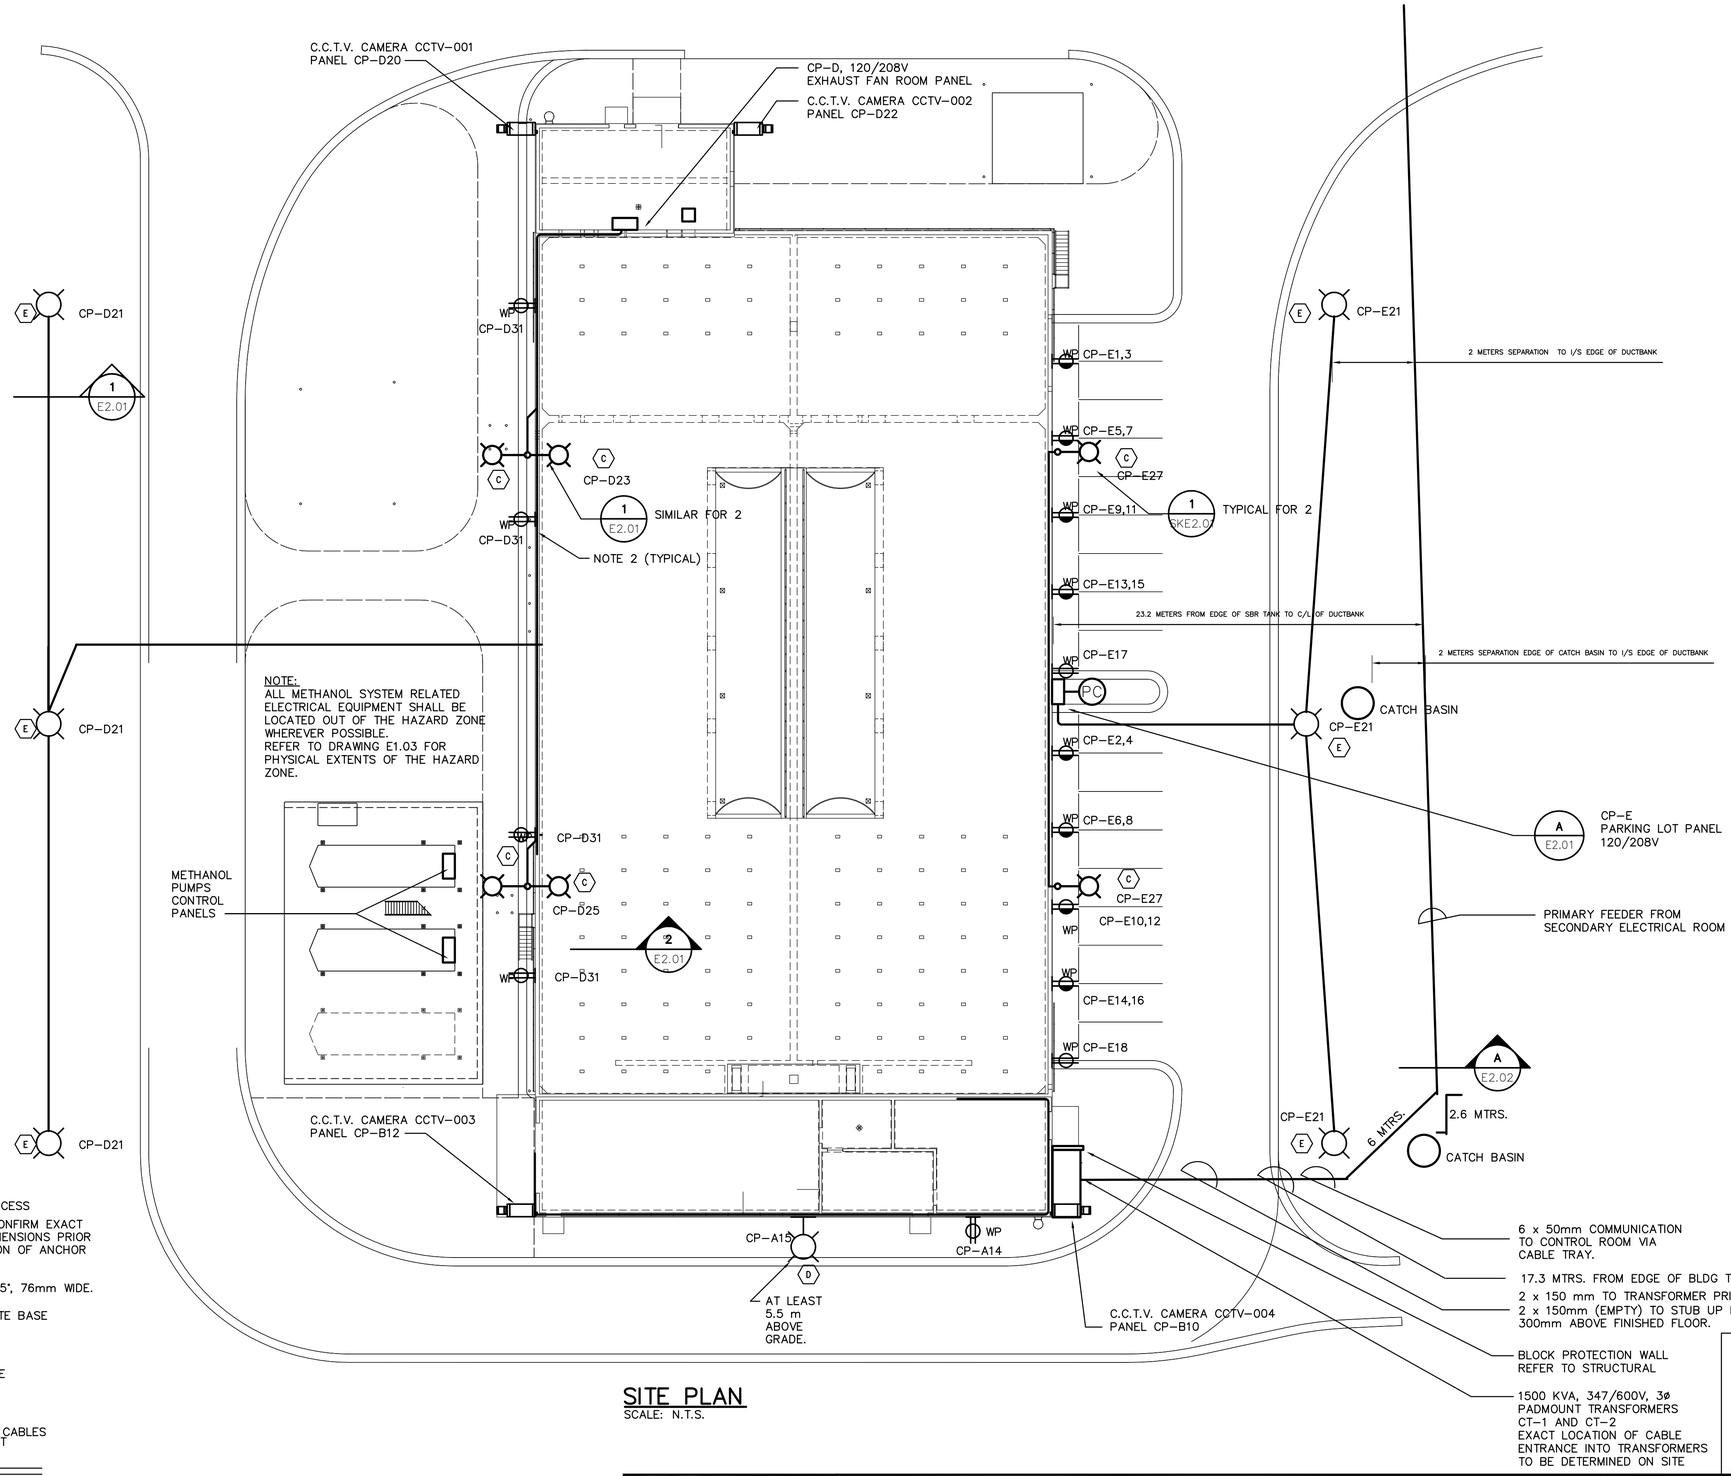

NOTE:
ALL METHANOL SYSTEM RELATED ELECTRICAL EQUIPMENT SHALL BE LOCATED OUT OF THE HAZARD ZONE WHEREVER POSSIBLE.
REFER TO DRAWING E1.03 FOR PHYSICAL EXTENTS OF THE HAZARD ZONE.

WORK COMPLETED AS SPECIFIED HEREIN UNLESS NOTED OTHERWISE.

SITE PLAN
SCALE: N.T.S.

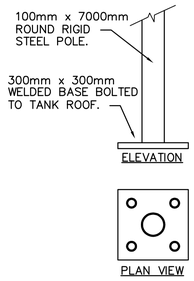

NOTES:
2.1 TYPICAL FOR FIXTURE TYPE 'C'. SBR TANK MOUNTING.

2.2 COORDINATE ALL SBR STAND EQUIPMENT MOUNTING WITH THE CITY AND DIVISION 3 FOR INSTALLATION REQUIREMENTS.

2 E2.01 POLE BASE DETAIL
SCALE N.T.S

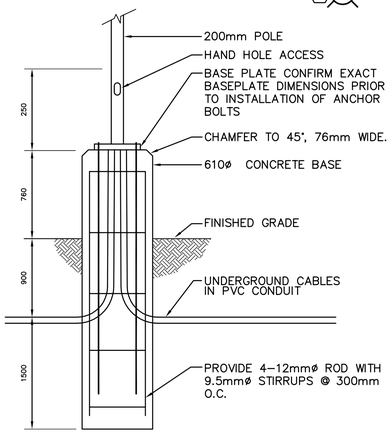

NOTE:
1.1 TYPICAL FIXTURE TYPE 'E'.

1 E2.01 POLE BASE DETAIL
SCALE N.T.S

NOTES:

1. PARKING RECEPTACLES SHALL BE MOUNTED ON EXTERIOR OF BUILDING, ONE (1) METER ABOVE GRADE.

2. ALL GENERAL EXTERIOR RECEPTACLES SHALL BE WEATHER PROOF AND MOUNTED ONE (1) METER ABOVE GRADE.

3. POLES MOUNTED AS PER DETAIL 2/E2.01 LOCATED ~.5 MTR. AWAY FROM SBR 1 & 2 WALL

AECOM
Certificate of Authorization
AECOM Canada Ltd.
Original dated on:
No. 4671 Date: 2005/05/15

B.M.
ELEV.

NO.	REVISIONS	DATE	BY
05	AS-CONSTRUCTED DRAWING	09/02/10	DEP
04	ISSUED FOR CCN 7	07/08/15	ERC
03	ISSUED FOR CONSTRUCTION	06/08/30	CPG
02	291-2006 ADDENDUM 6	06/07/26	CPG
01	291-2006 ADDENDUM 3	06/07/12	CPG
00	ISSUED FOR TENDER	06/05/15	CPG

EarthTech
A Tyco International Ltd. Company

DESIGNED BY	PS	CHECKED BY	GSN
DRAWN BY	CPG	APPROVED BY	JEH
SCALE:	NTS	RELEASED FOR CONSTRUCTION BY:	K. MARTENS
DATE	2006/02/23	DATE	2006/05/23

ENGINEER'S SEAL
ORIGINAL SIGNED BY
P. STRYK
2005/05/15

CONSULTANT DRAWING NO.
E2.01

Winnipeg
THE CITY OF WINNIPEG
WATER AND WASTE DEPARTMENT
ENGINEERING DIVISION

NEWPCC CENTRATE NUTRIENT TREATMENT
NITROGEN REMOVAL FACILITY

CITY FILE NUMBER
SHEET OF

ELECTRICAL
SITE PLAN

CITY DRAWING NUMBER
1-0101C-E0004-001-05

AECOM
As of January 3, 2009, EarthTech became AECOM Canada Ltd.

AECOM WINNIPEG
AS-CONSTRUCTED

Last Save: 2009-06-08 8:58 AM

L:\WORK\66000\66303CEN\02A-CAD\ALL\SUBMISSION\RECORD\NITROGEN\AS-CONSTRUCTED DWG\ELECT_INSTR\1-0101C-E0004-001-05D.DWG