A1 SIZE - 594mm x 841mm

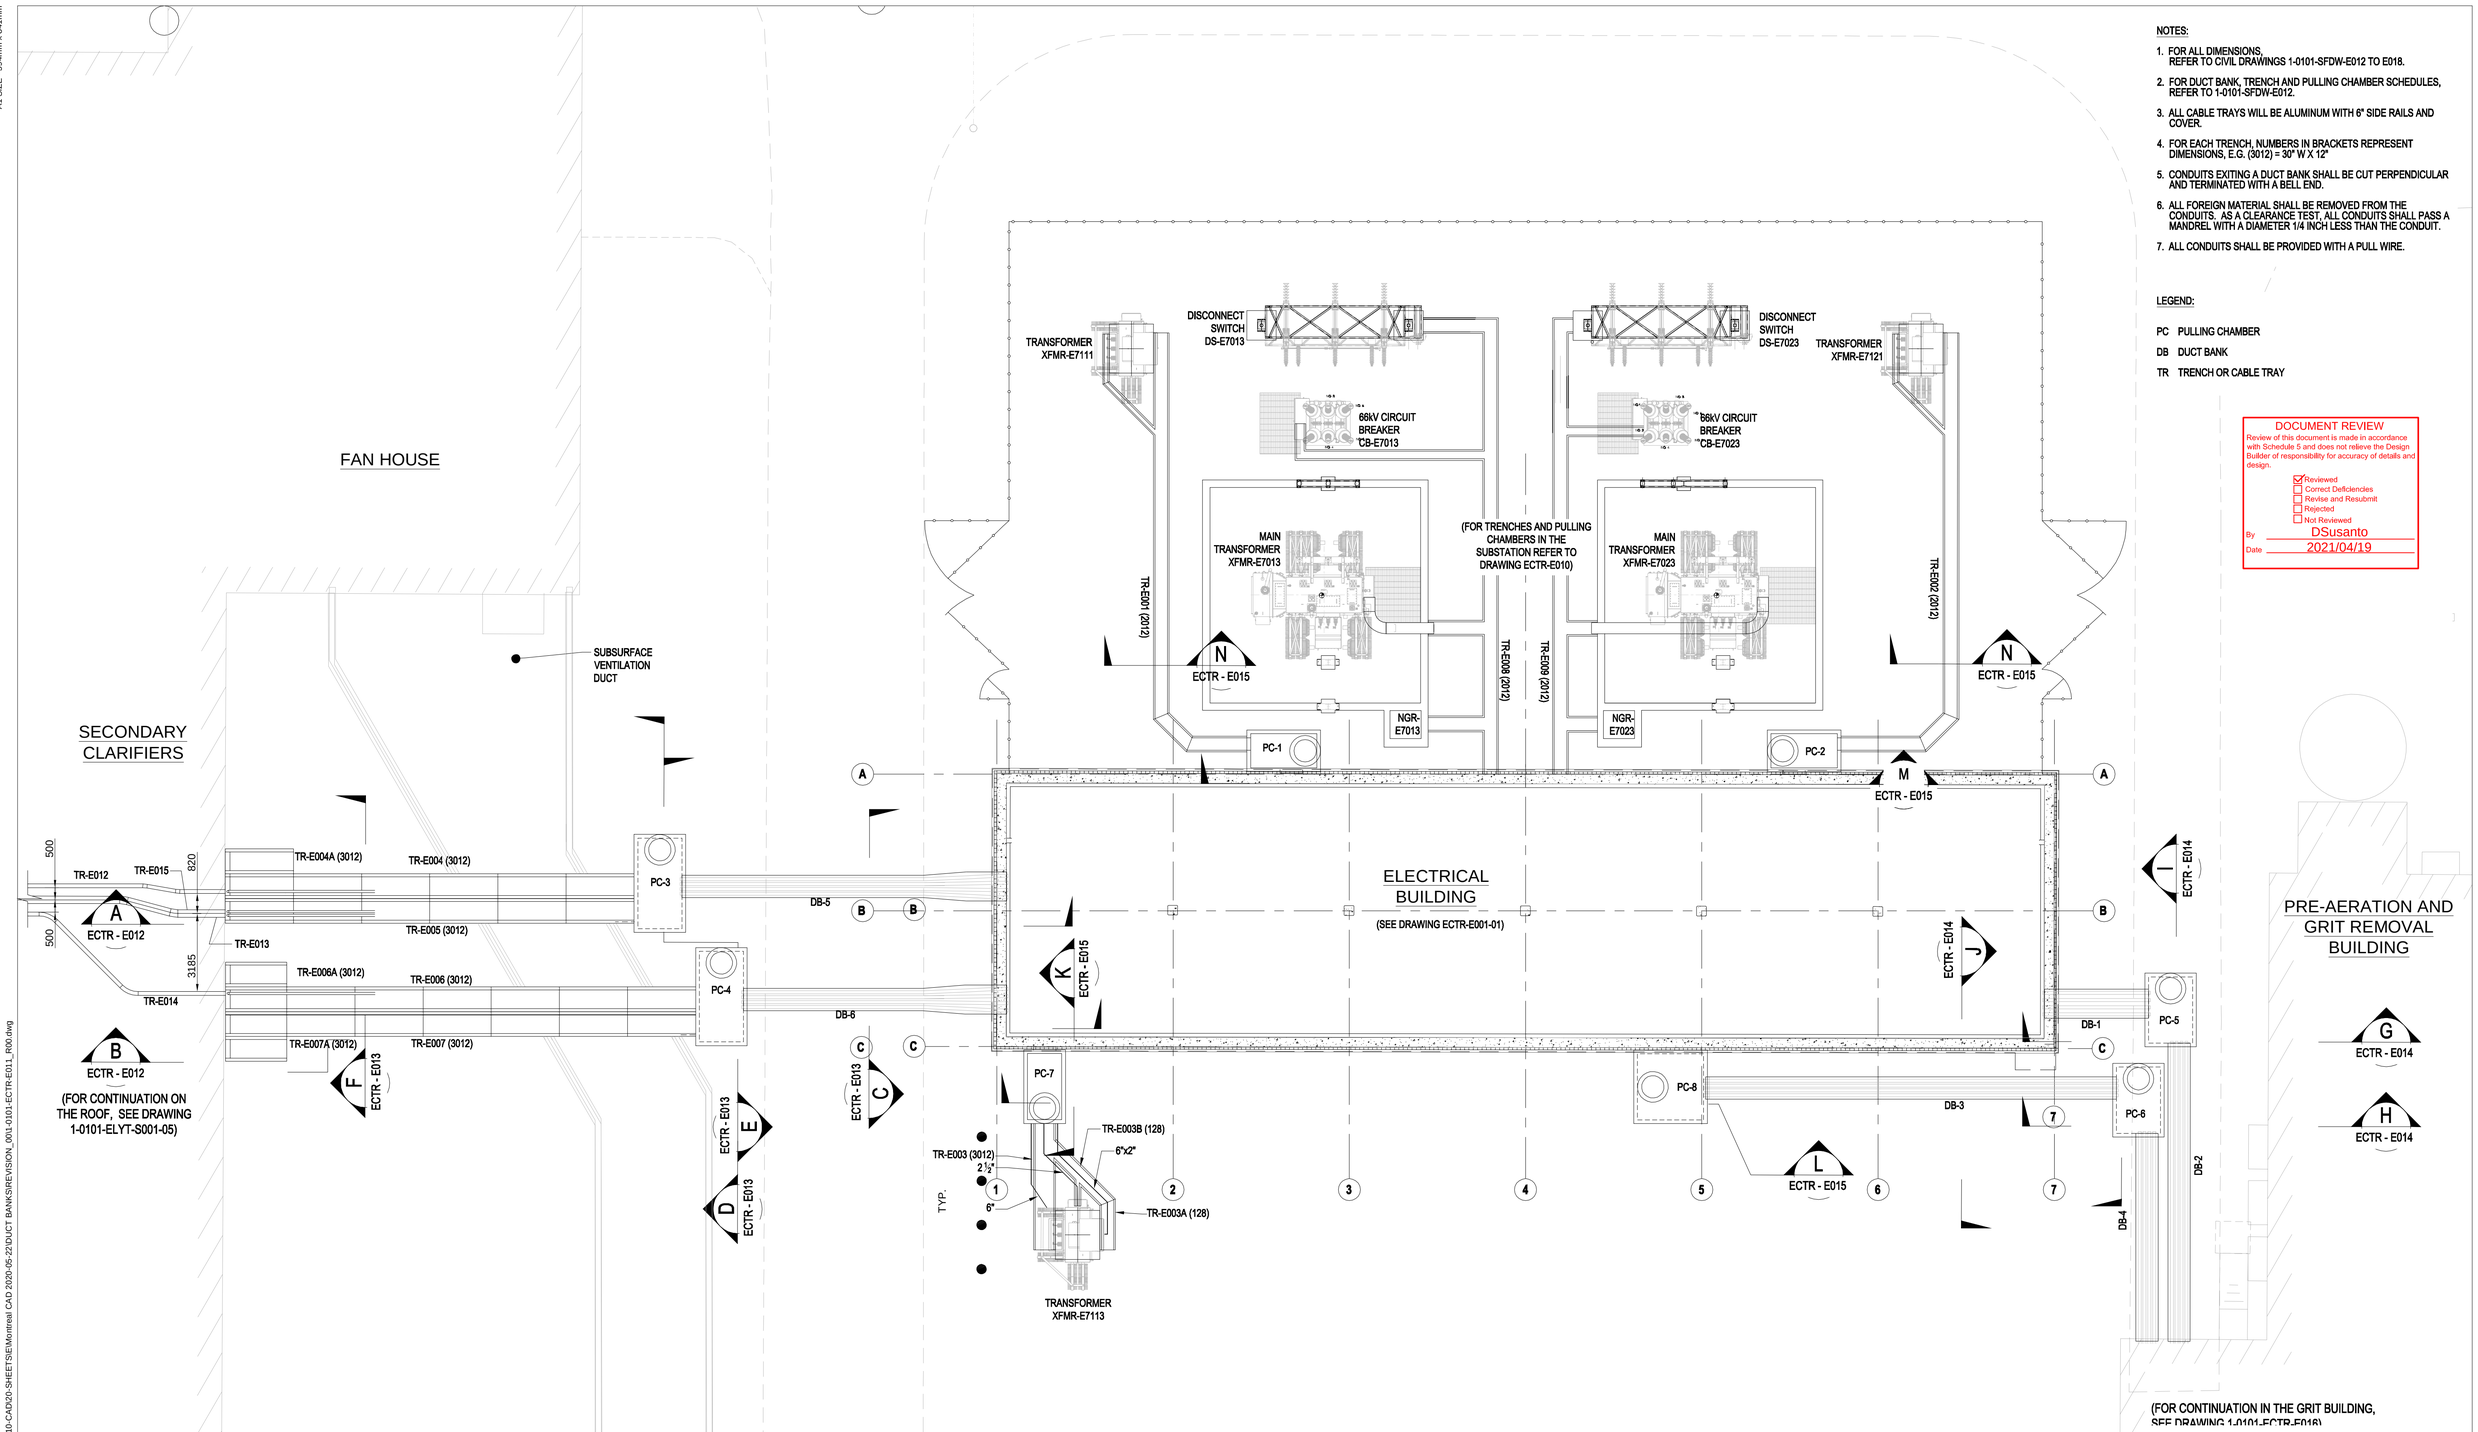

1 - GENERAL LAYOUT

1 : 125

NOTES:

1. FOR ALL DIMENSIONS, REFER TO CIVIL DRAWINGS 1-0101-SFDW-E012 TO E018.
2. FOR DUCT BANK, TRENCH AND PULLING CHAMBER SCHEDULES, REFER TO 1-0101-SFDW-E012.
3. ALL CABLE TRAYS WILL BE ALUMINUM WITH 6" SIDE RAILS AND COVER.
4. FOR EACH TRENCH, NUMBERS IN BRACKETS REPRESENT DIMENSIONS, E.G. (3012) = 30" W X 12"
5. CONDUITS EXITING A DUCT BANK SHALL BE CUT PERPENDICULAR AND TERMINATED WITH A BELL END.
6. ALL FOREIGN MATERIAL SHALL BE REMOVED FROM THE CONDUITS AS A CLEARANCE TEST, ALL CONDUITS SHALL PASS A MANDREL WITH A DIAMETER 1/4 INCH LESS THAN THE CONDUIT.
7. ALL CONDUITS SHALL BE PROVIDED WITH A PULL WIRE.

LEGEND:

PC PULLING CHAMBER

DB DUCT BANK

TR TRENCH OR CABLE TRAY

DOCUMENT REVIEW

Review of this document is made in accordance with Schedule 5 and does not relieve the Design Builder of responsibility for accuracy of details and design.

- [x] Reviewed
- [ ] Correct Deficiencies
- [ ] Revise and Resubmit
- [ ] Rejected
- [ ] Not Reviewed

By DSusanto

Date 2021/04/19

AS BUILT DRAWING

NOTICE:
AS-CONSTRUCTED DIMENSIONS, MEASUREMENTS AND OTHER DETAILS CONTAINED IN THIS AS-BUILT DRAWING HAVE BEEN OBTAINED BY AECOM CANADA LTD. ("AECOM") FROM VARIOUS SOURCES. SUCH INFORMATION REPRESENTS THE BEST INFORMATION AVAILABLE TO AECOM AT THE TIME OF PREPARATION OF THIS AS-BUILT DRAWING. AECOM DOES NOT IN ANY WAY REPRESENT OR WARRANT THAT SUCH INFORMATION IS ACCURATE AND ASSUMES NO RESPONSIBILITY FOR ANY ERRORS OR OMISSIONS CONTAINED THEREIN.

TN N

NO.	REVISIONS	DATE	DESIGN	CHECK
01	ISSUED FOR AS-BUILT DRAWING	2021-01-27		
00	ISSUED FOR CONSTRUCTION	2019-06-27		

AECOM

DESIGNED BY: L. FARNESI	CHECKED BY: J.P. DUFRESNE
DRAWN BY: S. MALTAIS	APPROVED BY: E. SCHRAML
SCALE: 1:125	RELEASED FOR CONSTRUCTION BY:
DATE: 2018-12-07	DATE:
CONSULTANT NO.:	

ENGINEER'S SEAL

REFERENCE DRAWING(S): 1-0101-ECTR-E010, ECTR-E001, SFDW-E012

Winnipeg

THE CITY OF WINNIPEG
WATER AND WASTE DEPARTMENT

NORTH END SEWAGE TREATMENT PLANT
NEWPCC POWER SUPPLY UPGRADE PROJECT

DUCT BANKS AND TRENCHES
GENERAL LAYOUT

CITY DRAWING NUMBER	SHEET	REV.	SIZE
1-0101-ECTR-E011		01	A1

LAST SAVE: 2021/02/13 3:32 PM

PATH: L:\Legacy\CAWPG1FP0001\Data\Projects\60576903900-CAD_GIS\910-CAD\20-SHEETS\EM\ontreal CAD 2020-05-22\DUCT BANKS\REVISION_001-0101-ECTR-E011_R00.dwg