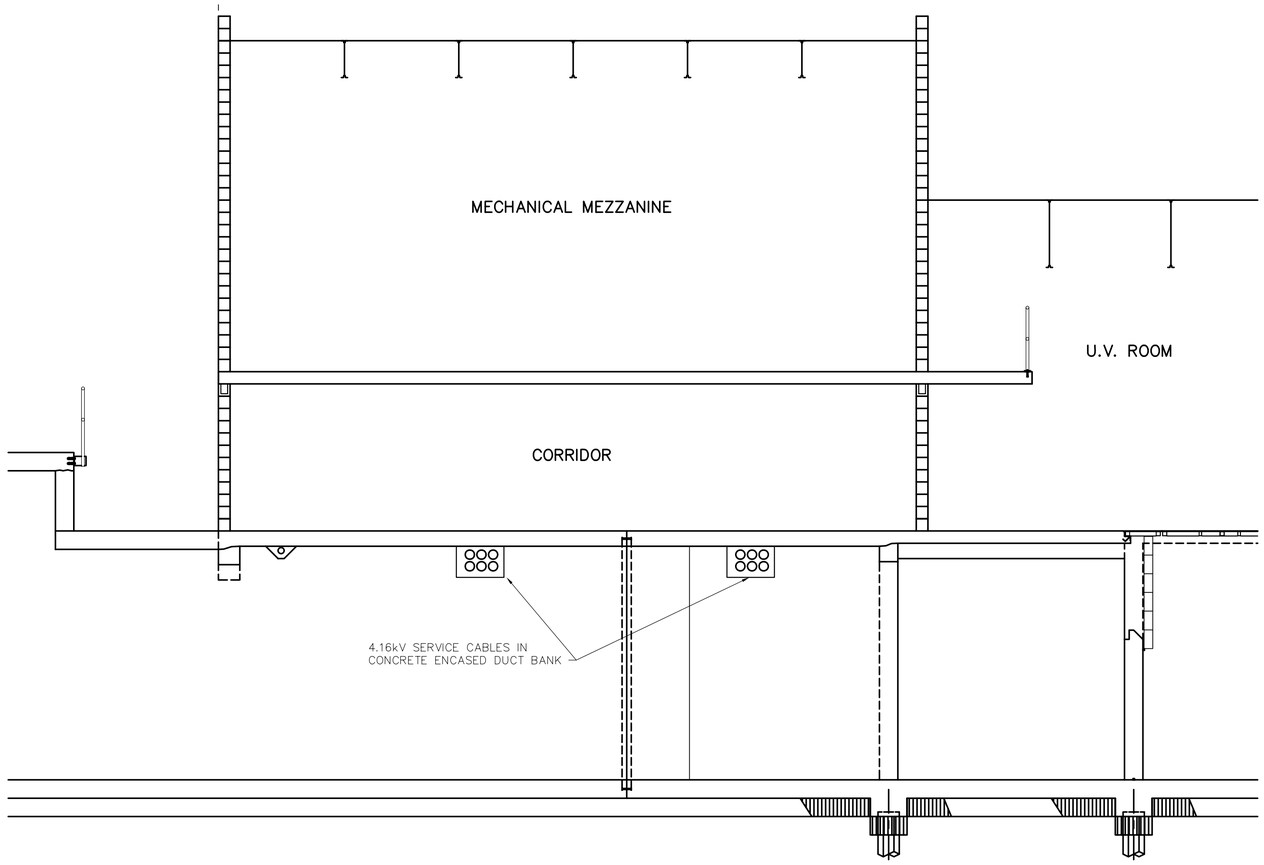


F / E1.02 SECTION
SCALE 1:50

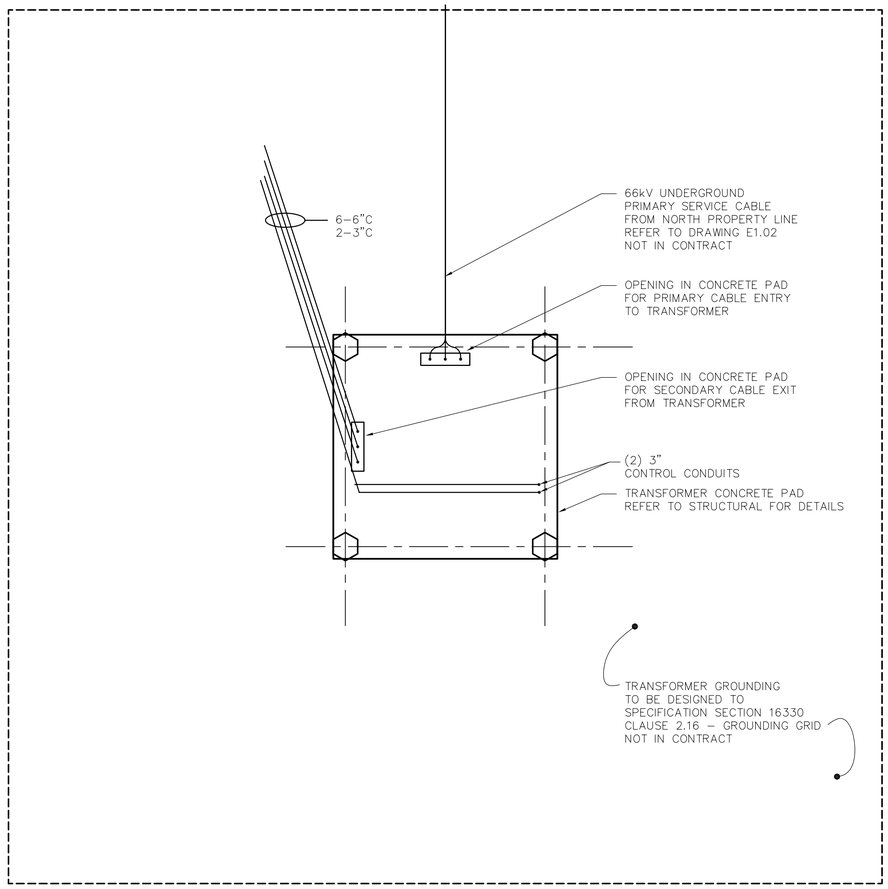


H / E1.01 5MVA PAD MOUNTED TRANSFORMER
SCALE 1:50

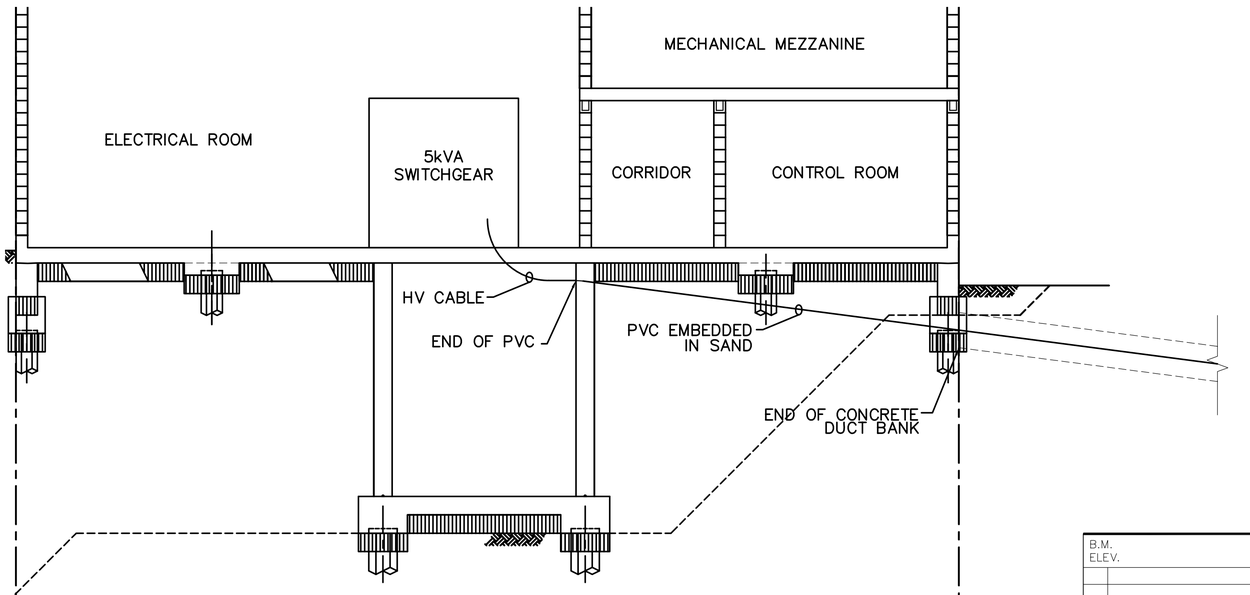


G / E1.02 SECTION
SCALE 1:50

AS BUILT PER
COMSTOCK
CANADA
August 15 2007

APEGM
Certificate of Authorization
AECOM Canada Ltd.
Original dated on:
No. 4671 Date: 2005/02/18

AECOM
As of January 3, 2009, EarthTech became AECOM Canada Ltd.

AECOM AS-CONSTRUCTED
SIG..... DATE.....

| NO. | REVISIONS | DATE | BY |
|---|---|---|---|
| 2 | AS-CONSTRUCTED DRAWING | 07/08/02 | CDS |
| 1 | ISSUED FOR CONSTRUCTION | 05/06/08 | GLG |
| 0 | ISSUED FOR TENDER | 05/02/18 | JEH |

B.M.
ELEV.

EARTH TECH
Earth Tech (Canada) Inc. Winnipeg, Manitoba 204.477.5381

| | | | |
|---|---|---|---|
| DESIGNED BY | GSN | CHECKED BY | PS |
| DRAWN BY | CPG | APPROVED BY | DT |
| HOR. SCALE: | AS NOTED | RELEASED FOR CONSTRUCTION BY: | T. KJARTANSON |
| VERTICAL SCALE: | AS NOTED | | |
| DATE | 2005/01/20 | DATE | 2005-02-18 |

ENGINEER'S SEAL
ORIGINAL SIGNED BY
P. STRYK
FEB. 18/05

CONSULTANT DRAWING NO.
66303D-CE1.09

Winnipeg THE CITY OF WINNIPEG
WATER AND WASTE DEPARTMENT

NEWPCC - SECONDARY EFFLUENT
UV DISINFECTION FACILITY

ELECTRICAL
SITE SECTIONS & DETAILS
SHEET 3 OF 3

CITY FILE NUMBER
SHEET 9 OF 15
CITY DRAWING NUMBER
1-0101U-E0008-003-02

SHEET: CoW-A1-WWD (11/2002)
Jul 28, 2009 - 11:40am PLOTTED BY: reg.hall LAYOUT: Layout1 FILE: L:\work\66000\663030is\02a-CAD\ALL\SUBMISSION\As Built-Record\As-Constructed DWG\1-0101U-E0008-003-02D.dwg