




1 PARTIAL EAST BARRIER FRONT ELEVATION
1:75

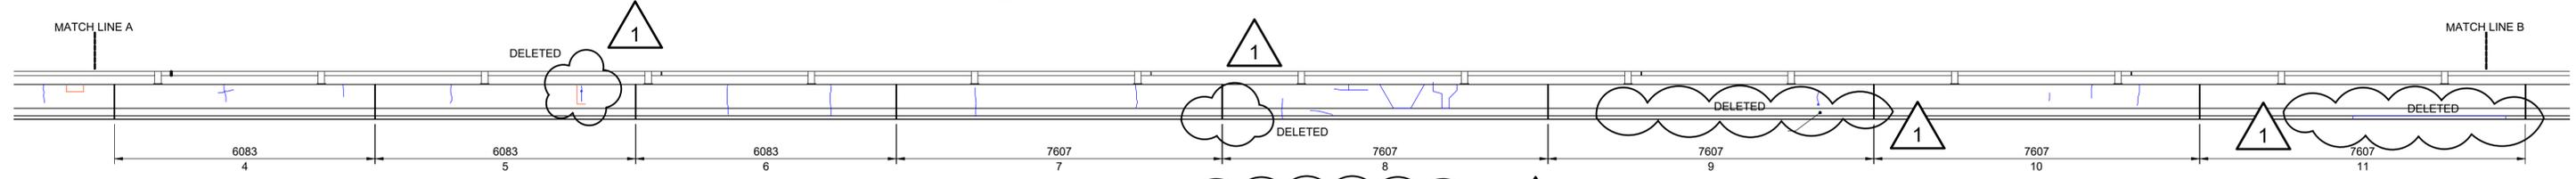


2 PARTIAL EAST BARRIER FRONT ELEVATION
1:75

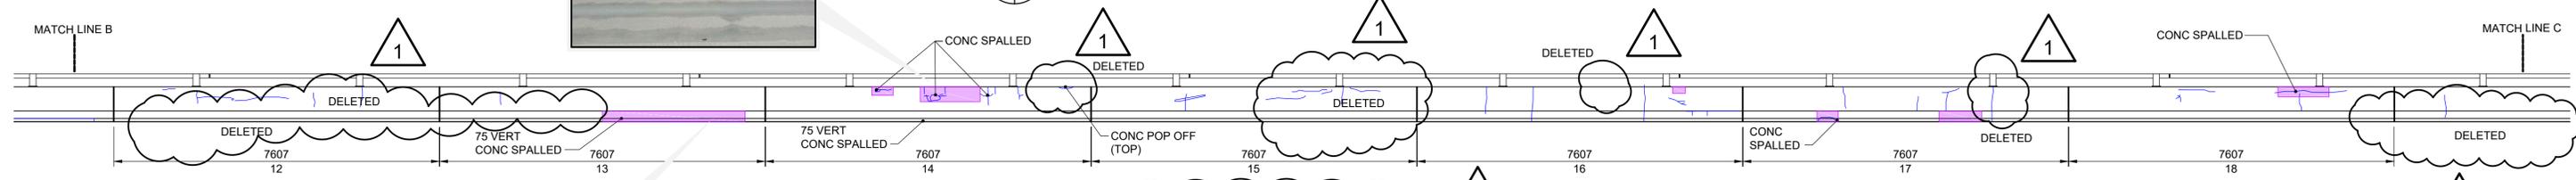

3 PARTIAL EAST BARRIER FRONT ELEVATION
1:75

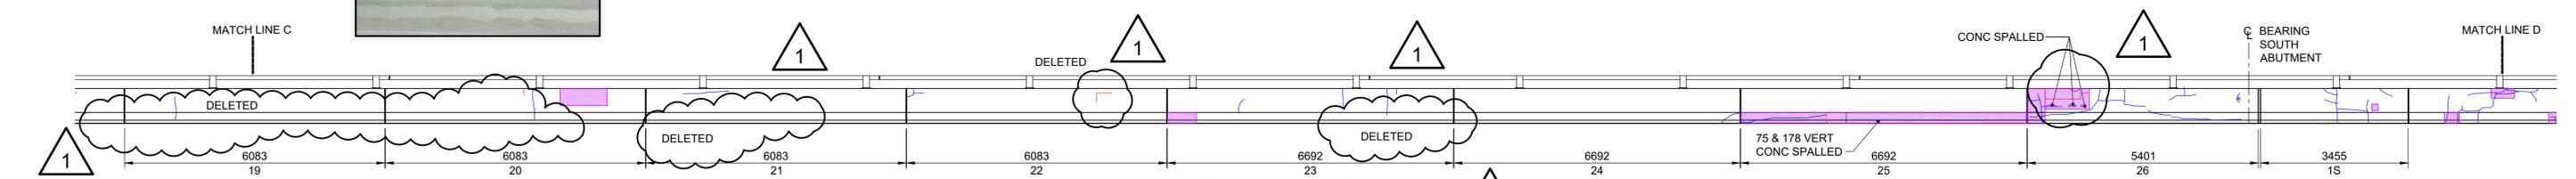

4 PARTIAL EAST BARRIER FRONT ELEVATION
1:75

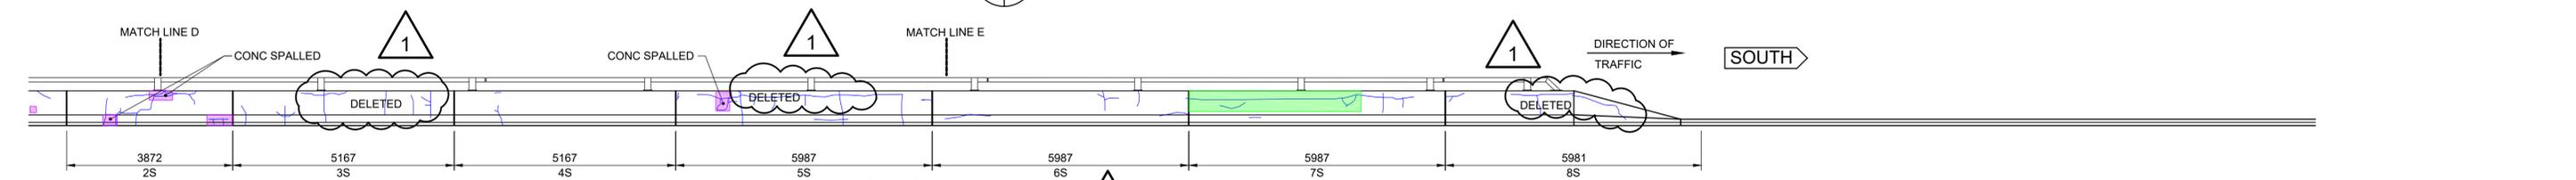

5 PARTIAL EAST BARRIER FRONT ELEVATION
1:75

LEGEND

- CRACK
- TYPE 1A OR 1B BARRIER REPAIR
- TYPE 2A BARRIER REPAIR
- TYPE 2B BARRIER REPAIR

NOTES:

1. THIS DRAWING DEPICTS SELECT FINDINGS OF TETRA TECH 2022 BRIDGE DECK INVESTIGATION. ACTUAL REPAIR AREAS MAY BE DIFFERENT AND WILL BE IDENTIFIED ON SITE BY THE CONTRACT ADMINISTRATOR.
2. ONLY CRACKS IN AREAS OF SUGGESTED REPAIR ARE SHOWN TO HELP LOCATE AREAS OF WORK. LOCATIONS OF DEFECTS AND CRACKS SHOWN ARE APPROXIMATE. CRACK WIDTH VARIES.
3. FOR TYPICAL BARRIER TYPE 1A, TYPE 1B, TYPE 2A AND TYPE 2B REPAIR DETAILS, REFER TO SHEET 7.
4. ASSUMED REPAIR AREAS ARE PROVIDED IN TABLE 1 FOR BIDDING PURPOSES.

TABLE 1: REPAIR QUANTITIES

LOCATION	APPROX REPAIR UNITS
TYPE 1A OR 1B	7.5 m ²
TYPE 2A	0.000 m
TYPE 2B	4.2 m



NO.	REVISIONS	DATE	BY
1	ISSUED FOR ADDENDUM 4	23.04.21	R.L.
0	ISSUED FOR TENDER	23.03.07	E.F.S.

TETRA TECH

DESIGNED BY: R.L. CHECKED BY: E.F.S.
 DRAWN BY: E.V. APPROVED BY: E.F.S.

HOR. SCALE: AS NOTED ACCEPTED BY: DATE: 23.03.07
 VERTICAL: AS NOTED ORIGINAL SIGNED: DATE: 23.03.07

DATE: 22.12.06

ORIGINAL DRAWING REVISION "00" SEALED BY E.F.G. SHEHATA 23.03.07

CONSULTANT DRAWING NO. 734-2200070500-DWG-S2108

THE CITY OF WINNIPEG
 PUBLIC WORKS DEPARTMENT
 ENGINEERING DIVISION

MINOR REHABILITATION OF ST JAMES BRIDGES SOUTHBOUND BRIDGE

EAST BARRIER FRONT ELEVATION

CITY DRAWING NUMBER: B101-22-008
 SHEET 6 OF 9

6