

ALL DRAWINGS, SPECIFICATIONS AND RELATED DOCUMENTS ARE PROPERTY OF THE ARCHITECT. REPRODUCTION OF DRAWINGS, SPECIFICATIONS AND RELATED DOCUMENTS IN ANY FORM IS STRICTLY FORBIDDEN WITHOUT THE WRITTEN PERMISSION OF THE ARCHITECT.

CLIENT:
MARKET LANDS INC.

PROJECT:
MARKET LANDS MIXED USE BUILDING
WINNIPEG, MANITOBA

ARCHITECT:
DAOUST LESTAGE
2375 St. Laurent Blvd #710, Montreal QC, H2T 2J7
4382.0000@daoustlestage.com
+1 514 982 0877
NUMBER TEN ARCHITECTURAL GROUP
310 - 115 Bonnyvale Ave. Winnipeg, MB, R2B 9R3
wsp@number10.com
+1 204-942-0781

ELECTRICAL CONSULTANT:
TETRA TECH
2475 East Foothill Blvd, Pasadena CA, 91107-6024
info@tetratech.com
+1 626 351 4664


STRUCTURAL CONSULTANT:
ENTUITIVE
200 University Ave, 7th Floor, Toronto ON, M5H 1C6
entuitive.com
+1 416 477 5832

CIVIL CONSULTANT:
WSP CANADA INC.
1600 Buffalo Place, Winnipeg, Manitoba, R2T 6R6
info@wsp.com
+1 204 259 1659

SEAL:
PROVINCE OF MANITOBA
RENÉE DAOUST
REGISTERED ARCHITECT

NO.	DESCRIPTION	DATE
1	ISSUED FOR ADDENDA 1	2024-03-20
0	ISSUED FOR TENDER	2024-02-02
A	ISSUED FOR INFORMATION	2023-11-22

NO.	DESCRIPTION	DATE
1	ISSUED FOR ADDENDA 1	2024-03-20
0	ISSUED FOR TENDER	2024-02-02
A	ISSUED FOR INFORMATION	2023-11-22

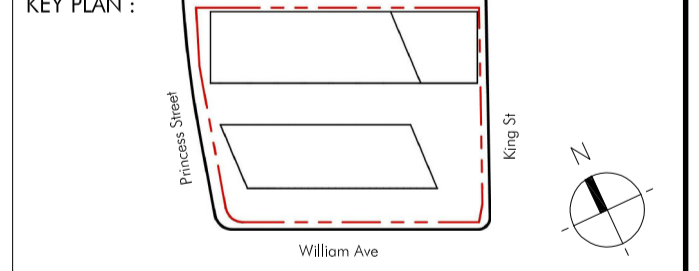


DISCIPLINE: **LANDSCAPE**


LOT: **SITE DEVELOPMENT**

TITLE: **GENERIC DETAILS**


DRAWN BY:	G.F.	FILE:	694-19
DEVELOPED BY:	R.S.	SCALE:	INDICATED
APPROVED BY:	R.D.	PAGE:	L-1501
PRINT DATE:	2024-02-02		

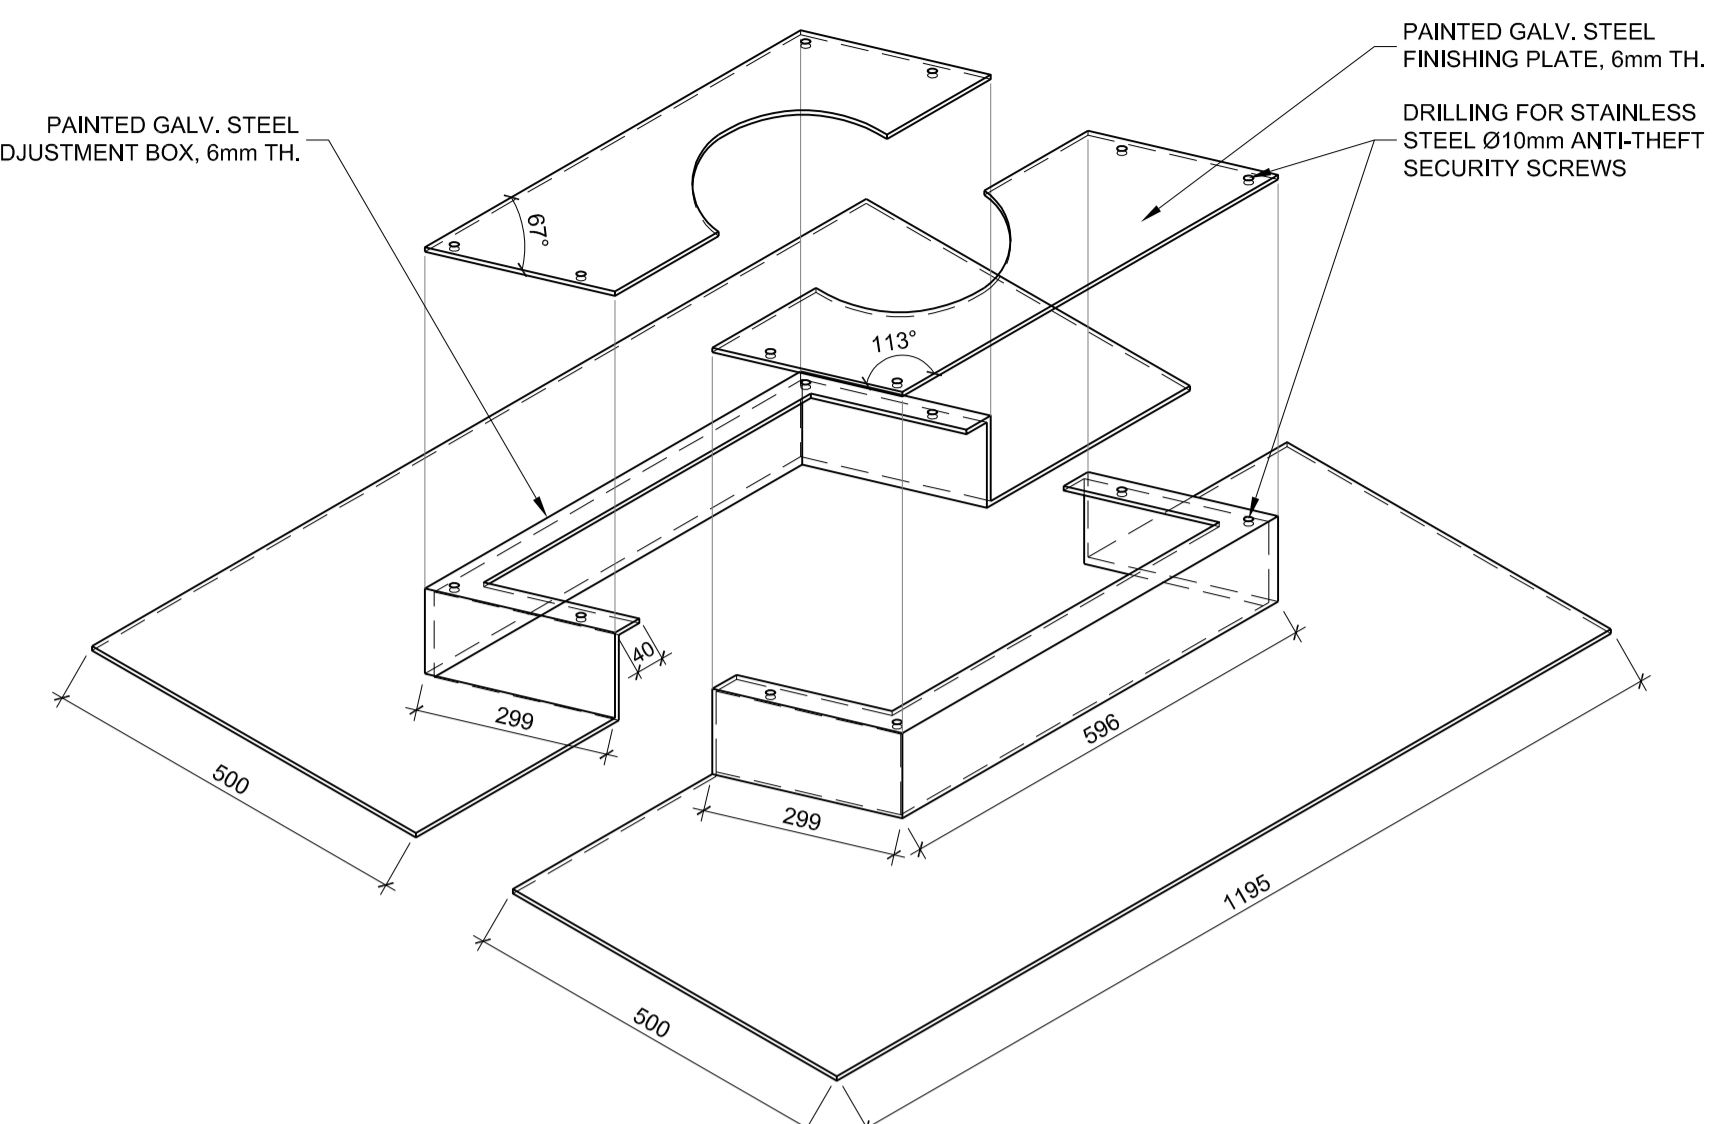


3 FINISHING PLATE
AXONOMETRY
1:10

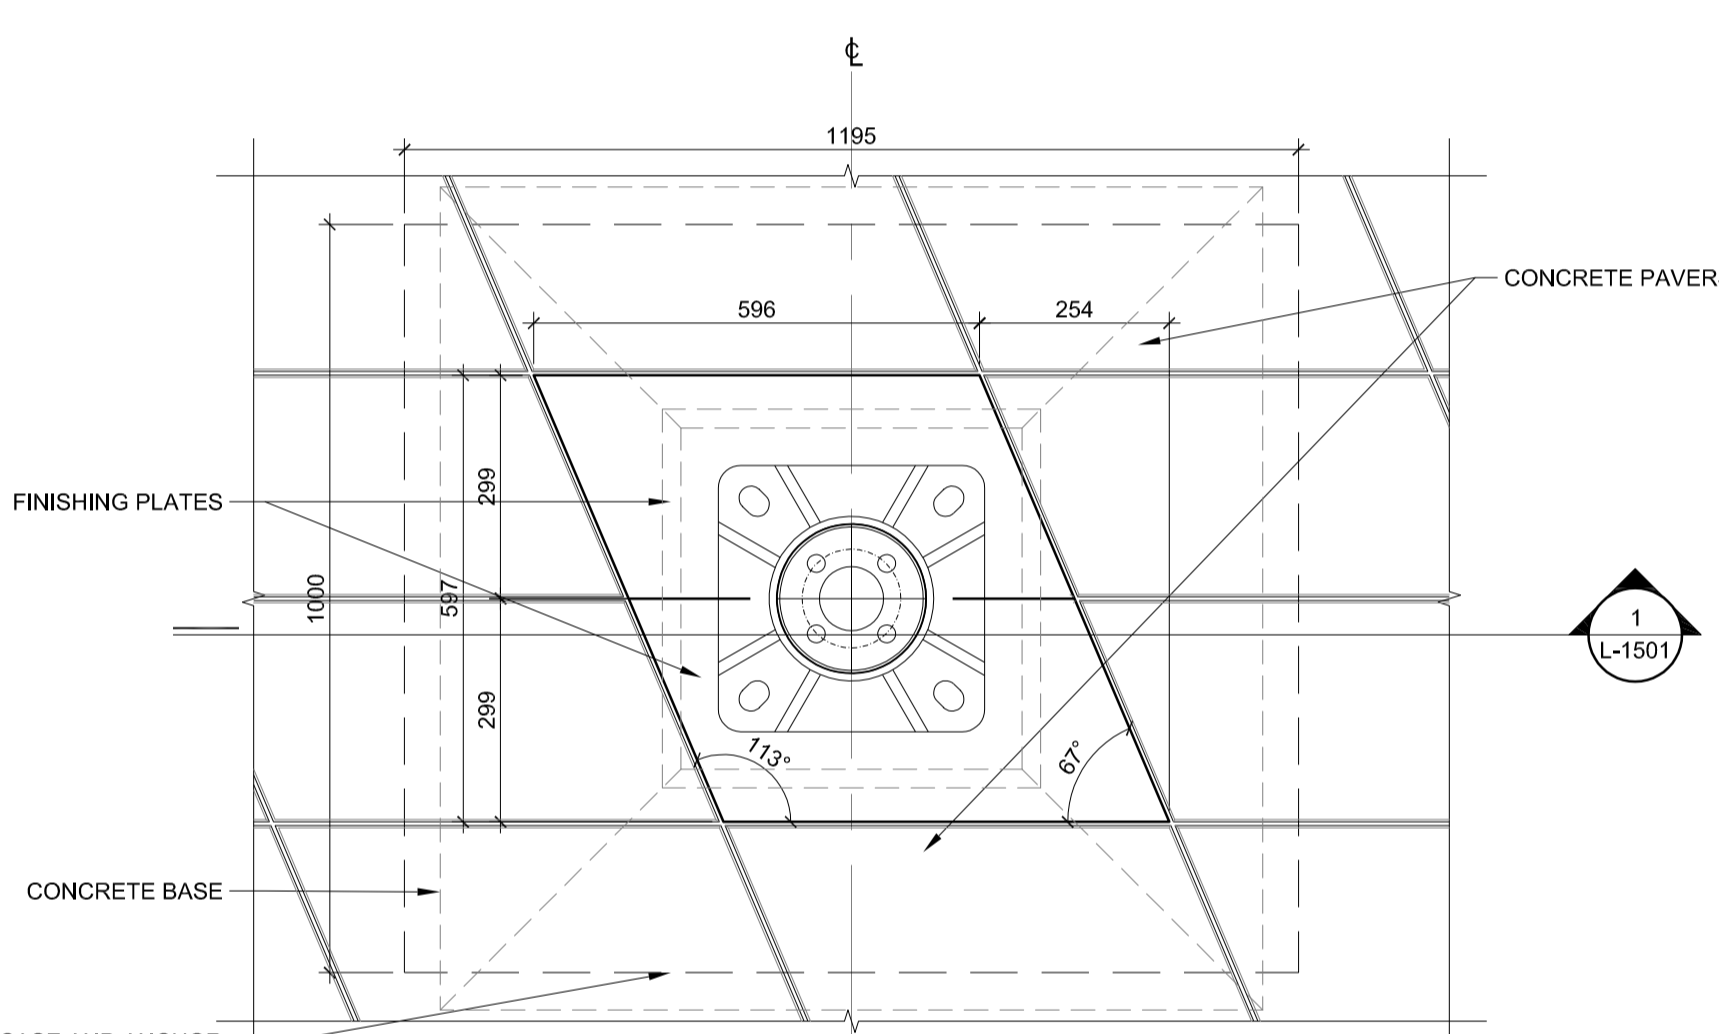


2 ANCHOR AND CONCRETE BASE FOR LIGHTING AT CONCRETE PAVERS
PLAN
1:10

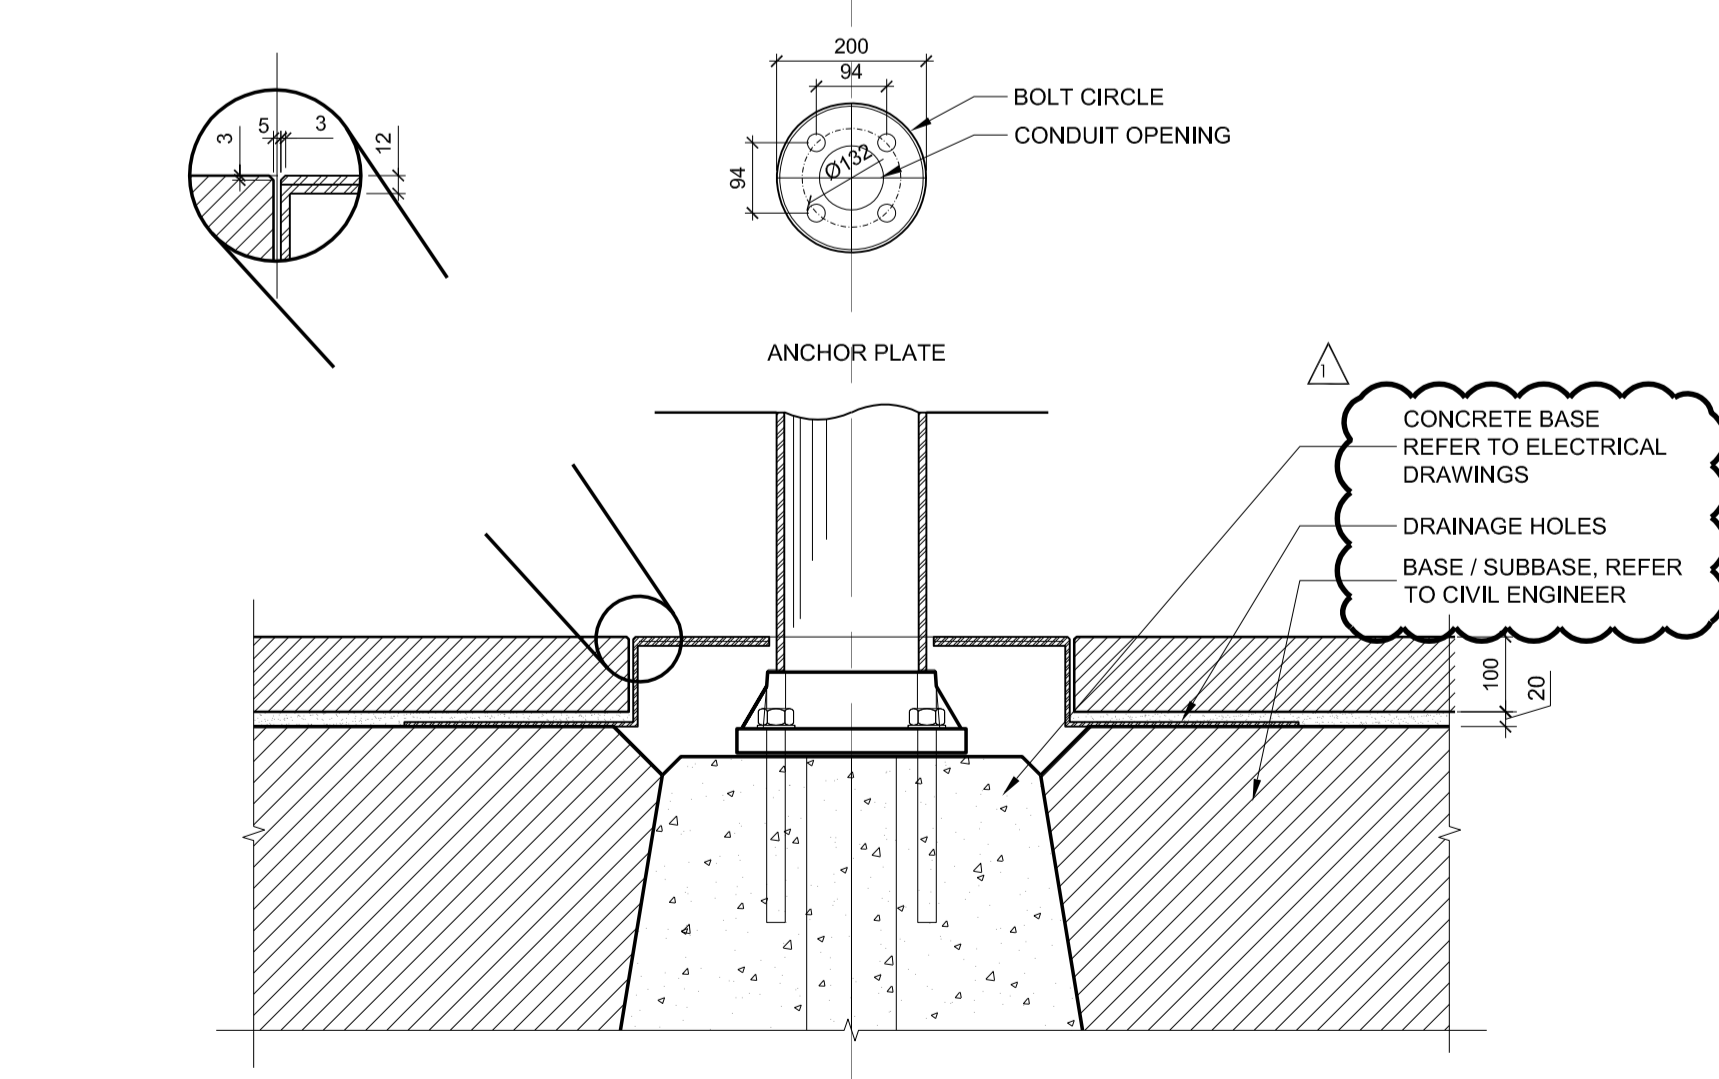


1 ANCHOR AND CONCRETE BASE FOR LIGHTING AT CONCRETE PAVERS
SECTION
1:10

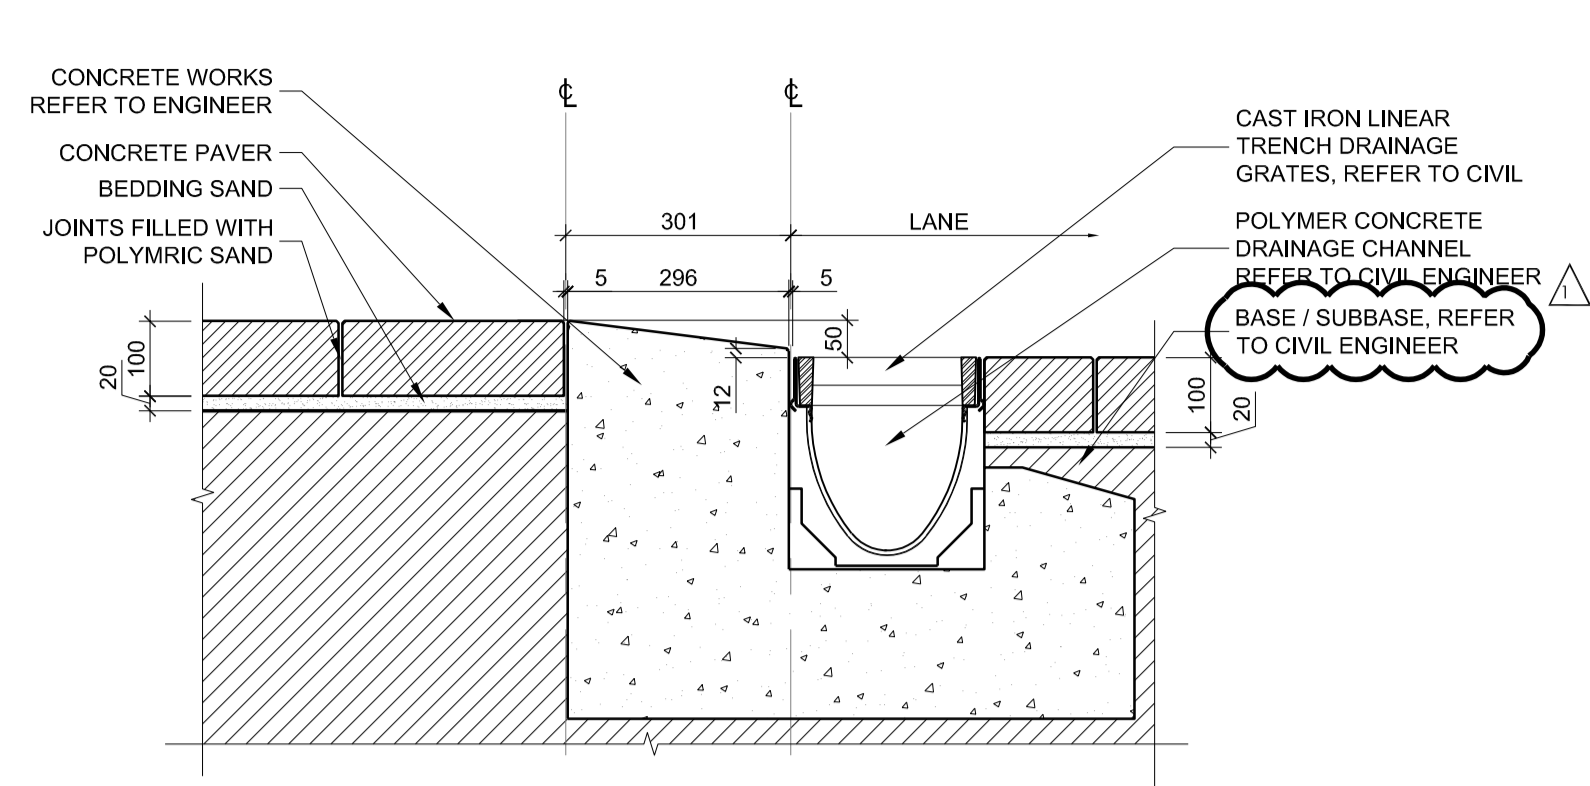


7 CONCRETE PAVER CURB DETAIL WITH LINEAR DRAIN - NORTH LANE
SECTION
1:10

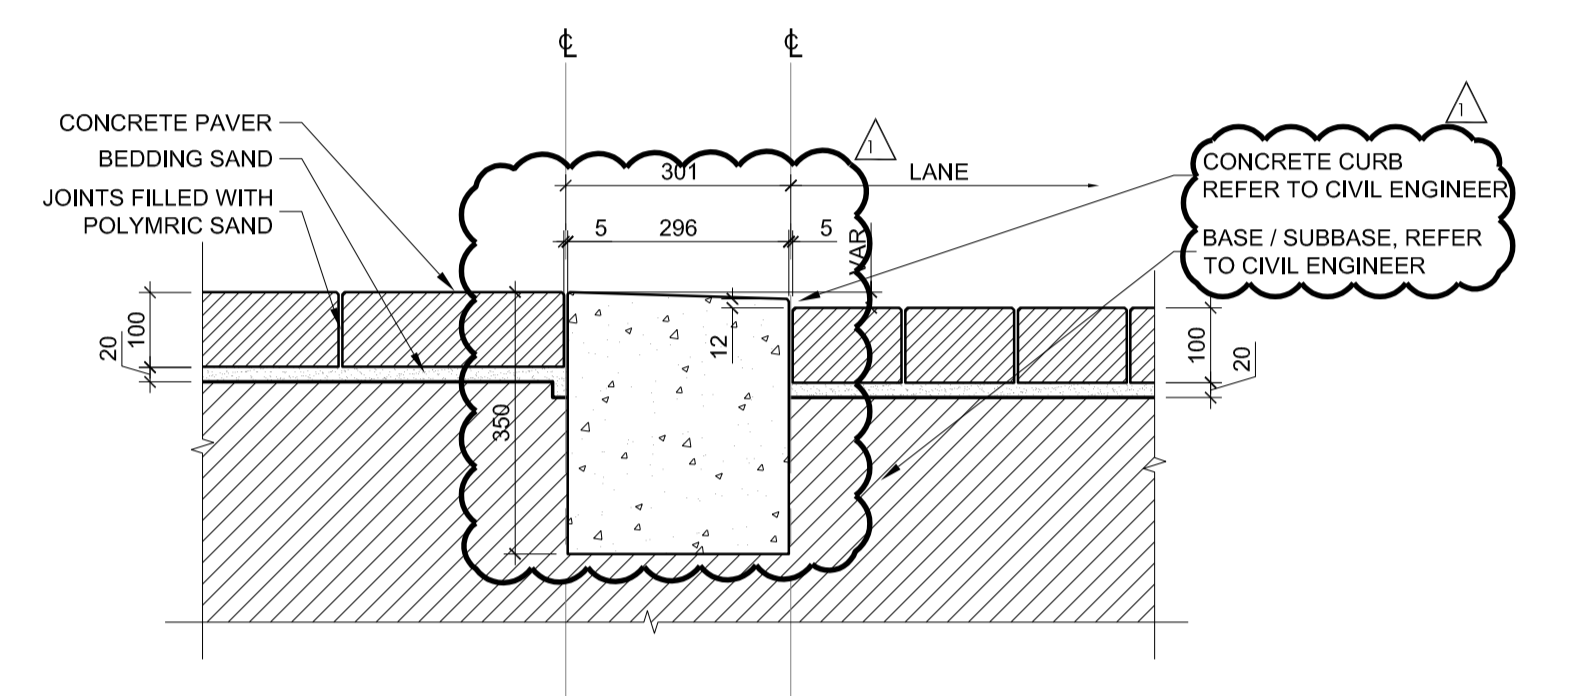


6 CONCRETE PAVER CURB DETAIL TRANSITION TO STREET - NORTH LANE
SECTION
1:10

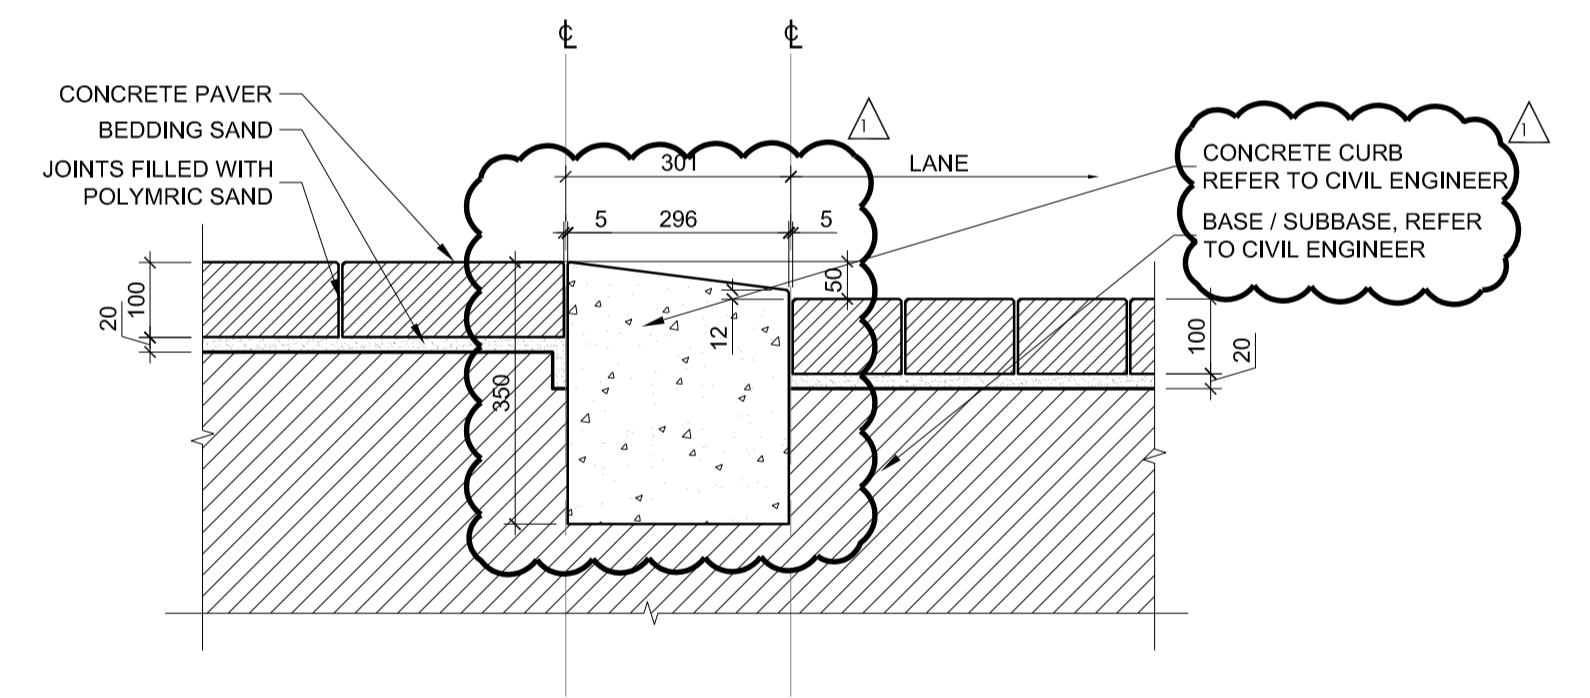


5 CONCRETE PAVER TYPICAL CURB DETAIL - NORTH LANE
SECTION
1:10

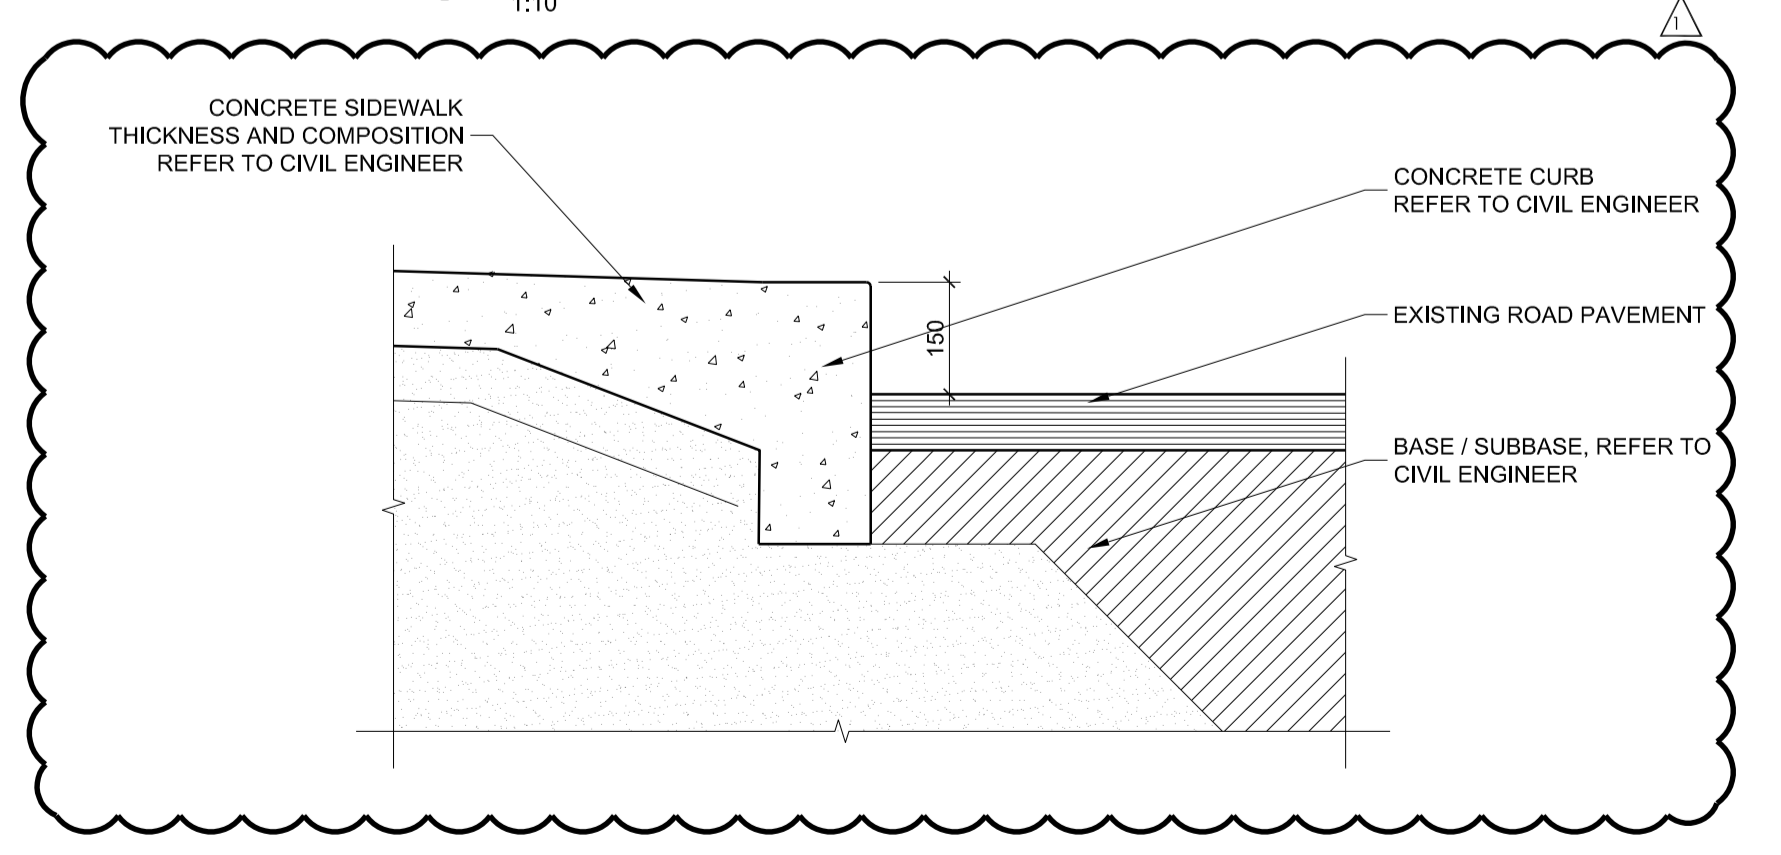


4 CONCRETE PAVER CURB DETAIL - STREET
SECTION
1:10

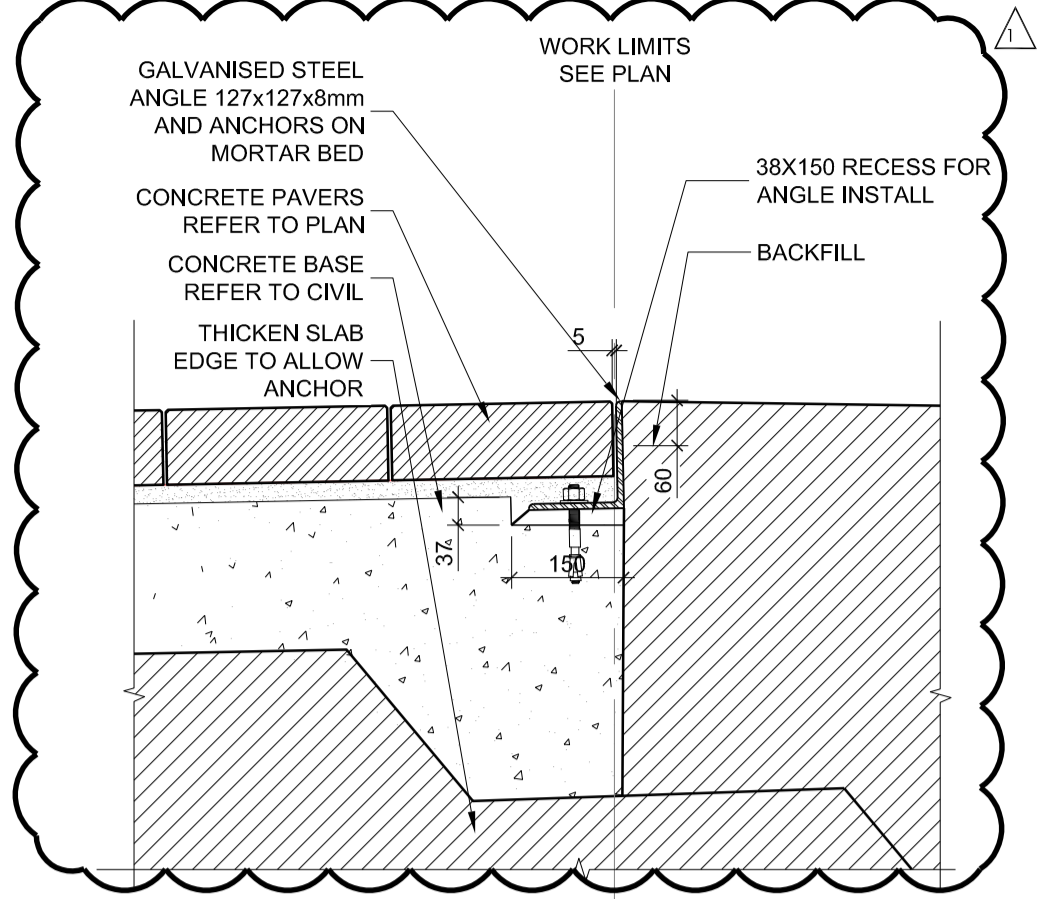

10 JUNCTION PLANTING AND CONCRETE PAVER
SECTION
1:10

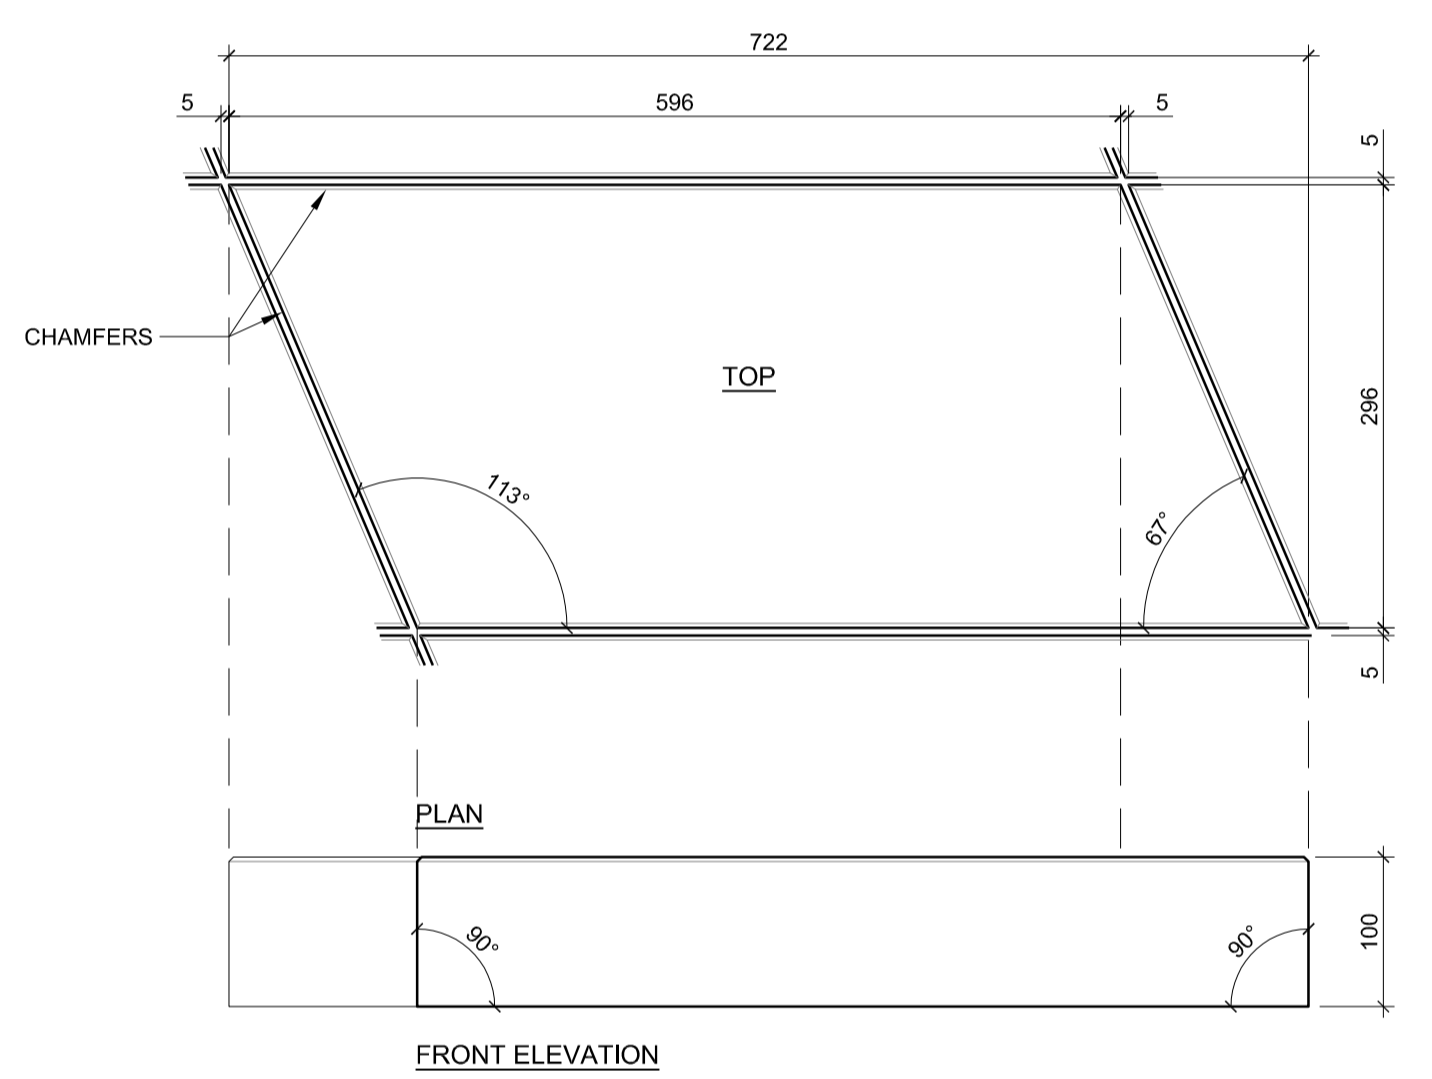

9 CUSTOM CONCRETE PAVER - TYPE A - PEDESTRIAN
PLAN AND ELEVATION
1:5

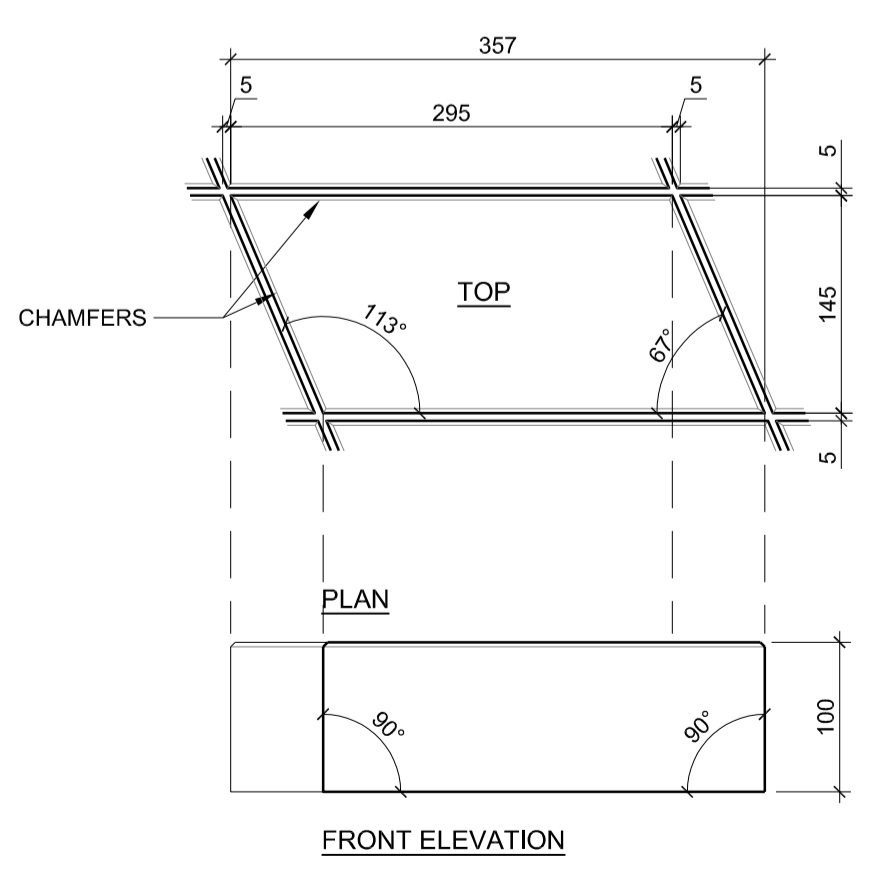

8 CUSTOM CONCRETE PAVER - TYPE B - VEHICLE TRAFFIC
PLAN AND ELEVATION
1:5