

ALL DRAWINGS, SPECIFICATIONS AND RELATED DOCUMENTS ARE PROPERTY OF THE ARCHITECT. REPRODUCTION OF DRAWINGS, SPECIFICATIONS AND RELATED DOCUMENTS IN ANY FORM IS STRICTLY FORBIDDEN WITHOUT THE WRITTEN PERMISSION OF THE ARCHITECT.

CLIENT:
MARKET LANDS INC.

PROJECT:
MARKET LANDS
MIXED USE BUILDING
WINNIPEG, MANITOBA

ARCHITECT:
DAoust LESTAGE
2375 St. Laurent Blvd #710, Montreal QC, H2Z 2T7
info@daoustlestage.com
+1 514 982 0877
NUMBER TEN ARCHITECTURAL GROUP
310 - 115 Bannockburn Ave, Winnipeg, MB, R2B 9R3
wsp@numberten.com
+1 204-942-0981


ELECTRICAL CONSULTANT:
TETRA TECH
2475 East Foothill Blvd, Pasadena CA, 91107-6024
info@tetratech.com
+1 626 351 4664

STRUCTURAL CONSULTANT:
ENTUITIVE ENTUITIVE
200 University Ave, 7th Floor, Toronto ON, M5H 3C9
entuitive.com
+1 416 477 5832

CIVIL CONSULTANT:
WSP WSP CANADA INC.
1600 Buffalo Place, Winnipeg, Manitoba, R2T 6R6
info@wsp.com
+1 204 259 1659




NO.	DESCRIPTION	DATE
1	ISSUED FOR ADDENDA 1	2024-03-20
0	ISSUED FOR TENDER	2024-02-02
A	ISSUED FOR INFORMATION	2023-11-22

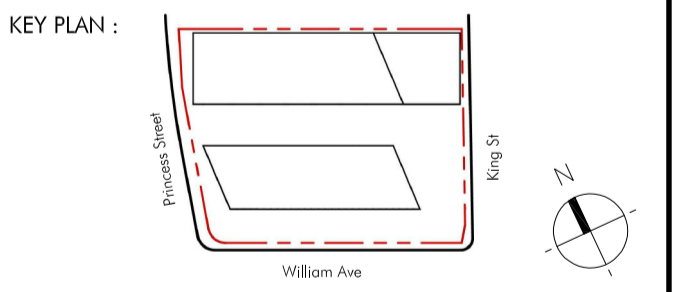


DISCIPLINE: LANDSCAPE
LOT: SITE DEVELOPMENT
TITLE: SECTIONS


DRAWN BY: G.F./D.G. FILE: 694-19
DEVELOPED BY: R.S. SCALE: 1:20
APPROVED BY: R.D. PAGE: L-1504
PRINT DATE: 2024-02-02

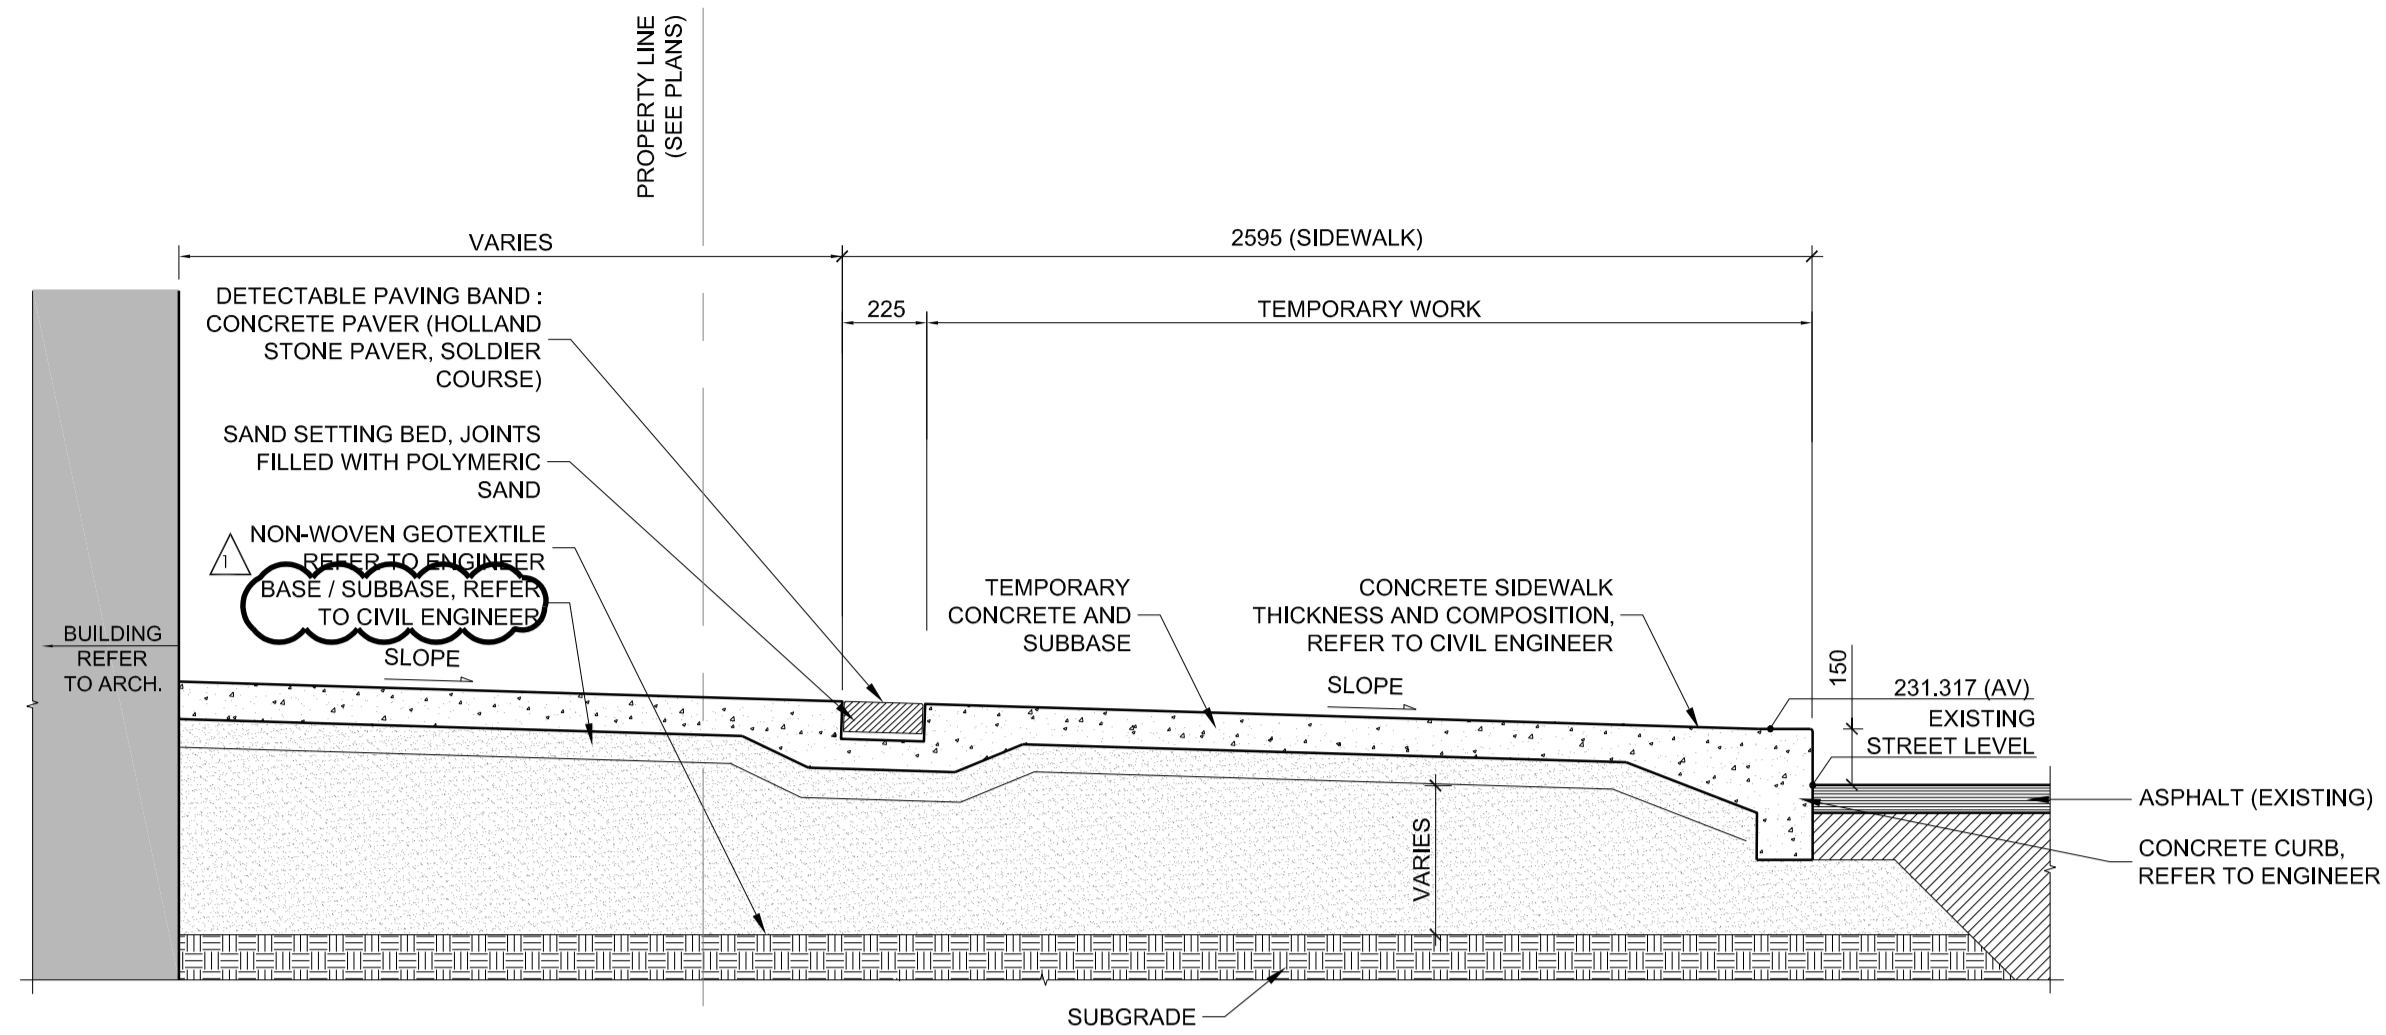

1A CROSS SECTION - SIDEWALK (TEMPORARY)
1:20

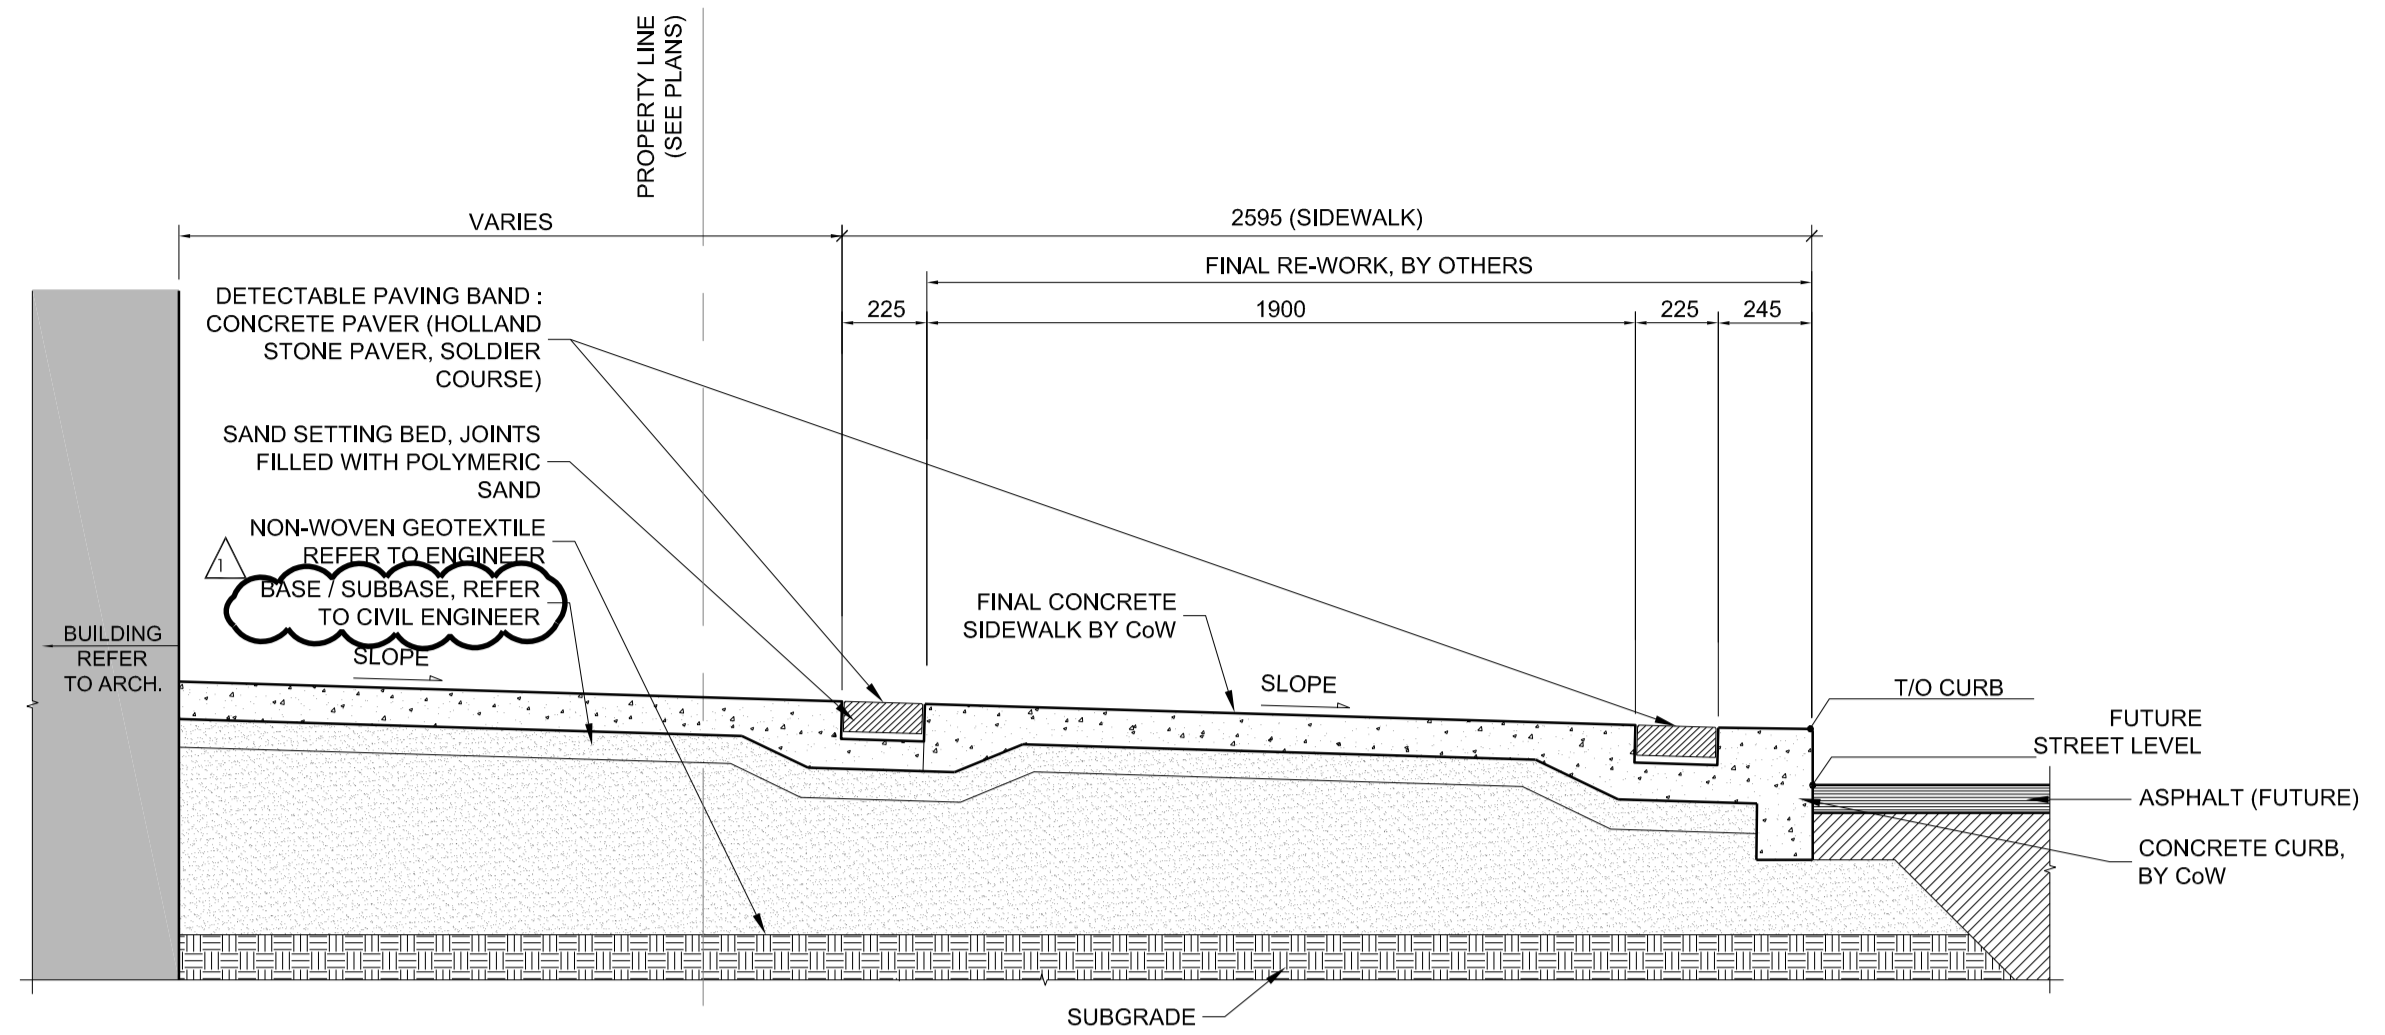

1B CROSS SECTION - SIDEWALK (FINAL CONDITION, BY OTHERS)
1:20

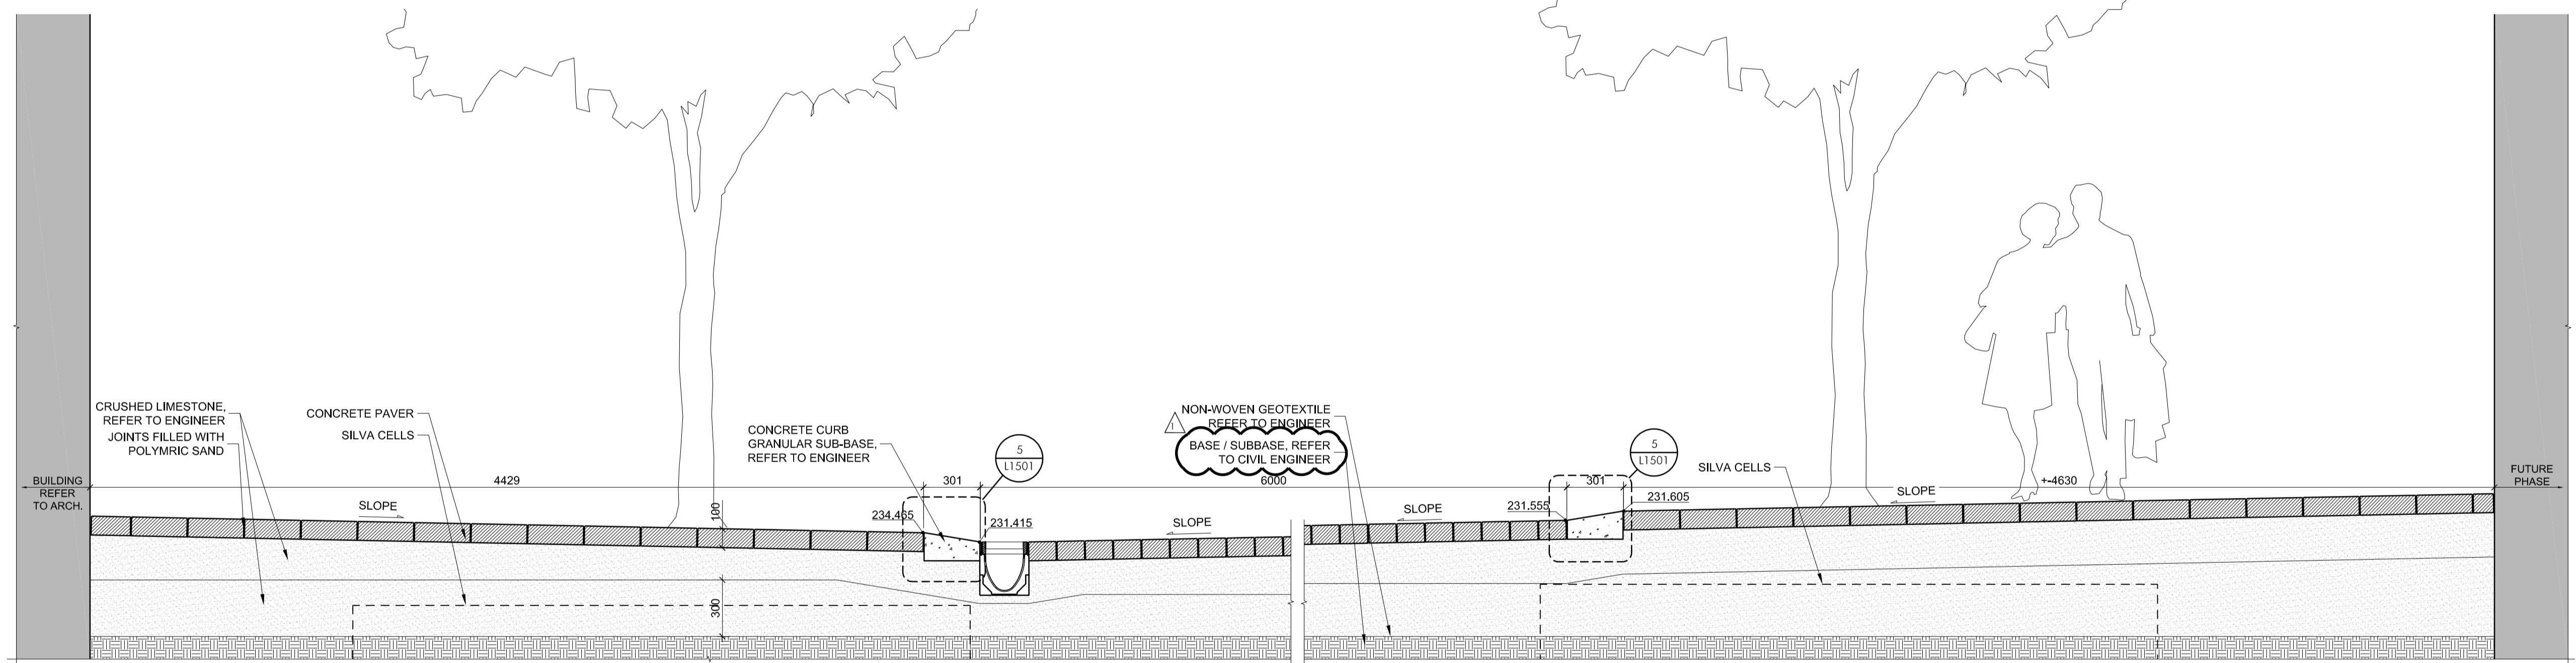

2 CROSS SECTION - NORTH LANE
1:20